

ADDENDUM NUMBER ONE (1)

Issuance Date: October 16, 2025

Memo to: All plan holders on record

Issued by: Ashe Broussard Weinzettle Architects LLP

Project Name: Workforce Capacity and Medical Access Project
LaSalle General Hospital
Jena, Louisiana
EDA Number 08-79-05595
Architect Project Number 2024.01

Acknowledge receipt of this Addendum in the space provided in the Bid Form. Failure to do so may subject the bidder to disqualification.

General Contractors are reminded that Bids are due at 1:00 pm, Central, Thursday, October 30, 2025.

This addendum forms a part of the contract documents and modifies the original bidding documents dated February 7, 2025, with amendments and additions noted as follows:

GENERAL CLARIFICATIONS

1. All work associated with the construction of the First Floor Physician's Wing has been separated into Additive Alternate #1. All work associated with the Second Floor Addition and Renovations remains in the Base Bid.

REQUEST FOR INFORMATION RESPONSES:

1. What are the liquidated damages for this job?
RESPONSE: Liquidated damages are set at \$500.00/day.
2. Is this project subject to requirements of the Davis-Bacon Act?
RESPONSE: Yes, the project must meet wage requirements set forth by the Davis-Bacon Act. Refer to EDA Appendices in Project Manual for required federal contracting provisions.
3. Does the project have a Disadvantaged Business Enterprise (DBE) goal?
RESPONSE: A DBE goal is not mandated.
4. Is the project required to comply with the Build America, Buy America Act (BABA)?
RESPONSE: Yes, the project must meet the domestic sourcing requirements for iron and steel set forth by the Build America, Buy America Act (BABA).
5. Is the project required to comply with the American Iron and Steel (AIS) provision of the Consolidated Appropriations Act of 2014?
RESPONSE: No, the project isn't required to comply with the AIS provision.
6. Is a Unique Entity Identifier (UEI) number required?
RESPONSE: Yes, the Contractor must register with SAM.gov for a UEI number and maintain it for the duration of the project.
7. Will there be a Phasing Plan provided for the second floor work?
RESPONSE: Yes, ABW will issue a Phasing Plan in Addendum Number Two (2).

SUBSTITUTION REQUEST RESPONSES:

1. Section 23 33 00 – Duct Accessories
 - a. Dace Manufacturing RMBD CO3 is **approved** for use in Article/Paragraph 2.2: Manual Volume Control Dampers
 - b. Quiet Flex is an **approved equal** for use in Article/Paragraph 2.10: Flexible Ducts
2. Section 23 31 13 – Metal Ducts
 - a. Spiral Systems Incorporated is an **approved equal** for use in Article/Paragraph 2.2: Single-Wall Round Ducts and Fittings
3. ELECTRICAL ITEMS:
 - a. Prior Approvals: Subject to compliance with the provisions of the Contract Documents, Specifications, the following manufacturers may be substituted.

<u>MANUFACTURER</u>	<u>PRODUCT</u>
Nightingale	Type F2 Light Fixture
Kenall	Type F3 Light Fixture

Contractor shall note that prior approval is by manufacturer's name only. Contractor shall ensure that the products used in preparation of his proposal and proposed to be used on this project, is equivalent to that specified in appearance, performance, size, installation type, and shape. Any material found to not be equivalent to the specified will be rejected. Prior approval of one manufacturer does not automatically prior approve any subsidiary company, parent company and/or sister company and their associated products.

CHANGES TO THE PROJECT MANUAL:

1. GENERAL DOCUMENTS – Bid Form
 - a. The Bid Form is reissued in its entirety to reflect separation of First Floor Physician's Wing into Additive Alternate #1.
2. 01 11 00 SUMMARY OF WORK
 - a. This specification is added in its entirety to reflect the revised scope of the Base Bid
3. 01 23 00 BASE BID AND ALTERNATES
 - a. This specification is added in its entirety to reflect the separation of First Floor Physician's Wing into Additive Alternate #1

CHANGES TO THE CONTRACT DRAWINGS:

CIVIL:

1. No drawing adjustments this addendum.

STRUCTURAL:

1. Drawing S3.0 ROOF FRAMING PLAN & STRUCTURAL DETAILS
 - a. Replace previously issued sheet in its entirety
2. Drawing S4.0 ROOF FRAMING PLAN & STRUCTURAL DETAILS
 - a. Replace previously issued sheet in its entirety

ARCHITECTURAL:

1. Drawing A1.0 SITE MAP, VICINITY MAP, FIRST FLOOR EXIT PLAN, BUILDING INFORMATION, SYMBOL SCHEDULE, INDEX OF DRAWINGS, PROJECT DIRECTORY, AND GENERAL CONSTRUCTION NOTES
 - a. Index of Drawings
 - Revised name of Drawing A2.6 from ~~Additive Alternate #1~~ to **Additive Alternate #2**

- b. 3/A1.0 First Floor Exit Plan
 - Identifies work associated with Additive Alternate #1 – First Floor Physician’s Wing
- 2. Drawing A1.1 LIFE SAFETY PLAN & CODE ANALYSIS
 - a. 1/A1.1 Life Safety Plan – First Floor – Add Alt. #1
 - Identifies work associated with Additive Alternate #1 – First Floor Physician’s Wing
- 3. Drawing A1.2 DEMOLITION PLAN & ELEVATION AT FIRST FLOOR PHYSICIAN’S WING
 - a. 1/A1.2 Demolition Plan – Physician’s Wing – Add Alt. #1
 - Identifies work associated with Additive Alternate #1 – First Floor Physician’s Wing
- 4. Drawing A2.0 FLOOR PLAN & ENLARGED PLANS AT FIRST FLOOR PHYSICIAN’S WING
 - a. 1/A2.0 Floor Plan – Physician’s Wing – Add Alt. #1
 - Identifies work associated with Additive Alternate #1 – First Floor Physician’s Wing
 - b. 2/A2.0 Storage – Enlarged Plan - Add Alt. #1
 - Identifies work associated with Additive Alternate #1 – First Floor Physician’s Wing
 - c. 3/A2.0 Typical Suite 103 – Enlarged Plan – Add Alt. #1
 - Identifies work associated with Additive Alternate #1 – First Floor Physician’s Wing
 - d. 4/A2.0 Accessible Suite 101 – Enlarged Plan – Add Alt. #1
 - Identifies work associated with Additive Alternate #1 – First Floor Physician’s Wing
- 5. Drawing A2.2 REFLECTED CEILING PLANS
 - a. 1/A2.2 Reflected Ceiling Plan – First Floor – Add Alt. #1
- 6. Drawing A2.3 ROOF PLAN & ROOF DETAILS
 - a. 1/A2.3 Roof Plan
 - Identifies work associated with Additive Alternate #1 – First Floor Physician’s Wing
- 7. Drawing A2.4 SCHEDULES
 - a. Finish Schedule
 - Identifies finishes associated with Additive Alternate #1 – First Floor Physician’s Wing
 - b. Door Schedule
 - Identifies doors associated with Additive Alternate #1 – First Floor Physician’s Wing
 - c. Window Schedule
 - Identifies windows associated with Additive Alternate #1 – First Floor Physician’s Wing
 - d. 3/A2.4 Window Elevations
 - Identifies windows associated with Additive Alternate #1 – First Floor Physician’s Wing
- 8. Drawing A2.5 INTERIOR FINISH PLANS
 - a. Identifies work associated with Additive Alternate #1 – First Floor Physician’s Wing
 - b. Drawing included to ensure that Contractor has a clear color version of the interior finish plans
- 9. Drawing A2.6 ADDITIVE ALTERNATE #2
 - a. Drawing added in its entirety
 - b. Manufacturer List: Products of following manufacturers are acceptable subject to conformance requirements of Drawings, Schedules and Specifications:
 - Kawneer North America – TR-7100
 - YKK AP America – YHS 50 TU
 - Old Castle Building Envelope – Pinnacle Series 66P
 - Substitutions: 01 33 00 SUBMITTAL PROCEDURES – Substitution Request Form
 - c. Aluminum-framed storefront windows shall include the following features:
 - Internal blinds
 - Ligature resistant blinds control hardware
 - Impact resistant glass
 - d. Other aluminum storefront manufacturers will be considered
- 10. Drawing A3.0 EXTERIOR ELEVATIONS
 - a. 3/A3.0 South Elevation – Physician’s Wing – Add Alt. #1
 - Identifies work associated with Additive Alternate #1 – First Floor Physician’s Wing

- b. 4/A3.0 East Elevation – Physician’s Wing – Add Alt. #1
 - Identifies work associated with Additive Alternate #1 – First Floor Physician’s Wing
- 11. Drawing A4.0 BUILDING SECTIONS
 - a. 5/A4.0 Section @ Physician’s Wing – Add Alt. #1
 - Identifies work associated with Additive Alternate #1 – First Floor Physician’s Wing
- 12. Drawing A4.1 BUILDING SECTIONS & SECTION DETAILS
 - a. 2/A4.1 Section @ Physician’s Wing – Add Alt. #1
 - Identifies work associated with Additive Alternate #1 – First Floor Physician’s Wing
 - b. 5/A4.1 Section Detail @ Physician’s Wing – Add Alt. #1
 - Identifies work associated with Additive Alternate #1 – First Floor Physician’s Wing
 - c. 6/A4.1 Section Detail @ Corridor to Nursing Home & Physician’s Wing – Add Alt. #1
 - Identifies work associated with Additive Alternate #1 – First Floor Physician’s Wing
 - d. 7/A4.1 Section Detail @ Nursing Home & Physician’s Wing – Add Alt. #1
 - Identifies work associated with Additive Alternate #1 – First Floor Physician’s Wing
- 13. Drawing A4.2 SECTION DETAILS
 - a. 6/A4.2 Section Detail Through Window Sill – Add Alt. #1
 - Identifies work associated with Additive Alternate #1 – First Floor Physician’s Wing
- 14. Drawing A5.0 INTERIOR ELEVATIONS
 - a. 1/A5.0 Accessible Suite 101 – Add Alt. #1
 - Identifies work associated with Additive Alternate #1 – First Floor Physician’s Wing
 - b. 2/A5.0 Accessible Suite 101 – Add Alt. #1
 - Identifies work associated with Additive Alternate #1 – First Floor Physician’s Wing
 - c. 3/A5.0 Accessible Suite 101 RR – Add Alt. #1
 - Identifies work associated with Additive Alternate #1 – First Floor Physician’s Wing
 - d. 4/A5.0 Accessible Suite 101 RR – Add Alt. #1
 - Identifies work associated with Additive Alternate #1 – First Floor Physician’s Wing
 - e. 5/A5.0 Accessible Suite 101 RR – Add Alt. #1
 - Identifies work associated with Additive Alternate #1 – First Floor Physician’s Wing
 - f. 6/A5.0 Typical Suite RR – Add Alt. #1
 - Identifies work associated with Additive Alternate #1 – First Floor Physician’s Wing
 - g. 7/A5.0 Typical Suite RR – Add Alt. #1
 - Identifies work associated with Additive Alternate #1 – First Floor Physician’s Wing
 - h. 8/A5.0 Typical Suite Refreshment Station – Add Alt. #1
 - Identifies work associated with Additive Alternate #1 – First Floor Physician’s Wing

MECHANICAL:

1. Drawing M2.0R1
 - a. Replace M2.0 in its entirety with the attached M2.0R1. Changes to plan are clouded for reference.
2. Drawing M2.1R1
 - a. Replace M2.1 in its entirety with the attached M2.1R1. Changes to plan are clouded for reference.
3. Drawing M2.2R1
 - a. Replace M2.2 in its entirety with the attached M2.2R1. Changes to plan are clouded for reference.
4. Drawing M3.0R1
 - a. Replace M3.0 in its entirety with the attached M3.0R1. Changes to plan are clouded for reference.

PLUMBING:

1. Drawing P2.0R1
 - a. Replace P2.0 in its entirety with the attached P2.0R1. Changes to plan are clouded for reference.
2. Drawing P3.0R1
 - a. Replace P3.0 in its entirety with the attached P3.0R1. Changes to plan are clouded for reference.
3. Drawing P3.1R1
 - a. Replace P3.1 in its entirety with the attached P3.1R1. Changes to plan are clouded for reference.

FIRE PROTECTION:

1. Drawing FP2.0R1
 - a. Replace FP2.0 in its entirety with the attached FP2.0R1. Changes to plan are clouded for reference.

ELECTRICAL:

1. Drawing E1.1R1
 - a. Replace E1.1 in its entirety with the attached E1.1R1. Changes to plan are clouded for reference.
2. Drawing E2.1R1
 - a. Replace E2.1 in its entirety with the attached E2.1R1. Changes to plan are clouded for reference.
3. Drawing E3.1R1
 - a. Replace E3.1 in its entirety with the attached E3.1R1. Changes to plan are clouded for reference.

END OF ADDENDUM NUMBER ONE (1)

LOUISIANA UNIFORM PUBLIC WORK BID FORM

TO: LaSalle General Hospital
P. O. Box 2780
Jena, Louisiana 71342

BID FOR Workforce Capacity and Medical Access Project
LaSalle General Hospital
Jena, Louisiana

EDA Number 08-79-05595

Project Number 2024.01

(Owner to provide name and address of owner)

(Owner to provide name of project and other identifying information)

The undersigned bidder hereby declares and represents that she/he: a) has carefully examined and understands the Bidding Documents, b) has not received, relied on, or based his bid on any verbal instructions contrary to the Bidding Documents or any addenda, c) has personally inspected and is familiar with the project site, and hereby proposes to provide all labor, materials, tools, appliances and facilities as required to perform, in a workmanlike manner, all work and services for the construction and completion of the referenced project, all in strict accordance with the Bidding Documents prepared by: Ashe Broussard Weinzettle Architects and dated: February 2025.

(Owner to provide name of entity preparing bidding documents.)

Bidders must acknowledge all addenda. The Bidder acknowledges receipt of the following **ADDENDA:** (Enter the number the Designer has assigned to each of the addenda that the Bidder is acknowledging) _____ .

TOTAL BASE BID: For all work required by the Bidding Documents (including any and all unit prices designated "Base Bid" * but not alternates) the sum of:

_____ Dollars (\$ _____)

ALTERNATES: For any and all work required by the Bidding Documents for Alternates including any and all unit prices designated as alternates in the unit price description.

Alternate No. 1 Provide all labor and materials to construct single-story addition for Physician's Wing for the lump sum of:

_____ Dollars (\$ _____)

Alternate No. 2 Provide all labor and materials to replace windows in Behavioral Health Unit with new windows with integral blinds for the lump sum of:

_____ Dollars (\$ _____)

Alternate No. 3 N/A

N/A _____ Dollars (\$ _____)

NAME OF BIDDER: _____

ADDRESS OF BIDDER: _____

LOUISIANA CONTRACTOR'S LICENSE NUMBER: _____

NAME OF AUTHORIZED SIGNATORY OF BIDDER: _____

TITLE OF AUTHORIZED SIGNATORY OF BIDDER: _____

SIGNATURE OF AUTHORIZED SIGNATORY OF BIDDER **: _____

DATE: _____

THE FOLLOWING ITEMS ARE TO BE INCLUDED WITH THE SUBMISSION OF THIS LOUISIANA UNIFORM PUBLIC WORK BID FORM:

* The Unit Price Form shall be used if the contract includes unit prices. Otherwise it is not required and need not be included with the form. The number of unit prices that may be included is not limited and additional sheets may be included if needed.

** **A CORPORATE RESOLUTION OR WRITTEN EVIDENCE** of the authority of the person signing the bid for the public work as prescribed by LA R.S. 38:2212(B)(5).

BID SECURITY in the form of a bid bond, certified check or cashier's check as prescribed by LA R.S. 38:2218(A) attached to and made a part of this bid

SECTION 01 11 00

SUMMARY OF THE WORK

PART 1 GENERAL

1.1 SCOPE

- A. This Project Manual and accompanying Drawings provide for labor, materials, plant, supplies, equipment, facilities and appurtenances necessary for preparation of and work necessary for construction and completion of the project titled, **WORKFORCE CAPACITY AND MEDICAL ACCESS PROJECT, LASALLE GENERAL HOSPITAL, Jena, Louisiana**, complete and in accordance with all requirements of the Contract Documents.

1.2 PROJECT DESCRIPTION

- A. Project consists of new second floor expansion over existing first floor ER Waiting Area and interior remodeling to second floor patient rooms and bathrooms.
- B. New construction will be steel-framed, metal wall panels, low-slope roofing.
- C. Interior remodeling will consist of interior partitions, millwork, cabinets, doors, etc., with associated mechanical and electrical work.
- D. Security and fire alarm system work will be done under separate contract with Convergent; Building Contractor will coordinate with Convergent as required.
- E. Hospital paging system work will be done under separate contract with Kinetix, Building Contractor will coordinate with Kinetix as required.
- F. Erect and maintain all required temporary walls, lights, barricades and warning signs, as may be necessary to protect the public and workmen.
- G. Contractor shall become familiar with and at all times shall observe and comply with all Federal, State and Local laws and/or ordinances and regulations in any manner affecting the conduct of the work.
- H. Contractor shall achieve Substantial Completion of the project by February 26, 2027.

END OF SECTION

SECTION 01 23 00

BASE BID AND ALTERNATES

PART 1 GENERAL

1.1 METHOD OF BIDDING

- A. Base Bids will be received for all work necessary to complete WORKFORCE CAPACITY AND MEDICAL ACCESS, LASALLE GENERAL HOSPITAL, Jena, Louisiana, as shown on Drawings and Specifications; exclusive of the Alternates, which are described below.

1.2 BASE BID

- A. All work indicated for construction of WORKFORCE CAPACITY AND MEDICAL ACCESS, LASALLE GENERAL HOSPITAL, Jena, Louisiana.

1.3 ADDITIVE ALTERNATES

A. Additive Alternate Number One

Work for this Alternate generally includes, but is not limited to, the following, and is further described by the Bid Document Drawings.

1. Construct new single-story addition for Physician's Wing including all associated mechanical, electrical, and plumbing work to add the following:

- Electrical Closet 100A
- Network Closet 100B
- Accessible Suite 101
- Suite 102
- Suite 103
- Suite 104
- Suite 105
- Suite 106
- Corridor 107
- Windows mark A and B


2. Rework existing site drainage and tie-in new downspouts to subsurface drainage.

B. Additive Alternate Number Two

Work for this Alternate generally includes, but is not limited to, the following, and is further described by the Bid Document Drawings.


1. Replace windows in Behavioral Health Unit with new aluminum storefront windows with impact resistant glass and internal blinds.
(20) 48" wide (2) 36" wide

END OF SECTION

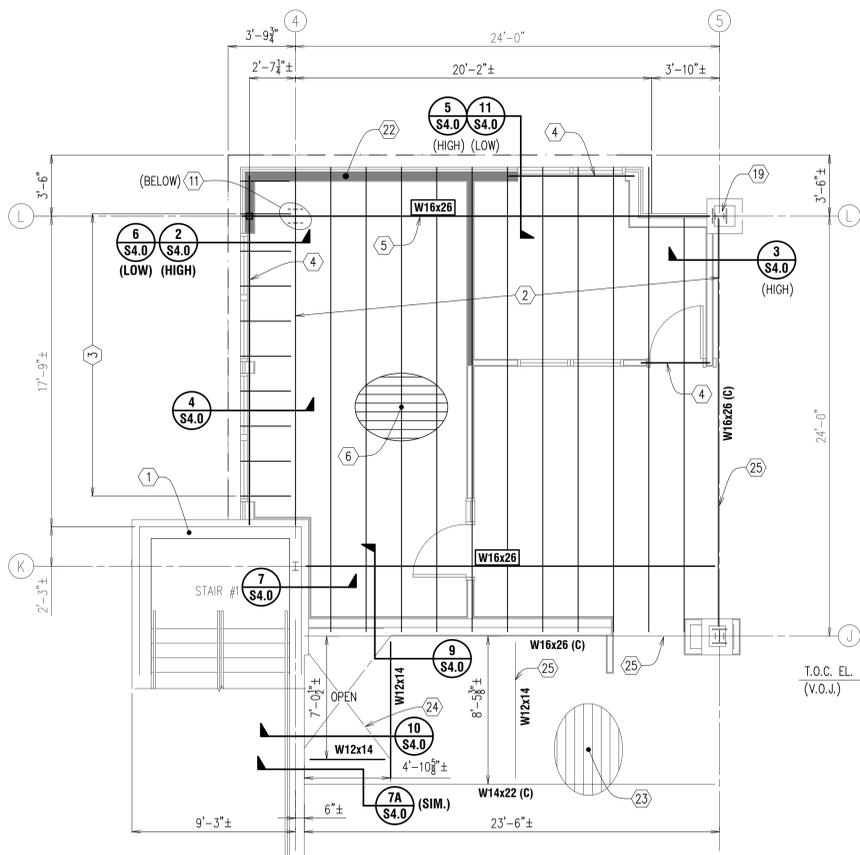


ELEVATION NOTES:
 1ST FLR. - EL. 217'-8" (REF. EL. 0'-0")
 2ND FLR. - EL. 232'-4" ((+) 14'-8")
 3RD FLR. - EL. 246'-4" ((+) 28'-8")


NOTE: (22) INDICATES SHEAR WALL LOCATION AND LENGTH
 (C) INDICATES COMPOSITE EXISTING BEAM

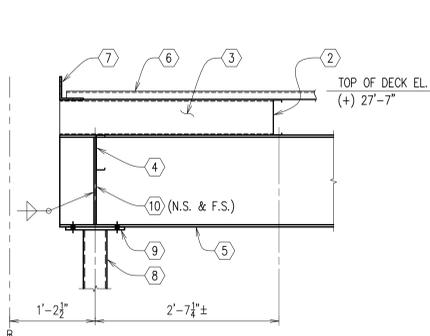


2 SECTION S4.0
 SCALE: 1" = 1'-0"
 RE: 1/S4.0

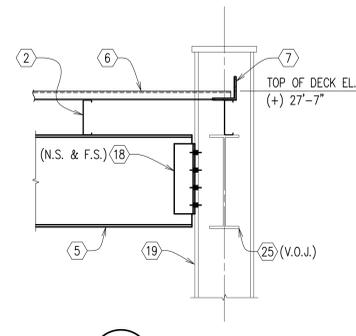


3 SECTION S4.0
 SCALE: 1" = 1'-0"
 RE: 1/S4.0

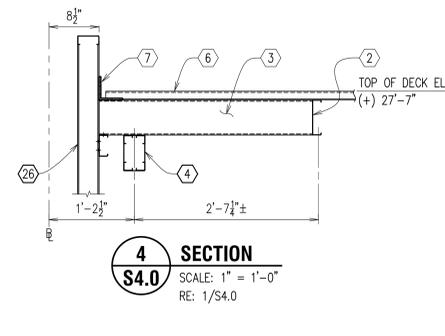


4 SECTION S4.0
 SCALE: 1" = 1'-0"
 RE: 1/S4.0

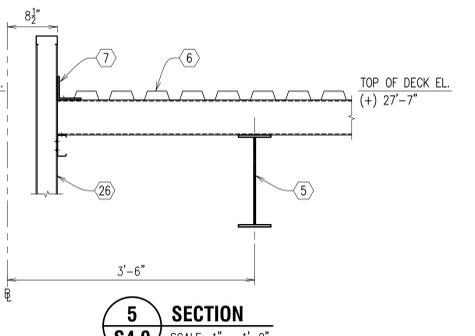


5 SECTION S4.0
 SCALE: 1" = 1'-0"
 RE: 1/S4.0

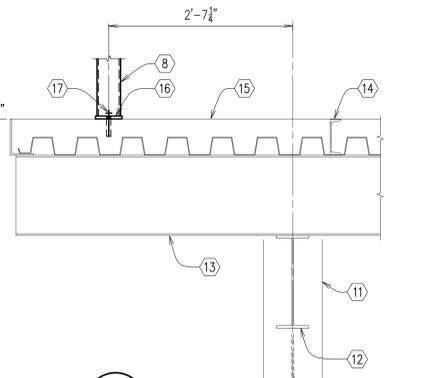

6 SECTION S4.0
 SCALE: 1" = 1'-0"
 RE: 1/S4.0

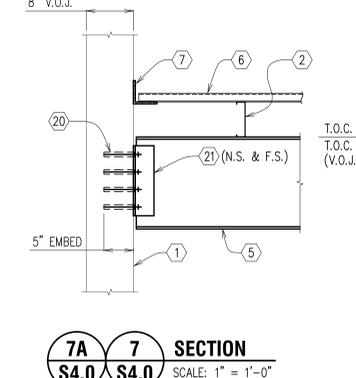

7A SECTION S4.0
 SCALE: 1" = 1'-0"
 RE: 1/S4.0
NOTE: AT SECTION 7A, NEW BEAM INSTALLED UNDER EXISTING ROOF DECK PRIOR TO CUTTING EXISTING ROOF DECK. (SIM. TO 10/S4.0)

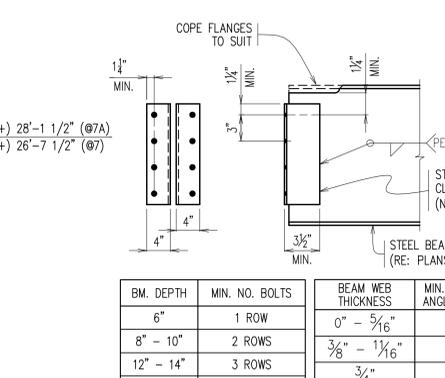


8 STD. BOLTED FRAMED BEAM CONN. S4.0
 SCALE: 1" = 1'-0"


BM. DEPTH	MIN. NO. BOLTS	BEAM WEB THICKNESS	MIN. CONNECTION ANGLE THICKNESS
6"	1 ROW	0" - 5/16"	5/16"
8" - 10"	2 ROWS	3/8" - 1 1/16"	3/8"
12" - 14"	3 ROWS	3/4"	7/16"
16" - 18"	4 ROWS	1 1/4"	1/2"
21" - 24"	5 ROWS	1 3/4"	1/2"
27" & UP	.22 x BM. DEPTH		

KEY NOTES (THIS SHEET ONLY)


- (1) EXISTING CONCRETE WALL
- (2) C10x2.5 (12 GA.) PURLINS @ 2'-0" O.C.
- (3) C10x2.5 (12 GA.) OUTLOOKERS @ 2'-0" O.C.
- (4) HEADER (RE: NOTES)
- (5) STEEL BEAM (RE: PLAN)
- (6) 1.5B (20 GA.) DECK (GALV.)
- (7) 3"x3"x1/4" EDGE ANGLE (CONT.)
- (8) T.S. 4"x4"x1/4" POST
- (9) 1/2" CAP PLATE WITH (4) 1/2" A325-X BOLTS
- (10) 1/4" STIFFENER PLATE
- (11) EXISTING WF COLUMN (W10x49 - VOJ)
- (12) EXISTING WF BEAM (W16x31 - VOJ)
- (13) EXISTING WF BEAM (W14x22 - VOJ)
- (14) EXISTING C6 IN SLAB
- (15) EXISTING CONCRETE DECK
- (16) 1/2" BASE PLATE
- (17) 3/4" EXPANSION ANCHOR WITH 3" EMBED
- (18) STANDARD AISC CLIP ANGLES (RE: TABLE)
- (19) EXISTING WF COLUMN (W10x54 - VOJ)
- (20) 1/2" A36 THREADED ROD WITH HILTI HIT-RE500 V3 EPOXY SYSTEM
- (21) 3"x3"x3/8" ANGLE WITH (4) ANCHORS (RE: (20))
- (22) SHEAR WALL (RE: NOTES)
- (23) EXISTING ROOF DECK (NO WORK)
- (24) EXISTING ROOF DECK (DEMO)
- (25) EXISTING STEEL BEAM
- (26) STUD FRAMING (RE: ARCH. FRAMING)
- (27) 600S137-43 STUD @ 16" O.C.
- (28) 6" STUD TRACK
- (29) 1/2" DIA. A36 ANCHOR @ 16" O.C. W/ 3" EMBED & HILTI HIT-RE 500 EPOXY
- (30) 800S137-43 RAFTER @ 16" O.C.
- (31) 8" STUD BOX HEADER
- (32) 6" STUD BOX HEADER
- (33) 14 GA. STIFF CLIP W/ (4) #12 TEK SCREWS
- (34) 12 GA. x 2'-0" LONG STRAP W/ (8) #12 TEK SCREWS AT EACH RAFTER
- (35) EXISTING DECK (DEMO)
- (36) EXISTING CMU WALL
- (37) CONCRETE GROUT @ EXISTING DECK LEDGE
- (38) EXISTING STUD WALL

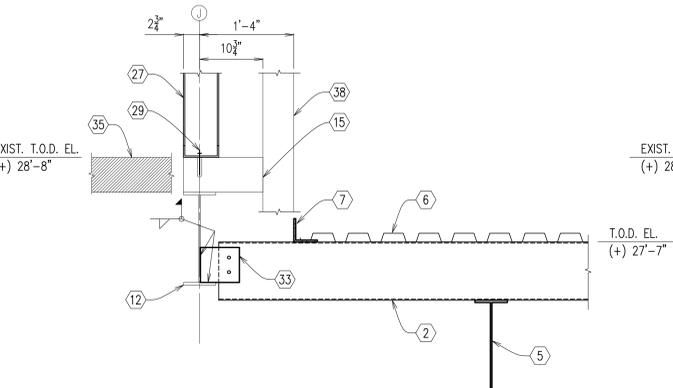


9 SECTION S4.0
 SCALE: 1" = 1'-0"
 RE: 1/S4.0

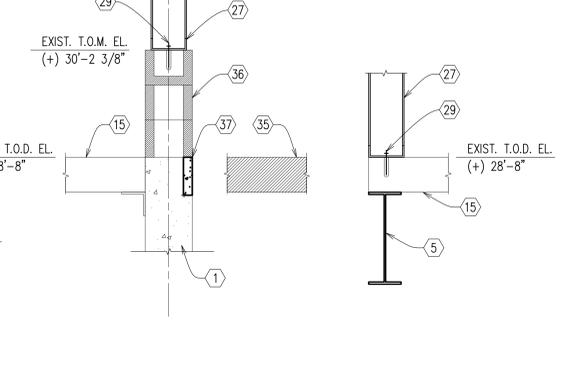


10 SECTION S4.0
 SCALE: 1" = 1'-0"
 RE: 1/S4.0

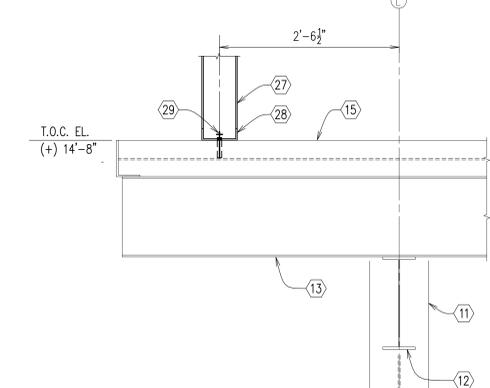

11 SECTION S4.0
 SCALE: 1" = 1'-0"
 RE: 1/S4.0

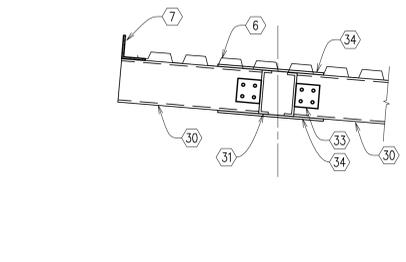

12 SECTION S4.0
 SCALE: 1" = 1'-0"
 RE: 3/A4.2

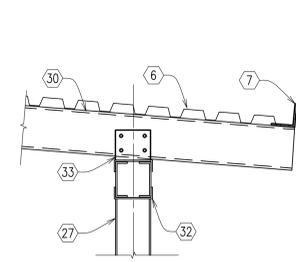

13 SECTION S4.0
 SCALE: 1" = 1'-0"
 RE: 3/A4.2

LIGHT-GAUGE STUD FRAMING NOTES:

1. MEMBER SIZES:
 - 1.1. EXTERIOR WALL - 600S162-43 (33 KSI) @ 16" O.C.
 - 1.2. INTERIOR SHEAR WALL - 362S162-43 (33 KSI) @ 12" O.C.
 - 1.3. INTERIOR BEARING WALL - 362S162-43 (33 KSI) @ 12" O.C.
 - 1.4. INTERIOR NON-BEARING WALL - 362S162-43 (33 KSI) @ 16" O.C.
2. SHEAR WALLS, AS LOCATED ON S3.0, SHALL USE FLAT STRAP SHOWN ON 2/S3.0 ON BOTH SIDES OF WALL. INSTALL IN ACCORDANCE WITH MANUFACTURER'S REQUIREMENTS. FLAT STRAP SHALL BE MINIMUM 4" WIDE WITH (10) #12 TEK SCREWS. ANCHOR TO BASE SLAB SHALL BE MINIMUM 7/8" DIAMETER (A36) THREADED ROD WITH 4" EMBED AND HILTI HIT-RE 500 V3 EPOXY ANCHORING SYSTEM OR APPROVED EQUAL. USE STIFFWALL BOOT KIT - SMALL / MEDIUM / TRANSITION WITH (4) 3/4" DIA. A325-X BOLTS TO CONNECT STUD COLUMN TO STIFFWALL BASE PLATE. REFERENCE LIGHT GAUGE MANUAL FOR ADDITIONAL INFORMATION.
3. HEADERS:
 - 3.1. SIZE - 800S162-43 (33)
 - 3.2. USE HE(L)-43 (50 KSI) STIFF CLIP WITH (16) #10 TEK SCREWS TO CONNECT HEADER TO DOUBLE STUD POST.
 - 3.3. REFERENCE DETAIL 12/S3.0 FOR ADDITIONAL HEADER REQUIREMENTS.
4. ALL STUD WALLS HAVE WEAK AXIS BRACING AT 48" O.C. WEAK AXIS BRACING BY LIGHT-GAUGE BRIDGE BAR AND CONNECTED TO STUDS WITH BRIDGE CLIPS AND No. 10 TEK SCREWS (MIN.).



mmlh
 MEYER, MEYER, LACROIX & TESSON, Inc.
 ENGINEERS & LAND SURVEYORS
 ALEXANDRIA, LOUISIANA

PROJ. NO. 7889 DATE: 1/24/25
 DESIGN: WLM DRAWN: AWB

LASALLE GENERAL HOSPITAL
 Workforce Capacity and Medical Access Project
 EDA No. 08-79-05595
 187 Ninth St. Jena, Louisiana 71342

REVISIONS

revision	description	date
1	ADDENDUM No. 1	10/14/25


project no. 2024.01
 drawn: AWB
 checked: WLM
 project date: DEC 2024
 drawing no. S4.0

LASALLE GENERAL HOSPITAL

WORKFORCE CAPACITY AND MEDICAL ACCESS PROJECT

EDA NO. 08-79-05595


187 NINTH ST. JENA, LOUISIANA 71342

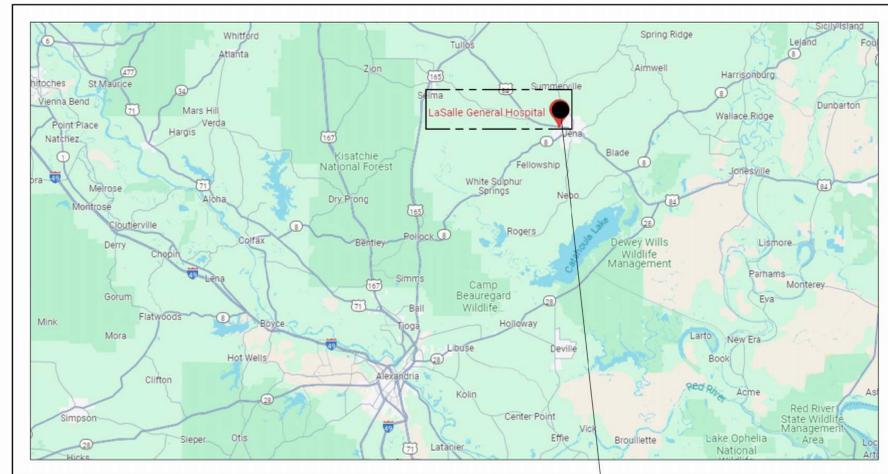

1 VICINITY MAP
SCALE: NTS



2 SITE MAP
SCALE: NTS

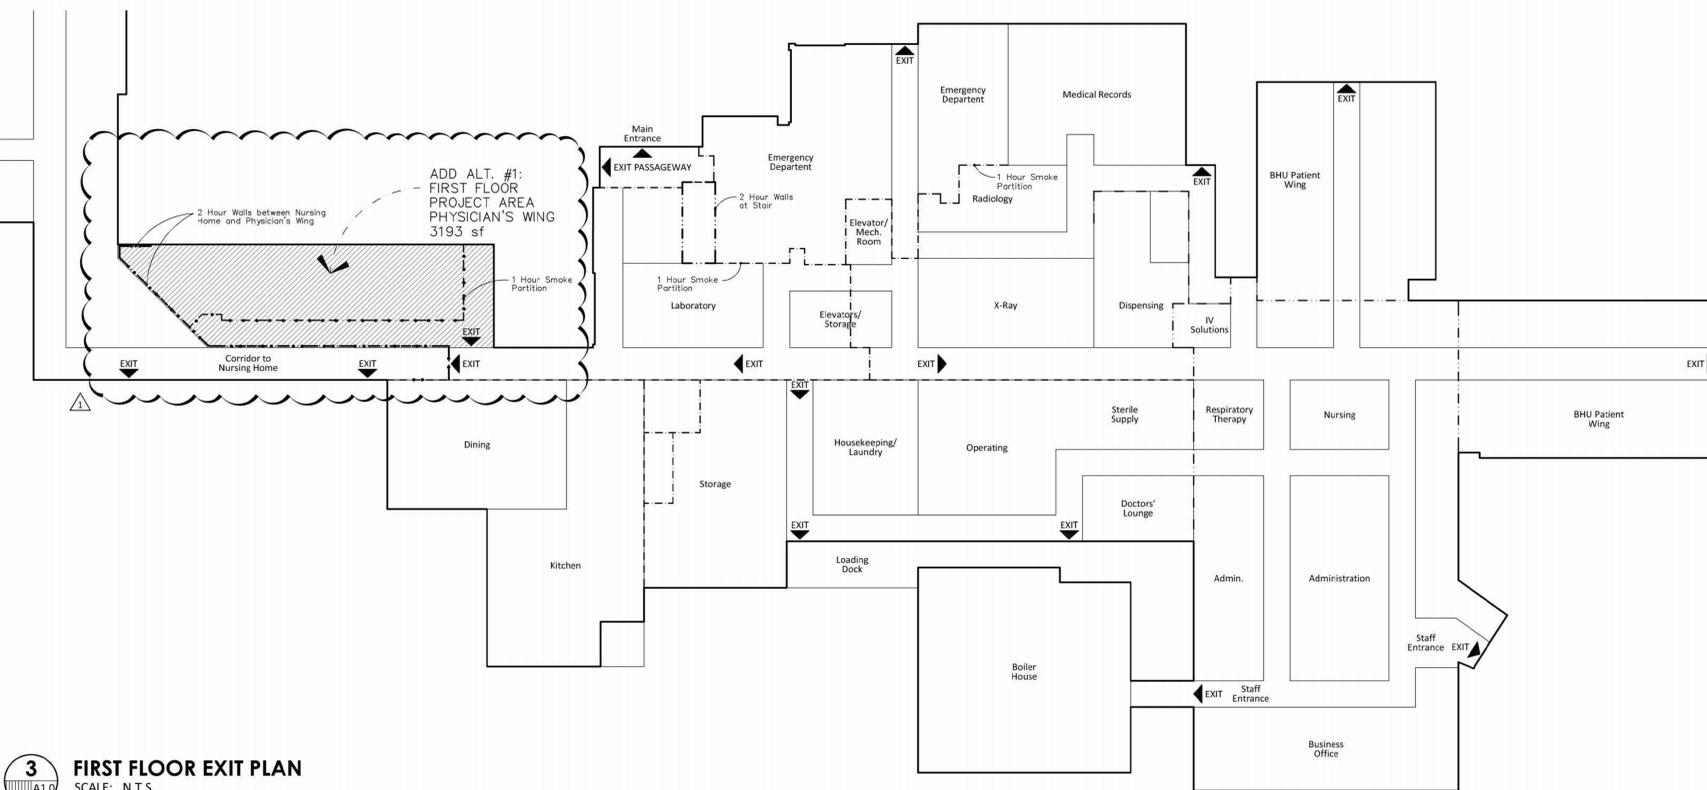

3 FIRST FLOOR EXIT PLAN
SCALE: N.T.S.


SYMBOL SCHEDULE

1	DRAWING TITLE
A1.0	SCALE: SHEET NUMBER ON WHICH THIS SECTION OR DETAIL IS DRAWN
A	DETAIL NUMBER
AS	AREA OF DETAIL
AS.0	SHEET NUMBER ON WHICH THIS DETAIL IS DRAWN
A6.0	SECTION OR DETAIL NUMBER
A6.0	DIRECTION OF CUTTING PLANE
AS.0	SHEET NUMBER ON WHICH THIS SECTION OR DETAIL IS DRAWN
1	PLAN KEYNOTE
1	DEMOLITION KEYNOTE
101	SECTION AND ELEVATION KEYNOTES
101	DOOR SCHEDULE NUMBER
A	WINDOW SCHEDULE LETTER

BUILDING INFORMATION	GENERAL CONSTRUCTION NOTES
<p>This project consists of the construction of the following at an existing hospital building:</p> <ul style="list-style-type: none"> construct new small single-story addition for Physicians Sleeping Quarters construct new second floor expansion for Healthcare Student Training Room over existing first floor ER Waiting Area remodel second floor Nurse Station: walls, doors, millwork, utilities, finishes remodel second floor patient room bathrooms: fixtures, utilities, finishes remodel second floor patient rooms and corridors: utilities, finishes <p>Occupancy: IBC 2015 - Institutional, I-2 NFPA 101: 2015 - Healthcare</p> <p>Construction Type: IBC 2015 - Type I (A) NFPA 220 - Type I (332)</p> <p>Square Footage: Addition First Floor - 3193 sf Addition Second Floor - 658 sf Addition Total - 3851 sf Renovation Second Floor - 9320 sf</p>	<ol style="list-style-type: none"> Contractor shall visit the project site prior to the start of construction and shall familiarize himself with all existing conditions. Any discrepancies shall be reported to the Architect for clarification and direction. All work shall be done in full compliance with all applicable codes and regulations. Any discrepancies shall be reported immediately to the Architect for clarification. Figured dimensions shall govern over scaled dimensions in all cases. Contractor shall verify all dimensions prior to the start of construction. Report any discrepancies to the Architect for clarification. Contractor shall verify locations of existing utilities within the project area by visiting the site, and consulting with local utility companies and the Owner's representative. Verification shall occur prior to the start of construction. Any discrepancies shall be reported to the Architect for clarification. Contractor shall be responsible for all work necessary to provide utilities to the project. General Contractor shall be responsible for coordinating and scheduling the work of the subcontractors. Inform the Architect immediately of any conflicts or potential delays. General Contractor shall be responsible for all Work indicated on all sections of the Drawings and shall verify that each subcontractor is completely aware of their portion of the Work. The General Contractor shall insure that any work omitted from a subcontractor's bid is performed by that subcontractor or the General Contractor. General Contractor shall be responsible for insuring that all work on the site which requires excavation of any kind be done as per all applicable regulations, especially LRS 40:1749.11, "Louisiana Underground Utilities and Facilities Damage Prevention Law", which states, "no person shall excavate or demolish without first ascertaining the location of underground utilities by serving telephonic notice to a regional notification program". The Contractor shall contact, by telephone, the regional notification program, "Louisiana Call One" at 1-800-584-4274 at all appropriate times during the project. The Contractor shall verify all pertinent procedures before starting any site work and shall report any discrepancies or changes in the regulations to the Architect. Keynotes used for one drawing or detail shall typically refer to all other drawings and details which have corresponding building elements or materials. Contractor shall coordinate access to project site, including parking and material storage with Hospital staff and Designer. Loud music, smoking, weapons, offensive language, and similar negative conditions are strictly prohibited. All Contractor personnel shall behave in a positive manner appropriate to a hospital. Contractor shall erect all necessary fencing, signs, and barriers to protect and insure the safety of all workmen, the public, staff, and students at all times. Contractor shall maintain the site in a clean, safe condition at all times. Contractor shall provide and maintain portable toilets for use by Contractor personnel. Contractor shall maintain all required and typical insurance coverages. Owner and Architect have no control over construction means and methods; Contractor alone bears that responsibility. All safety procedures are the Contractor's responsibility.
INDEX OF DRAWINGS	
<p>A1.0 Site Map, Vicinity Map, First Floor Exit Plan, Building Information, Symbol Schedule, Index of Drawings, Project Directory and General Construction Notes</p> <p>A1.1 Life Safety Plan & Code Analysis</p> <p>C1.0 Demolition & Site Plan</p> <p>C2.0 Details</p> <p>A1.2 Demolition Plan & Elevation at First Floor Physician's Wing</p> <p>A1.3 Demolition Plan & Elevations at Second Floor Addition & Renovation</p> <p>A2.0 Floor Plan & Enlarged Plans at First Floor Physician's Wing</p> <p>A2.1 Overall Plan & Enlarged Plans at Second Floor Addition & Renovation</p> <p>A2.2 Reflected Ceiling Plans</p> <p>A2.3 Roof Plan & Roof Details</p> <p>A2.4 Schedules</p> <p>A2.5 Interior Finish Plans</p> <p>A2.6 Additive Alternate #2</p> <p>A3.0 Exterior Elevations</p> <p>A4.0 Building Sections</p> <p>A4.1 Building Sections & Section Details</p> <p>A4.2 Section Details</p> <p>A5.0 Interior Elevations</p> <p>A5.1 Interior Elevations & Plan Details</p> <p>A5.2 Millwork Details</p> <p>S1.0 General Notes & Typical Details</p> <p>S2.0 Foundation Plan & Details</p> <p>S3.0 Roof Framing Plan & Structural Details</p> <p>S4.0 Roof Framing Plan & Structural Details</p> <p>M1.0 Mechanical Demolition Plan - Supply/Return</p> <p>M1.1 Mechanical Demolition Plan - Exhaust/Piping</p> <p>M2.0 Mechanical Plan - Physician's Wing</p> <p>M2.1 Mechanical Plan - Supply/Return</p> <p>M2.2 Mechanical Plan - Exhaust/Piping</p> <p>M3.0 Mechanical Schedules</p> <p>M3.1 Mechanical Details</p> <p>P1.0 Plumbing Demolition Plan</p> <p>P2.0 Plumbing Plan - Physician's Wing</p> <p>P2.1 Plumbing Plan - Second Floor</p> <p>P2.2 Plumbing Plan - Second Floor Enlarged Plans</p> <p>P3.0 Plumbing Schedules/Details</p> <p>P3.1 Plumbing Risers</p> <p>FP2.0 Fire Protection Plan - Physician's Wing</p> <p>FP2.1 Fire Protection Plan - Second Floor</p> <p>E1.1 Electrical Site Plan</p> <p>E1.2 Second Floor Electrical Demolition Plan</p> <p>E2.1 First Floor Lighting Plan - Physician's Wing</p> <p>E2.2 Second Floor Lighting Plan</p> <p>E3.1 First Floor Power Plan - Physician's Wing</p> <p>E3.2 Second Floor Power Plan</p>	

PROJECT DIRECTORY

Owner:	Hospital Service District No. 2 dba LaSalle General Hospital 187 Ninth Street Jena, LA 71342 Phone: 318.992.6687 Attn: Lana Francis, CEO lfrancis@lgh-jena.org
Architect:	Ashé Broussard Weinzeitle Architects 301 Jackson Street, Suite 205 Alexandria, LA 71301 Phone: 318.473.0252 Fax: 318.442.6007 Attn: Jim Weinzeitle jimweinzeitle@abwarchitects.com Kris Linzey klinzey@abwarchitects.com
Structural:	Meyer, Meyer, LaCroix & Hixson Inc. 100 Engineer Place Alexandria, LA 71303 Phone: 318.448.0888 Fax: 318.448.0885 Attn: Luke Miller luke.miller@mmlh.com
Mechanical:	ADG Engineering, Inc. 3909 West Congress Street, Suite 201 Lafayette, LA 70506 Phone: 337.234.5710 Attn: Roland LeLeux rleleux@adginc.org Andrew Rodriguez arodriguez@adginc.org
Electrical:	ADG Engineering, Inc. 301 Jackson Street, Suite 204 Alexandria, LA 71301 Phone: 318.445.8870 Attn: Mark Neely mneely@adginc.org
Civil:	Monceaux Buller & Associates, LLC 610 Desoto Street Alexandria, LA 71301 Phone: 318.442.8465 Attn: Brandon Monceaux brandon@monceauxbuller.com

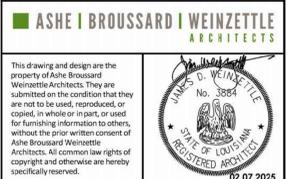

REVISIONS

revision	description	date
1	Addendum No. One	10.15.25

LASALLE GENERAL HOSPITAL		project no.	2024.01
Workforce Capacity and Medical Access Project		drawn	KPL
EDA No. 08-79-05595		checked	JDW
187 Ninth St. Jena, Louisiana 71342		project date	FEB 2025
sheet contents		drawing no.	A1.0

GENERAL DEMOLITION NOTES

- Contractor shall coordinate any demolition work with the Owner and the Architect. This shall include scheduling of the work and the storage of materials.
- Contractor shall protect from damage all adjacent construction to remain after demolition work is complete. Any damaged construction, materials or finishes shall be repaired or replaced (at the discretion of the Architect) at no additional cost to the Owner.
- Existing walls to remain have been indicated in the Drawings. However, Contractor may demolish certain walls and rebuild them along with the new construction providing it is more cost effective to do so. Verify any revisions to the demolition work with the Architect prior to the start of construction.
- Refer to Mechanical and Electrical Drawings for demolition/relocation of all appropriate fixtures and equipment. Typically, removal of walls require removal or rerouting of existing utilities within those walls.
- Contractor shall patch and repair walls and floor where existing partitions, equipment, plumbing, conduits, etc. have been removed. Prepare as required to receive new finish.
- Certain items to be removed are to remain the property of the Owner. Refer to Demolition Plan for any such items.
- Certain items removed under the demolition work are to be salvaged for reuse under new work. Refer to Demolition Plan for specific items.
- All fixtures, appliances, equipment, accessories or materials not specifically scheduled for reuse are to be returned to the Owner.
- Contractor shall erect dust partitions throughout all phases of the work to insure protection of hospital staff, patients, and the general public.
- Contractor to provide adequate shoring as required for the removal of any existing wall construction. See Structural Drawings for new wall construction, support beams or lintels.
- Contractor shall erect barriers as required to protect workers and the general public.
- Contractor may be required to halt work at any time if their work activity hinders any procedure being performed by the Hospital and may only resume when informed by either the Architect or the Owner's representative to do so.
- Contractor shall take all precautions necessary to insure water-tightness of building during demolition and new construction.
- Contractor shall maintain existing means of egress from exit doors open and passable at all times during demolition. Contractor shall build temporary partitions, post signage and take all measures necessary to assure exit remains clear.
- Contractor shall take all precautions necessary to insure building security. At the close of each day's work the Contractor shall secure all portions of the work against entry.
- Refer to Structural Plans for demolition of certain steel beams, supports, etc. and any required temporary support.
- The ground area around the existing building shall be thoroughly cleaned and free from any demolished materials and debris at all times. Do not allow demolished materials to accumulate, but promptly remove them from the site.
- All demolished materials shall be disposed of by the Contractor in a method that complies with any and all Federal, State and Local codes, ordinances and regulations.
- See Mechanical and Electrical Drawings for related items to be addressed in demolition.
- All work shall be phased and coordinated with Hospital personnel to permit Hospital activities to function continually.
- Where existing items or walls are removed, Contractor shall patch remaining surfaces as required to match adjacent.

DEMOLITION KEYNOTES

- Remove portion of existing scored masonry block wall between existing masonry block clad columns from slab to soffit, complete. Provide shoring, see STRUCTURAL.
- Remove portion of existing scored masonry block wall from slab to soffit, complete. Provide shoring, see STRUCTURAL.
- Remove existing thru-wall hvac unit. Protect from damage and reinstall as noted on Sheet A2.0.
- Remove portion of existing scored masonry block wall for relocated thru-wall hvac unit.
- Remove existing scupper and downspout. Protect from damage and relocate as noted on Sheet A2.0.
- Remove and relocate storm drain catch basin, see CIVIL.
- Protect existing wall construction.
- Remove and relocate hose bibb.
- Portion of existing roof/fascia construction to remain.
- Existing wall construction to be removed complete.
- Existing column to remain.
- Remove existing sign and return to Owner for future use.
-
-
-
-



This drawing and design are the property of Ashe Broussard Weinzettle Architects. They are submitted on the condition that they are not to be used, reproduced, or copied, in whole or in part, or used for furnishing information to others, without the prior written consent of Ashe Broussard Weinzettle Architects. All common law rights of copyright and otherwise are hereby specifically reserved.

JAMES D. WEINZETTLE
No. 3884
STATE OF LOUISIANA
REGISTERED ARCHITECT
02.07.2025


REVISIONS


revision	description	date
1	Addendum No. One	10.15.25

LASALLE GENERAL HOSPITAL
Workforce Capacity and Medical Access Project
EDA No. 08-79-05595
187 Ninth St. Jena, Louisiana 71342


project no. 2024.01
drawn: KPL
checked: JDW
project date: FEB 2025
drawing no.

sheet contents: **DEMOLITION PLAN & ELEVATION AT FIRST FLOOR PHYSICIAN'S WING** drawing no. **A1.2**

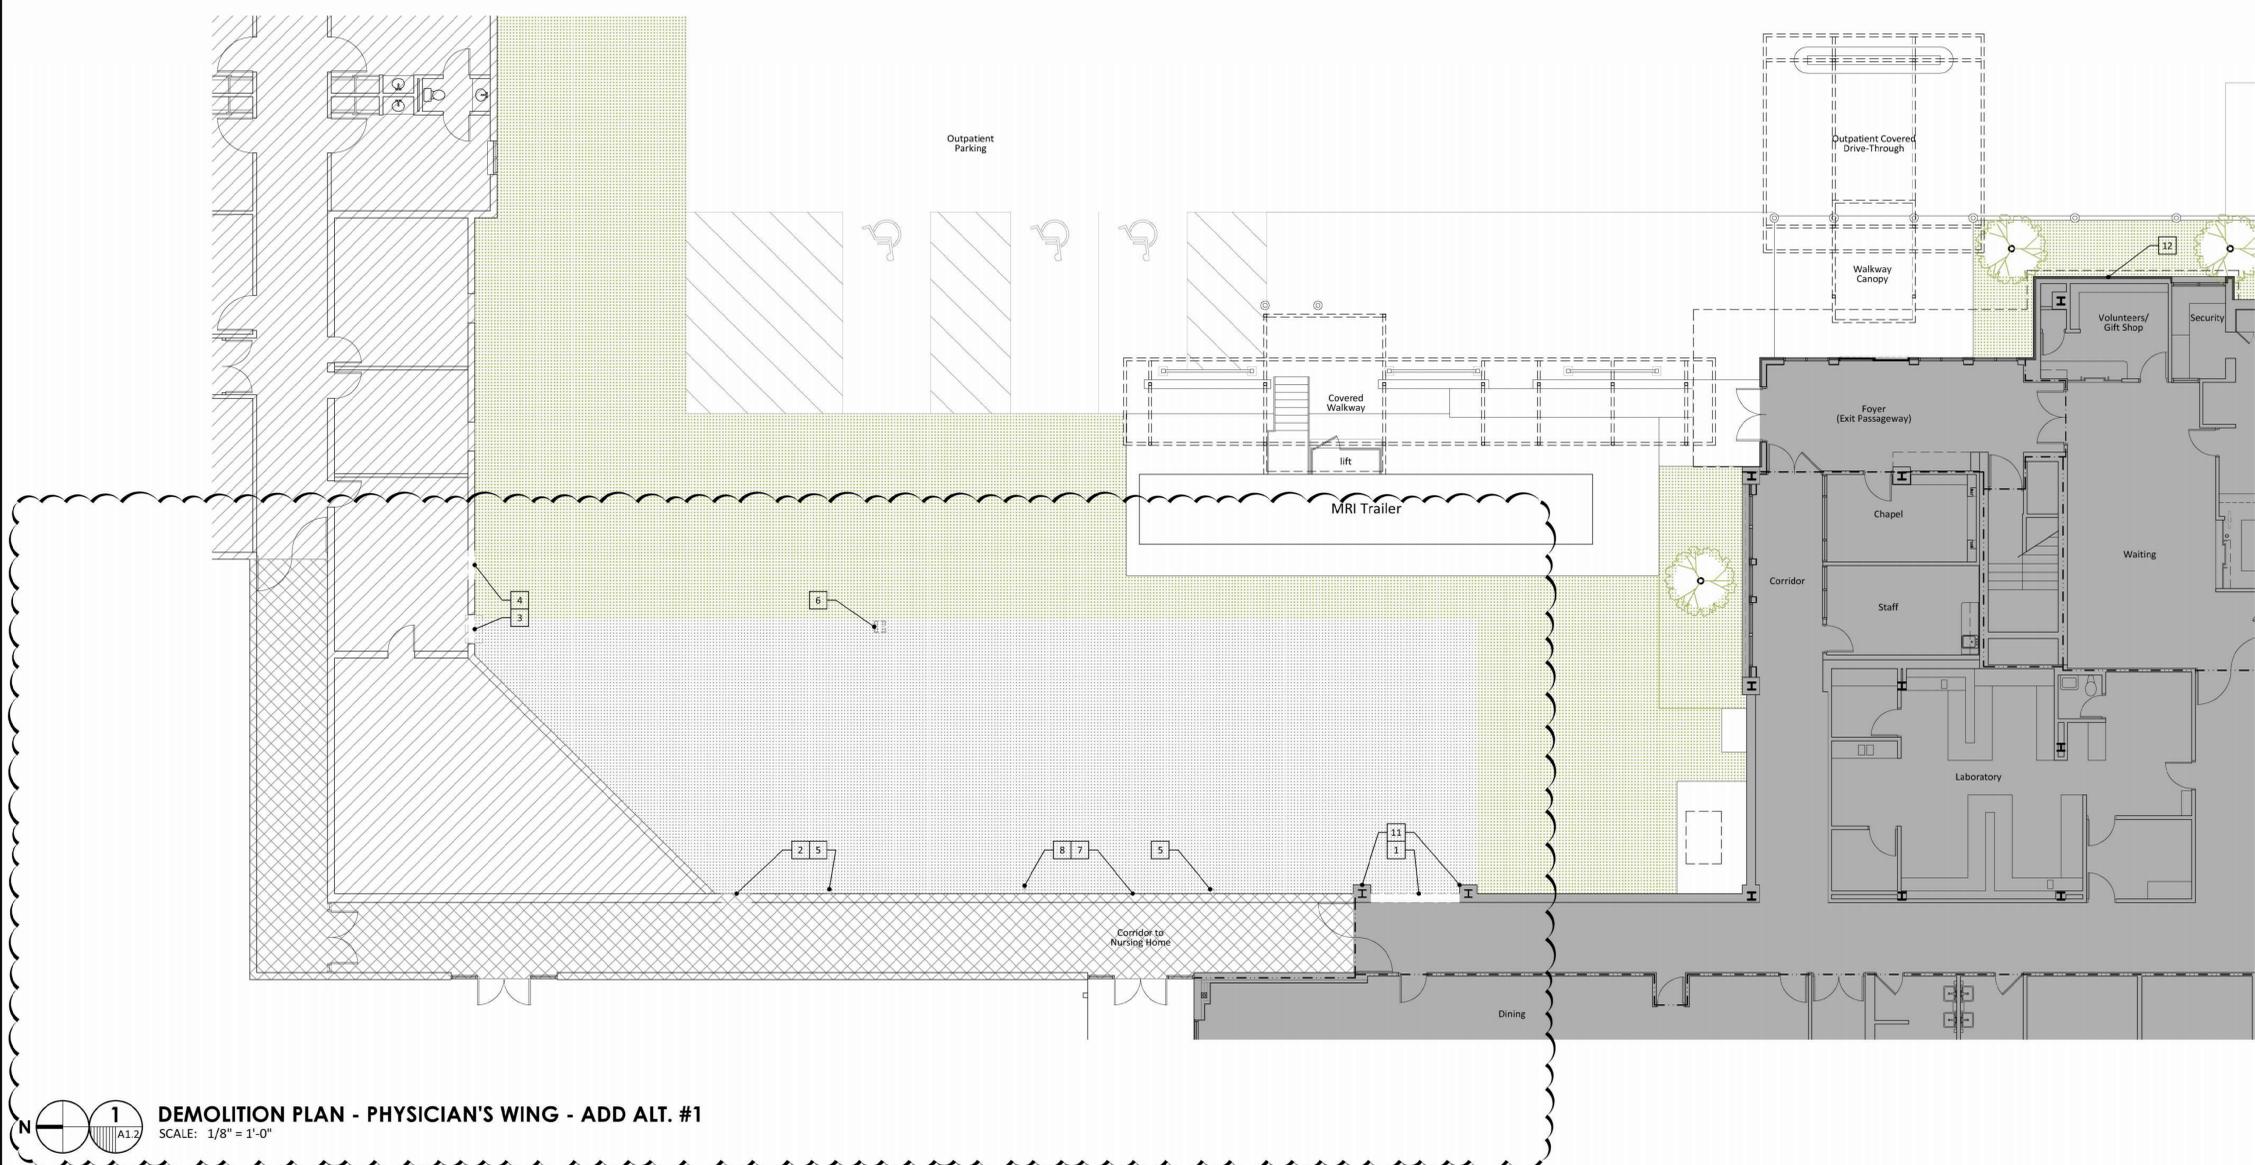


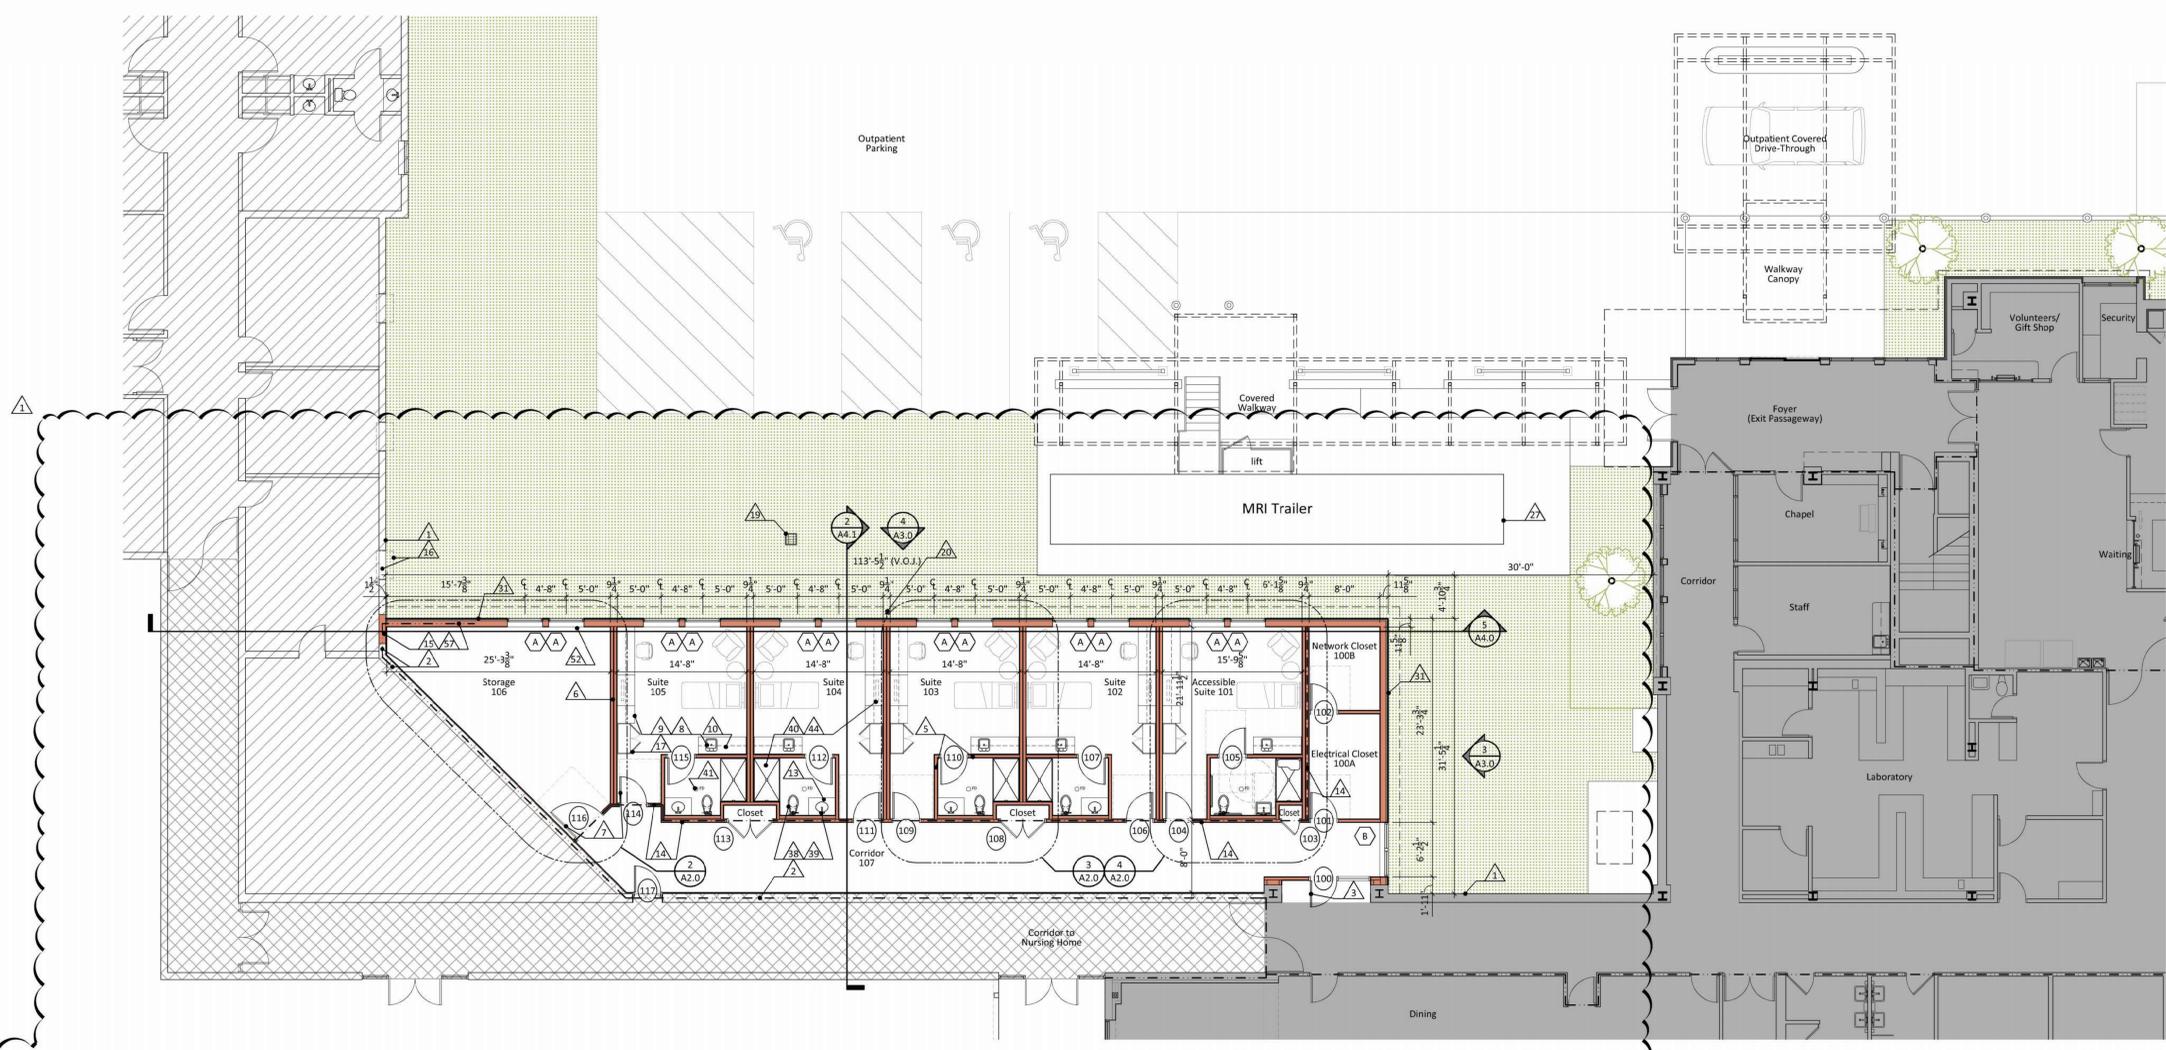


1 FLOOR PLAN - PHYSICIAN'S WING - ADD ALT. #1
SCALE: 1/8" = 1'-0"

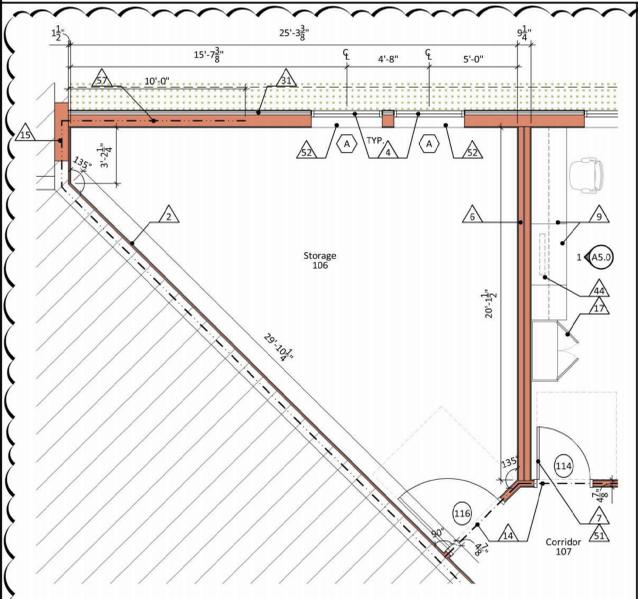

2 STORAGE - ENLARGED PLAN - ADD ALT. #1
SCALE: 1/4" = 1'-0"

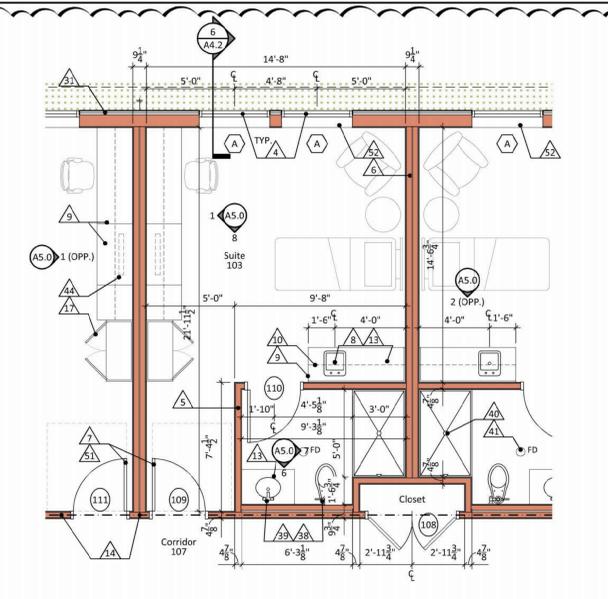

3 TYPICAL SUITE 103 - ENLARGED PLAN - ADD ALT. #1
SCALE: 1/4" = 1'-0"

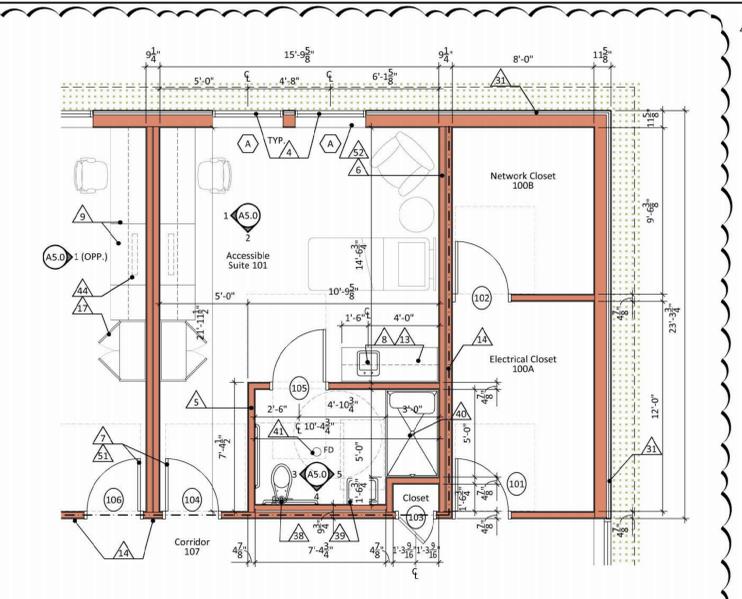

4 ACCESSIBLE SUITE 101 - ENLARGED PLAN - ADD ALT. #1
SCALE: 1/4" = 1'-0"

PLAN KEYNOTES

- 1. Protect existing building from damage.
- 2. 2 hour fire-rated wall construction per UL Design No. 9914 - 1/2" type x gypsum board on furring channels at 24" O.C., braced as required. Studs shall run to underside of roof deck. Apply fire-rated sealant at perimeter and at all penetrations.
- 3. New 36" x 96" aluminum storefront entrance door with exit hardware, closer, weatherstripping, and threshold. Connect to access control security system.
- 4. Storefront window system, see WINDOW SCHEDULE.
- 5. New wall construction: 1/2" type x gypsum board on both sides of 3" steel stud framing at 16" O.C., insulate - braced as required.
- 6. New 9" acoustic separation wall construction between suites - 1/2" type x gypsum board, 3" steel stud framing at 16" O.C. extended to roof deck above. 3" steel stud framing at 16" O.C. extended to roof deck above. 1/2" type x gypsum board, insulate - braced as required.
- 7. Door and frame, see DOOR SCHEDULE.
- 8. New hand-wash sink, see PLUMBING.
- 9. Base cabinets, see Detail -/A5.2.
- 10. Upper cabinets, see Detail -/A5.2.
- 11. Printer (N.I.C.), see ELECTRICAL for power requirements.
- 12. Plastic laminate-clad counter.
- 13. Solid surface countertop.
- 14. Dashed line indicates 1 hour smoke compartment wall construction per UL Design No. U465 - 1/2" type x gypsum board on both sides of 3" steel stud framing at 16" O.C., insulate - braced as required. Studs shall run to underside of roof deck, seal between studs and roof deck.
- 15. New wall construction to fill opening left by relocated thru-wall hvac unit. Match 2 hour fire-rated wall construction.
- 16. Relocated thru-wall hvac unit. Coordinate reinstallation with LaSalle Nursing Home administrators. Extend and reconnect all utilities.
- 17. New full height wall cabinets.
- 18. Align new wall construction with existing wall construction.
- 19. Relocated storm drain catch basin, see CIVIL.
- 20. Relocated hose bibb.
- 21. Furr out around existing column.
- 22. Replace existing cabinets with new laminate clad cabinets.
- 23. New workstation counter and drawer base cabinet.
- 24. New wall construction to fill opening left by window removal. 1/2" type x gypsum board on both sides of 3" steel stud framing at 16" O.C., insulate - braced as required. Studs shall run to underside of roof deck.
- 25. New location for oxygen/suction medical gas system.
- 26. New wall construction at opening created by removal of portion of scored masonry block wall.
- 27. Existing MRI trailer to remain. Protect from damage.
- 28. Light fixture, see ELECTRICAL.
- 29. Landscape by others.
- 30. Exterior wall-mounted, channel letter sign. See ELECTRICAL for lighting information. Contractor to provide all necessary concealed support/ blocking behind metal siding. Water tight connections at all penetrations.
- 31. New metal siding, wall panels by MBCI, or approved equal. See building elevations for pattern.
- 32. Electromagnetic door holder device connected to fire alarm system.
- 33. Infill opening with scored masonry block, align new and existing coursing, paint to match existing. Interior face of opening to be filled with metal stud wall construction covered with 1/2" type x gypsum board, painted.
- 34. New medical whiteboard by others, (N.I.C.). Contractor to provide all necessary blocking in wall.
- 35. File drawers with pull and hanging file hardware.
- 36. Smoke compartment to have sprinkler protection.
- 37. Install new clerestory window in patient room to meet daylighting requirements. See Detail 3/A4.2.
- 38. New plumbing fixture, see PLUMBING.
- 39. New sink, see PLUMBING.
- 40. New shower, see PLUMBING.
- 41. Floor drain, see PLUMBING.
- 42. Millwork/casework, see Sheet A5.0 for INTERIOR ELEVATIONS.
- 43. Transition at floor material change, see SPECIFICATIONS.
- 44. TV/Monitor location (N.I.C.), see ELECTRICAL for power/data requirements.
- 45. New aluminum storefront system with safety glazing where required by Code.
- 46. Prefinished brake metal, match storefront finish.
- 47. Spandrel glazing, this section.
- 48. Furr out wall as required.
- 49. Relocated existing telemetry equipment.
- 50. Relocated existing nurse call equipment.
- 51. Heavy duty automatic door bottom for acoustic soundproofing at each suite door, see SPECIFICATIONS.
- 52. Window sill, see Detail 6/A4.2.
- 53. Existing 2 hour fire-rated wall construction at stairs.
- 54. Existing 2 hour fire-rated wall construction.
- 55. Install new stainless steel grab bars around perimeter of Physical Therapy space where shown. Provide necessary blocking in walls.
- 56. Clear floor space designated for crash cart placement. Crash carts provided by Owner (N.I.C.).
- 57. 2 hour fire-rated wall construction per UL Design No. U425. Studs shall run to underside of roof deck. Apply fire-rated sealant at perimeter and at all penetrations. Rated wall shall extend 10'-0" minimum from Nursing Home exterior wall.

ASHE | BROUSSARD | WEINZITTE
ARCHITECTS

This drawing and design are the property of Ashe Broussard Weinzitte Architects. They are submitted on the condition that they are not to be used, reproduced, or copied, in whole or in part, or used for furnishing information to others, without the prior written consent of Ashe Broussard Weinzitte Architects. All common law rights of copyright and otherwise are hereby specifically reserved.

JAMES D. WEINZITTE
REGISTERED ARCHITECT
NO. 3884
STATE OF LOUISIANA
02.07.2025


REVISIONS

revision	description	date
1	Addendum No. One	10.15.25

LASALLE GENERAL HOSPITAL
Workforce Capacity and Medical Access Project
EDA No. 08-79-0595
187 Ninth St. Jena, Louisiana 71342

project no. 2024.01
drawn: KPL
checked: JDW
project date: FEB 2025
drawing no.

FLOOR PLAN & ENLARGED PLANS AT FIRST FLOOR PHYSICIAN'S WING
A2.0

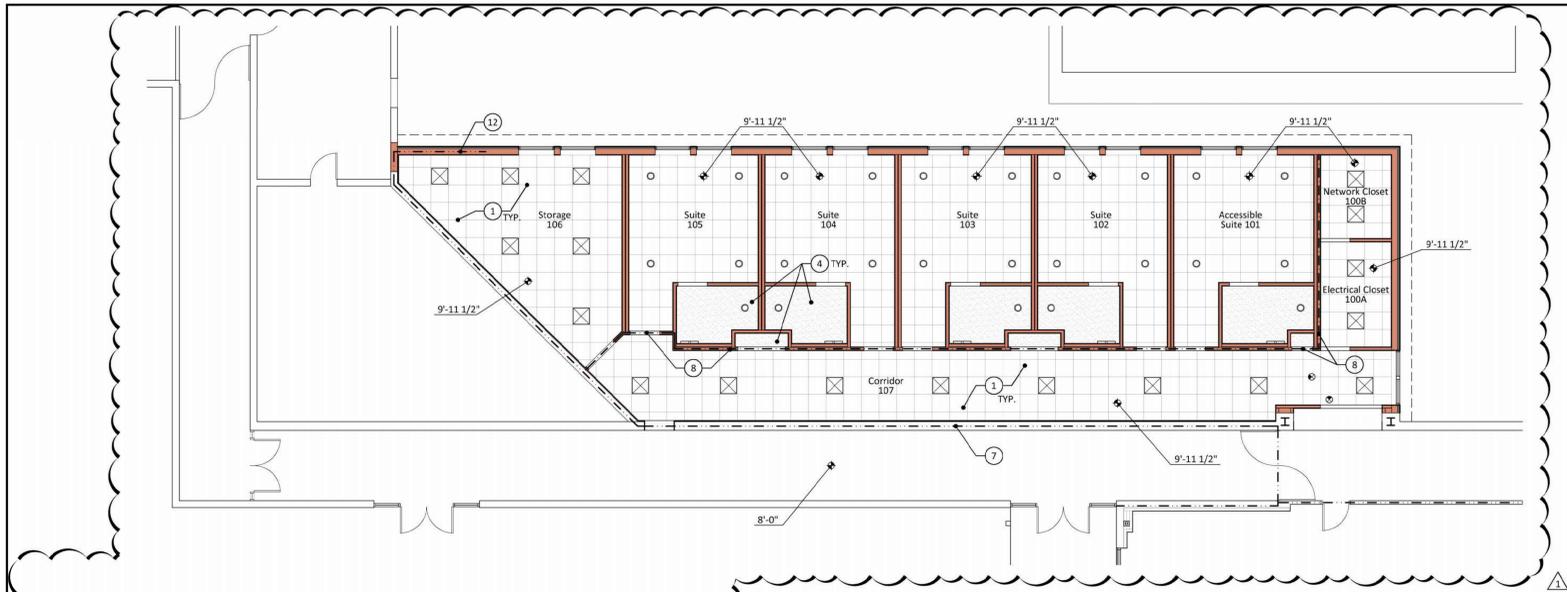

1 REFLECTED CEILING PLAN - FIRST FLOOR - ADD ALT. #1
SCALE: 1/8" = 1'-0"

KEYNOTES

- 1 Acoustical ceiling tiles, Armstrong 3821 24"x 24" tile in Armstrong Supreme A1 Fire Guard, exposed tee grid, or approved equal.
- 2 Existing ceiling and light fixtures to remain.
- 3 Adjust existing ceiling grid and fixtures within reworked space. Replace any damaged ceiling tiles.
- 4 Painted moisture-resistant gypsum board ceiling within bathrooms shall be refinished/repared as required.
- 5 Furr down as indicated, 5/8" gypsum board, painted, on metal stud framing at 16" O.C. Framing must be stable and secure. Attach to structural framing above.
- 6 Recessed LED can fixture, see ELECTRICAL.
- 7 2 hour fire-rated wall construction per UL Design No. U914; 1" type x gypsum board on furring channels at 24" O.C. placed as required. Studs shall run to underside of roof deck. Apply fire-rated sealant at perimeter and at all penetrations.
- 8 Dashed line indicates 1 hour smoke compartment wall construction per UL Design No. U465; 5/8" type x gypsum board on both sides of 3" steel stud framing at 16" O.C., insulate - braced as required. Studs shall run to underside of roof deck.
- 9 Existing 2 hour fire-rated wall construction at stairs.
- 10 Existing 1 hour smoke compartment wall construction.
- 11 Open to clerestory above.
- 12 2 hour fire-rated wall construction per UL Design No. U425. Studs shall run to underside of roof deck. Apply fire-rated sealant at perimeter and at all penetrations. Rated wall shall extend 10'-0" minimum from Nursing Home exterior wall.

RCP LEGEND

- 2' X 2' lay-in acoustical tile and grid. Refer to FINISH SCHEDULE for type and height.
- Recessed LED fixture, see ELECTRICAL.
- 2' X 2' Recessed LED fixture, see ELECTRICAL.
- Air Diffuser, see MECHANICAL.
- Return air grille, see MECHANICAL.
- Surface mounted LED fixture (over lavatory mirror), see ELECTRICAL.
- LED downlight fixture, see ELECTRICAL.
- Exit sign, see ELECTRICAL.

ASHE | BROUSSARD | WEINZETTLE ARCHITECTS

This drawing and design are the property of Ashe Broussard Weinzettle Architects. They are submitted on the condition that they are not to be used, reproduced, or copied, in whole or in part, or used for furnishing information to others, without the prior written consent of Ashe Broussard Weinzettle Architects. All common law rights of copyright and otherwise are hereby specifically reserved.

JAMES D. WEINZETTLE
No. 3584
STATE OF LOUISIANA
REGISTERED ARCHITECT
02.07.2025

REVISIONS

revision	description	date
1	Addendum No. One	10.15.25

LASALLE GENERAL HOSPITAL
Workforce Capacity and Medical Access Project
EDA No. 08-79-05595
187 Ninth St. Jena, Louisiana 71342


project no. 2024.01
drawn KPL
checked JDW
project date FEB 2025
sheet contents REFLECTED CEILING PLANS
drawing no. **A2.2**




2 REFLECTED CEILING PLAN - SECOND FLOOR
SCALE: 1/8" = 1'-0"

ROOF KEYNOTES


- 1 See STRUCTURAL.
- 2 New prefinished aluminum fascia, FW-120 panel by MBI or approved equal, to match existing in color and size.
- 3 Two (2) layers of 1 1/2" polyiso insulation board. Stagger panel layout.
- 4 Fully adhered, 2-ply SBS modified bitumen roofing system at new addition. Install per manufacturer's instructions, see SPECIFICATIONS.
- 5 3" (R-11) batt insulation.
- 6 1" exterior gypsum board (Densglass) on suspended metal furring, acrylic stucco finish over.
- 7 3" x 25 gauge metal studs at 16" O.C.
- 8 6", 25 gauge metal studs at 16" O.C.
- 9 6" (R-19) batt insulation.
- 10 1/2" cover board.
- 11 Create 48" x 48" sump area using 1 1/2" x 18" tapered insulation edge strips, trimmed to fit slope or use prefabricated faced insulation sump panel.
- 12 3/4" galvanized hat channel at 16" O.C.
- 13 Prefinished metal coping. See SPECIFICATIONS.
- 14 Cut edge sealant by roof manufacturer.
- 15 Seal roofing membrane down face of nailer.
- 16 Turn roofing membrane down face of nailer.
- 17 Hem flashing edge, 3" typical.
- 18 Prefinished metal scupper, extend under roof edge flashing and flash as per roof manufacturer typical detail.
- 19 Existing built-up roof to remain.
- 20 New 5" cant strip at roof to wall (or parapet) transition.
- 21 Continuous treated 2X nailer.
- 22 1 1/2" corrugated metal roof deck. See STRUCTURAL.
- 23 Welded steel angle framing. See STRUCTURAL.
- 24 Strainer basket.
- 25 Compression ring.
- 26 Secure flange to deck with minimum four (4) pan head screws spaced at 12" O.C. maximum.
- 27 6" PVC roof drain piping.
- 28 Existing construction shown approximate. Verify at site.
- 29 Prefinished metal flashing, dimensions to fit location. Close open ends.
- 30 3/4" exterior grade plywood.
- 31 Existing flashing to remain. Protect from damage when tucking new flashing behind existing.
- 32 Saw cut into existing masonry joint, install prefinished metal flashing, wedge tight, and seal around flashing penetration.
- 33 Silicone sealant with backer rod.
- 34 Treated wood blocking as required.
- 35 Treated 2x4 bottom plate, secure to deck.
- 36 Treated 2x6.
- 37 Metal support clip. See STRUCTURAL.
- 38 Hex head cap screw with EPDM washer.
- 39 Cricket from roof insulation to fit location, slope at 3/4" per foot.
- 40 New clerestory lantern for Swing Room 220NP.
- 41 Tapered rigid roof insulation, 3/4" per 1'-0" slope.
- 42 1 1/2" polyiso insulation board.
- 43 Sealant (mastic) by roofing manufacturer. Included in roofing system.
- 44 Fasten at 3" O.C., staggered 1/2" 1 1/2" ring shank roofing nails, min.
- 45 Simpson Titen stainless steel screw (or approved equal) 1/4" x 2" at 36" O.C.
- 46 Simpson Titen stainless steel screw, or approved equal, 1/4" x 2" at 36" O.C.
- 47 Continuous 22 ga. galvanized steel cleat, 45° angle kick at bottom, attach at 6" O.C. 1 1/4" roofing nails, min.
- 48 2 hour fire-rated wall construction per UL Design No. U934; 1/2" type X gypsum board on furring channels at 24" O.C. braced as required. Studs shall run to underside of roof deck. Apply fire-rated sealant at perimeter and at all penetrations.
- 49 New section of fully adhered, 2-ply SBS modified bitumen roofing system at clerestory lantern.
- 50 Install termination bar and sealant at end of membrane, typical.
- 51 Standard roofing membrane flashing system.
- 52 Cant strip, as per roofing manufacturer.
- 53 Prefinished metal counter-flashing.

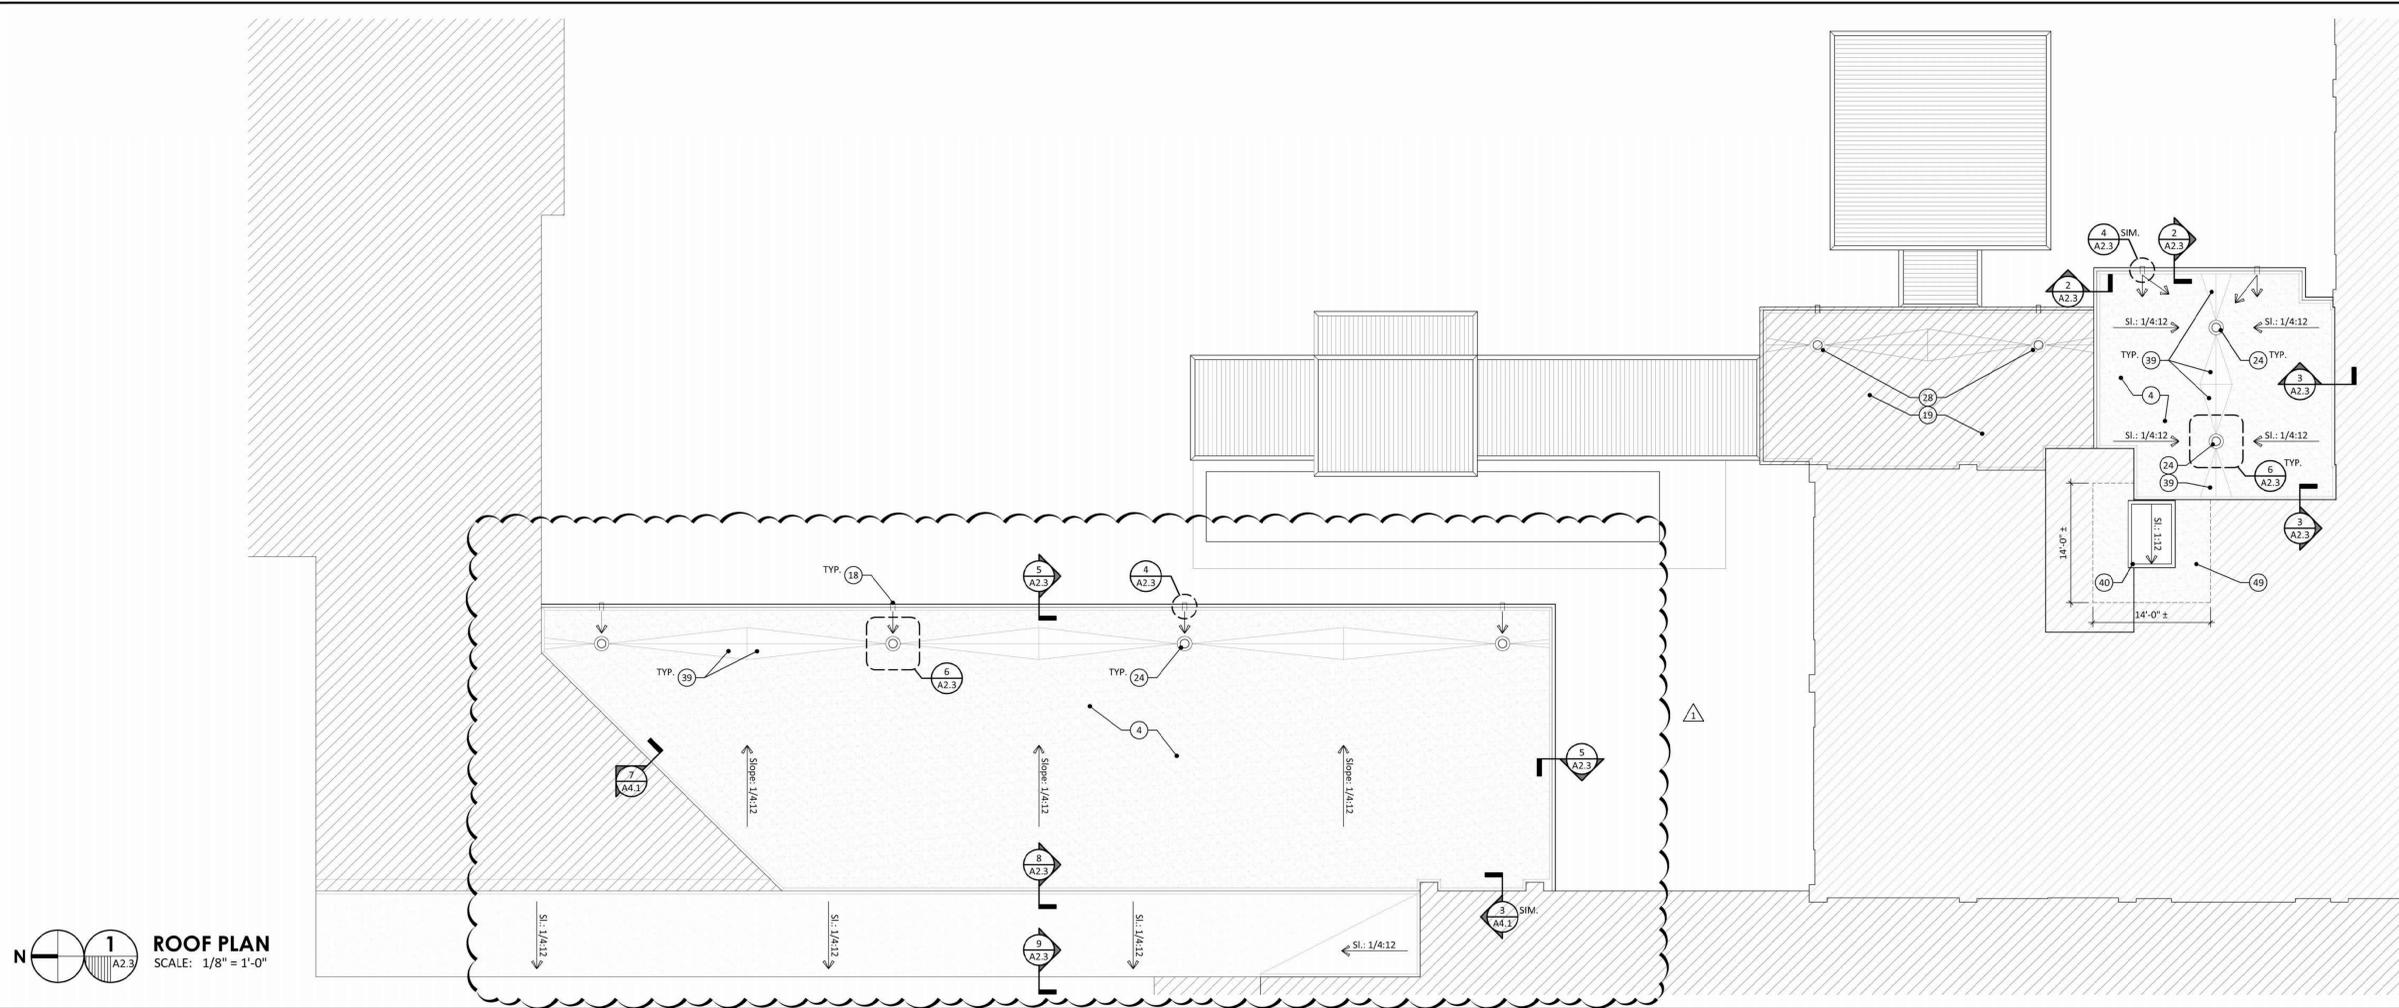


1 ROOF PLAN
SCALE: 1/8" = 1'-0"

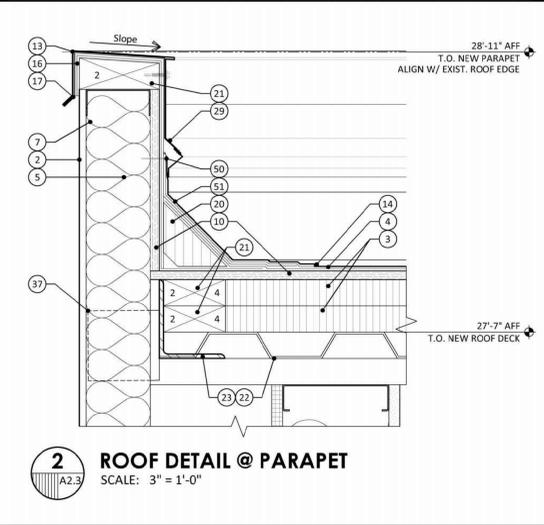


2 ROOF DETAIL @ PARAPET
SCALE: 3" = 1'-0"

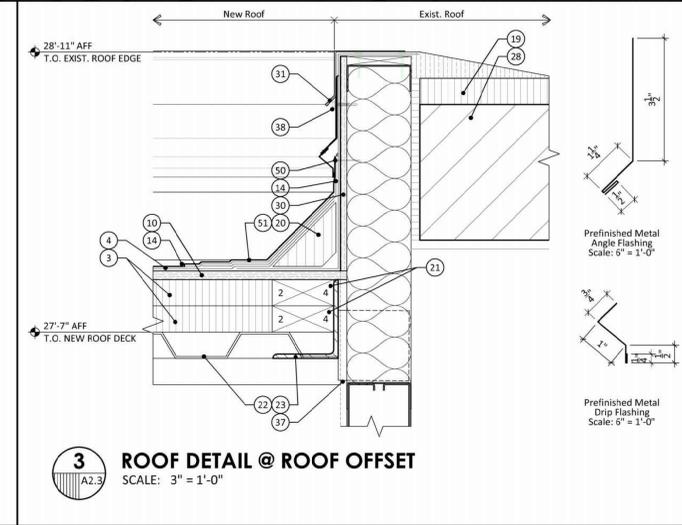


3 ROOF DETAIL @ ROOF OFFSET
SCALE: 3" = 1'-0"

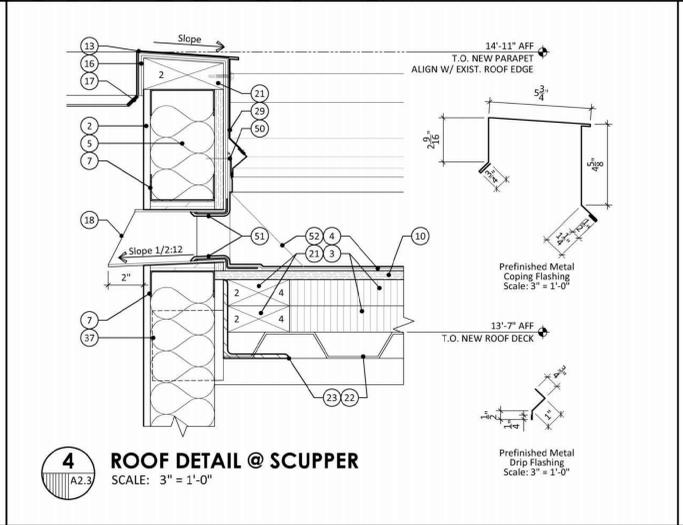


4 ROOF DETAIL @ SCUPPER
SCALE: 3" = 1'-0"

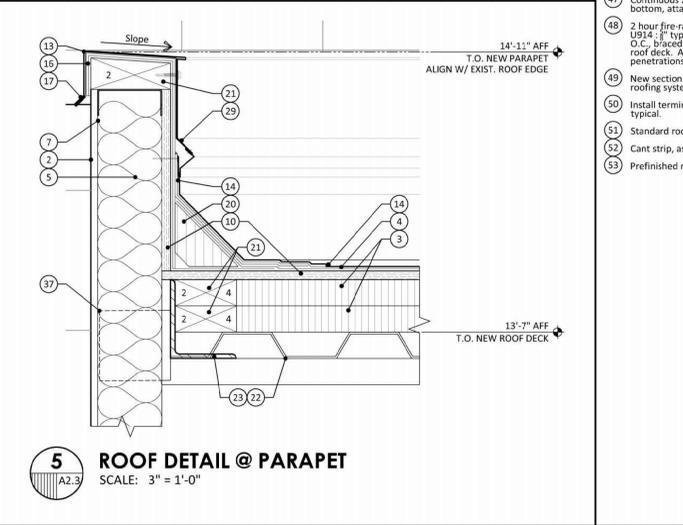


5 ROOF DETAIL @ PARAPET
SCALE: 3" = 1'-0"

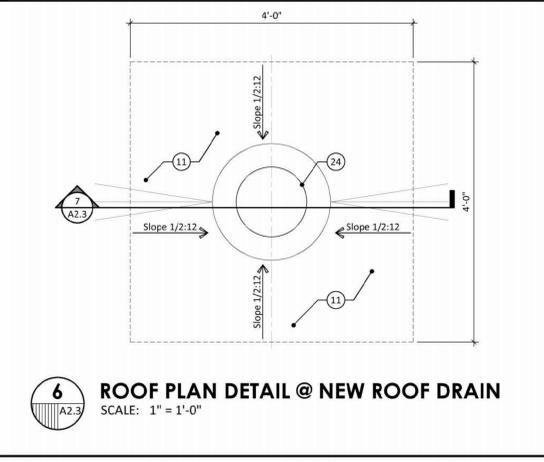


6 ROOF PLAN DETAIL @ NEW ROOF DRAIN
SCALE: 1" = 1'-0"

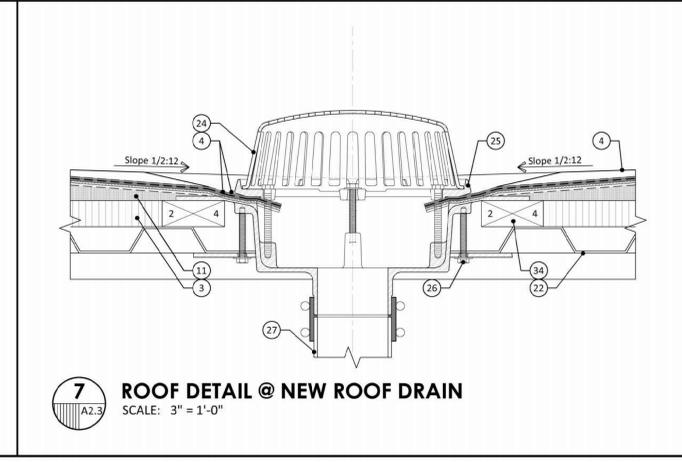

7 ROOF DETAIL @ NEW ROOF DRAIN
SCALE: 3" = 1'-0"

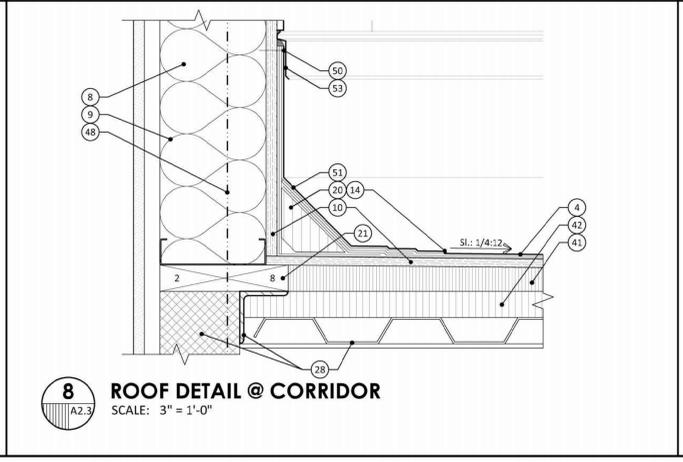

8 ROOF DETAIL @ CORRIDOR
SCALE: 3" = 1'-0"

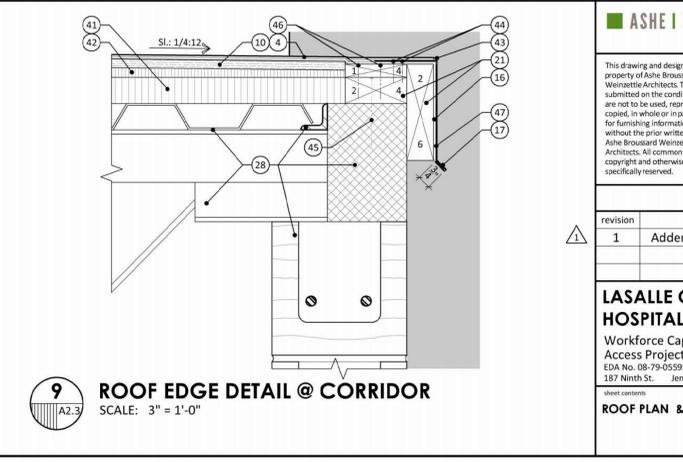

9 ROOF EDGE DETAIL @ CORRIDOR
SCALE: 3" = 1'-0"

ASHE | BROUSSARD | WEINZETTLE ARCHITECTS

This drawing and design are the property of Ashe Broussard Weinzettle Architects. They are submitted on the condition that they are not to be used, reproduced, or copied, in whole or in part, or used for furnishing information to others, without the prior written consent of Ashe Broussard Weinzettle Architects. All common law rights of copyright and otherwise are hereby specifically reserved.

REVISIONS

revision	description	date
1	Addendum No. One	10.15.25

LASALLE GENERAL HOSPITAL
Workforce Capacity and Medical Access Project
EDA No. 08-79-05595
187 Ninth St. Jena, Louisiana 71342

project no. 2024.01
drawn KPL
checked JDW
project date FEB 2025
sheet contents

A2.3

FINISH SCHEDULE

Note: For detailed information on Finish Description such as LVT, VCT, etc. refer to Specifications.





ROOM NUMBER	NAME	FLOOR	BASE	WALLS	CEILING	CEILING HEIGHT	CEILING MOLD	REMARKS
100A	Electrical Closet	Ceramic Tile	Rubber Base	Painted Gypsum Board	ACT	9'-11 1/2"	None	
100B	Network Closet	Ceramic Tile	Rubber Base	Painted Gypsum Board	ACT	9'-11 1/2"	None	
101	Accessible Suite	VCT	Rubber Base	Painted Gypsum Board	ACT	9'-11 1/2"	None	
102	Accessible Suite RR	VCT	Rubber Base	Painted Gypsum Board	Painted Gypsum Board	9'-11 1/2"	None	
103	Suite	VCT	Rubber Base	Painted Gypsum Board	ACT	9'-11 1/2"	None	
103	Suite RR	VCT	Rubber Base	Painted Gypsum Board	Painted Gypsum Board	9'-11 1/2"	None	
104	Suite	VCT	Rubber Base	Painted Gypsum Board	ACT	9'-11 1/2"	None	
104	Suite RR	VCT	Rubber Base	Painted Gypsum Board	Painted Gypsum Board	9'-11 1/2"	None	
105	Suite	VCT	Rubber Base	Painted Gypsum Board	ACT	9'-11 1/2"	None	
105	Suite RR	VCT	Rubber Base	Painted Gypsum Board	Painted Gypsum Board	9'-11 1/2"	None	
106	Storage	VCT	Rubber Base	Painted Gypsum Board	ACT	9'-11 1/2"	None	
107	Corridor	Ceramic Tile	Rubber Base	Painted Gypsum Board	ACT	9'-11 1/2"	None	
200	Nurse Station	Ceramic Tile	Rubber Base	Painted Gypsum Board	ACT	8'-0"	None	
200A	Staff Lounge	Ceramic Tile	Rubber Base	Painted Gypsum Board	ACT	8'-0"	None	
200B	Training Room	Carpet Tile	Rubber Base	Painted Gypsum Board	ACT	8'-0"	None	
200C	Discharge Planning	Ceramic Tile	Rubber Base	Painted Gypsum Board	ACT	8'-0"	None	
200D	Medical Staff	Carpet Tile	Rubber Base	Painted Gypsum Board	ACT	8'-0"	None	
200E	Dictation	Carpet Tile	Rubber Base	Painted Gypsum Board	ACT	8'-0"	None	
200F	Med Prep	Ceramic Tile	Rubber Base	Painted Gypsum Board	ACT	8'-0"	None	
200G	Staff RR	Ceramic Tile	Rubber Base	Painted Gypsum Board	Painted Gypsum Board	8'-0"	None	
201	Accessible Patient Room	VCT	Rubber Base	Painted Gypsum Board	ACT	8'-0"	None	
201	Accessible Patient RR	VCT	Rubber Base	Painted Gypsum Board	Painted Gypsum Board	8'-0"	None	
202	Patient Room	VCT	Rubber Base	Painted Gypsum Board	ACT	8'-0"	None	
202	Patient RR	VCT	Rubber Base	Painted Gypsum Board	Painted Gypsum Board	8'-0"	None	
203	Patient Room	VCT	Rubber Base	Painted Gypsum Board	ACT	8'-0"	None	
203	Patient RR	VCT	Rubber Base	Painted Gypsum Board	Painted Gypsum Board	8'-0"	None	
204	Patient Room	VCT	Rubber Base	Painted Gypsum Board	ACT	8'-0"	None	
204	Patient RR	VCT	Rubber Base	Painted Gypsum Board	Painted Gypsum Board	8'-0"	None	
205	Patient Room	VCT	Rubber Base	Painted Gypsum Board	ACT	8'-0"	None	
228	Storage	VCT	Rubber Base	Painted Gypsum Board	ACT	8'-0"	None	

DOOR SCHEDULE

MARK	DOOR SIZE	ELEV	DOOR DESCRIPTION	GLASS	WINDOW ELEVATION	FRAME DESCRIPTION	HARDWARE	DETAIL	FIRE RATING	REMARKS
100	3'-0" x 8'-0" x 1 1/2"	B	Aluminum, storefront, entrance	Type 2	J - Dtl. 3/A2.4	Aluminum, storefront	4		None	Access control system by others
101	3'-0" x 8'-0" x 1 1/2"	A	Wood veneer, flush, solid core, stain	None		Hollow metal, paint	3	2/A2.4	None	
102	3'-0" x 8'-0" x 1 1/2"	A	Wood veneer, flush, solid core, stain	None		Hollow metal, paint	3	2/A2.4	None	
103	2'-0" x 8'-0" x 1 1/2"	A	Wood veneer, flush, solid core, stain	None		Hollow metal, paint	3		20 min.	Door and Frame to have 20 minute Fire Rating
104	3'-0" x 8'-0" x 1 1/2"	A	Wood veneer, flush, solid core, stain	None		Hollow metal, paint		2/A2.4	20 min.	Access control by others; Door and Frame to have 20 minute Fire Rating
105	3'-0" x 8'-0" x 1 1/2"	A	Wood veneer, flush, solid core, stain	None		Hollow metal, paint	2	2/A2.4	None	
106	3'-0" x 8'-0" x 1 1/2"	A	Wood veneer, flush, solid core, stain	None		Hollow metal, paint		2/A2.4	20 min.	Access control by others; Door and Frame to have 20 minute Fire Rating
107	3'-0" x 8'-0" x 1 1/2"	A	Wood veneer, flush, solid core, stain	None		Hollow metal, paint	2	2/A2.4	None	
108	Pair of 2'-6" x 8'-0" x 1 1/2"	C	Wood veneer, flush, solid core, stain	None		Hollow metal, paint	3	2/A2.4	20 min.	Double Door and Frame to have 20 minute Fire Rating
109	3'-0" x 8'-0" x 1 1/2"	A	Wood veneer, flush, solid core, stain	None		Hollow metal, paint		2/A2.4	20 min.	Access control by others; Door and Frame to have 20 minute Fire Rating
110	3'-0" x 8'-0" x 1 1/2"	A	Wood veneer, flush, solid core, stain	None		Hollow metal, paint	2	2/A2.4	None	
111	3'-0" x 8'-0" x 1 1/2"	A	Wood veneer, flush, solid core, stain	None		Hollow metal, paint		2/A2.4	20 min.	Access control by others; Door and Frame to have 20 minute Fire Rating
112	3'-0" x 8'-0" x 1 1/2"	A	Wood veneer, flush, solid core, stain	None		Hollow metal, paint	2	2/A2.4	None	
113	Pair of 2'-6" x 8'-0" x 1 1/2"	C	Wood veneer, flush, solid core, stain	None		Hollow metal, paint	3	2/A2.4	20 min.	Double Door and Frame to have 20 minute Fire Rating
114	3'-0" x 8'-0" x 1 1/2"	A	Wood veneer, flush, solid core, stain	None		Hollow metal, paint		2/A2.4	20 min.	Access control by others; Door and Frame to have 20 minute Fire Rating
115	3'-0" x 8'-0" x 1 1/2"	A	Wood veneer, flush, solid core, stain	None		Hollow metal, paint	2	2/A2.4	None	
116	4'-0" x 8'-0" x 1 1/2"	A	Wood veneer, flush, solid core, stain	None		Hollow metal, paint	3	2/A2.4	20 min.	Door and Frame to have 20 minute Fire Rating
117	3'-0" x 8'-0" x 1 1/2"	A	Wood veneer, flush, solid core, stain	None		Hollow metal, paint		2/A2.4	90 min.	Door and Frame to have 90 minute Fire Rating
200	3'-0" x 7'-0" x 1 1/2"	D	Wood veneer, flush, solid core, stain	Type 2	K - Dtl. 3/A2.4	Hollow metal, paint		2/A2.4	None	Access control system by others
201	3'-0" x 7'-0" x 1 1/2"	A	Wood veneer, flush, solid core, stain	None		Hollow metal, paint	2	2/A2.4	None	
202	3'-0" x 7'-0" x 1 1/2"	A	Wood veneer, flush, solid core, stain	None		Hollow metal, paint	3	2/A2.4	None	
203	3'-0" x 7'-0" x 1 1/2"	A	Wood veneer, flush, solid core, stain	None		Hollow metal, paint	2	2/A2.4	None	
204	3'-0" x 7'-0" x 1 1/2"	A	Wood veneer, flush, solid core, stain	None		Hollow metal, paint	2	2/A2.4	None	
205	3'-0" x 7'-0" x 1 1/2"	D	Wood veneer, flush, solid core, stain	Type 2	M - Dtl. 3/A2.4	Hollow metal, paint	1	2/A2.4	None	
206	4'-0" x 7'-0" x 1 1/2"	A	Wood veneer, flush, solid core, stain	None		Hollow metal, paint	1	2/A2.4	None	
207	3'-0" x 7'-0" x 1 1/2"	A	Wood veneer, flush, solid core, stain	None		Hollow metal, paint	2	2/A2.4	None	
208	3'-0" x 7'-0" x 1 1/2"	A	Wood veneer, flush, solid core, stain	None		Hollow metal, paint	2	2/A2.4	None	
209	3'-0" x 7'-0" x 1 1/2"	A	Wood veneer, flush, solid core, stain	None		Hollow metal, paint	2	2/A2.4	None	

WINDOW SCHEDULE

MARK	WINDOW SIZE	DESCRIPTION	DETAIL	GLASS	REMARKS
A	4'-0" x 9'-6"	Aluminum, storefront	6/A4.2	Type 1	Dark Bronze Anodized Finish
B	6'-2 1/2" x 9'-6"	Aluminum, storefront		Type 1	Dark Bronze Anodized Finish
C	6'-1" x 7'-11 1/2"	Aluminum, storefront	2/A4.2	Type 1	Dark Bronze Anodized Finish
D	6'-1" x 3'-4 1/2"	Aluminum, storefront	2/A4.2	Type 4	Dark Bronze Anodized Finish, Spandrel Glazing
E	7'-4" x 7'-11 1/2"	Aluminum, storefront	4/A4.1	Type 1	Dark Bronze Anodized Finish
F	3'-8" x 2'-6"	Aluminum, storefront	3/A4.2	Type 1	Dark Bronze Anodized Finish
G	5'-11" x Varies	Aluminum, storefront		Type 1	Dark Bronze Anodized Finish
H	5'-11" x Varies	Aluminum, storefront		Type 1	Dark Bronze Anodized Finish
I	6'-0" x 5'-8"	Hollow metal, paint		Type 2	
J	7'-0" x 8'-2"	Aluminum, storefront		Type 2	Dark Bronze Anodized Finish
K	4'-8" x 7'-2"	Hollow metal, paint		Type 2	
L	3'-10" x 3'-6"	Hollow metal, paint		Type 2	
M	4'-8" x 7'-2"	Hollow metal, paint		Type 2	

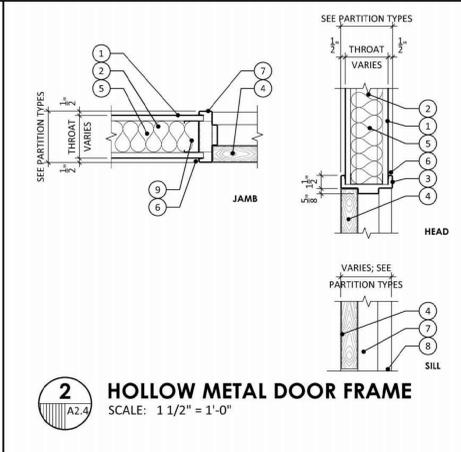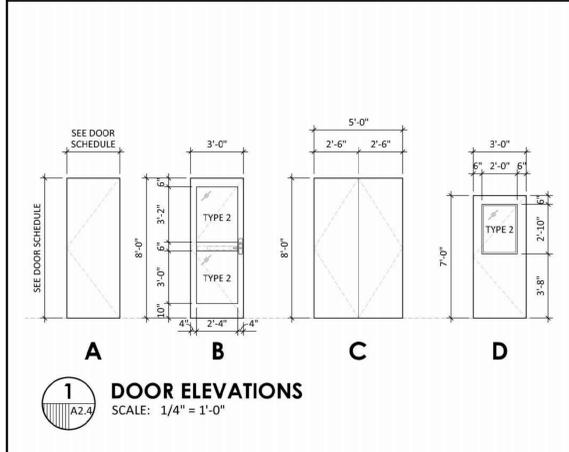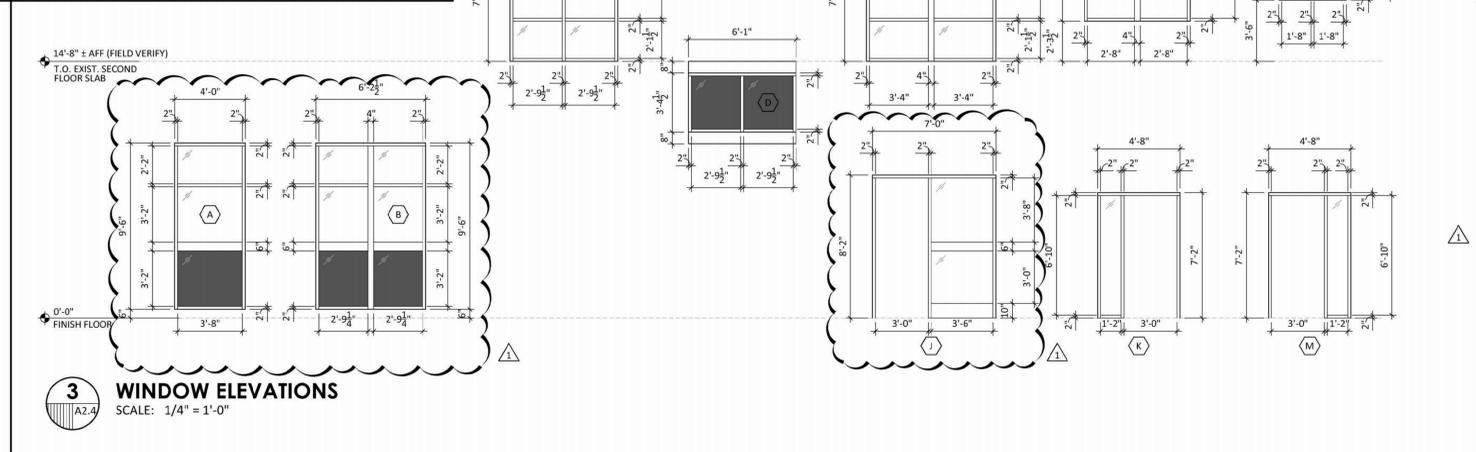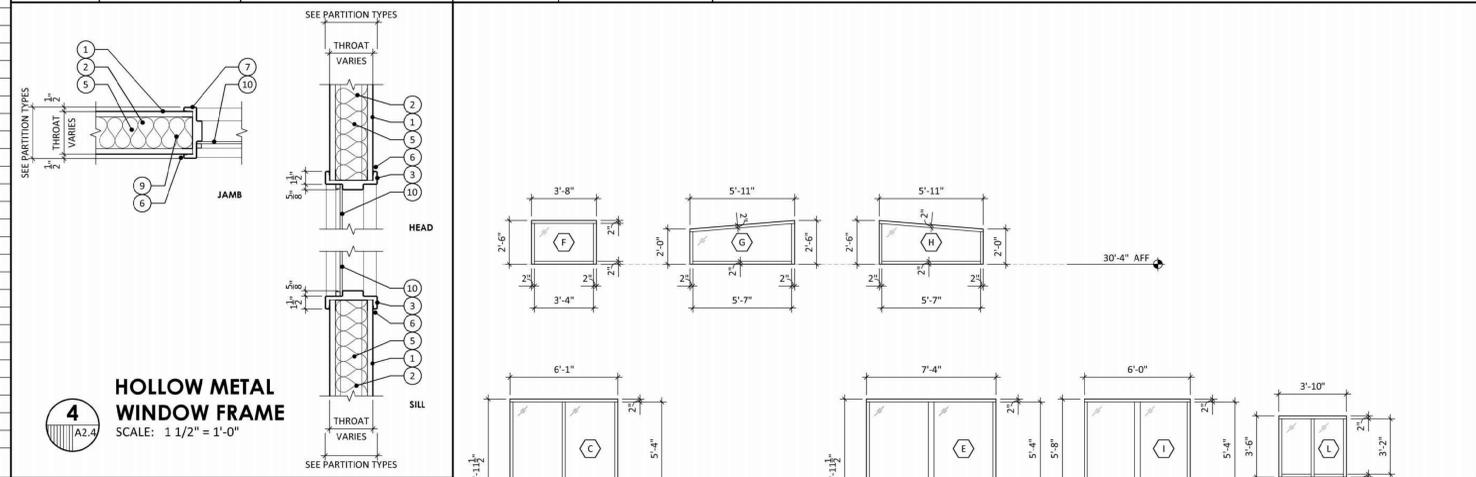

HARDWARE LEGEND

- see specifications for additional information
- NOTE 1: Passage
- NOTE 2: Privacy
- NOTE 3: Classroom
- NOTE 4: Exit devices closer
- NOTE 5: Power assisted door opener at this entrance. RE: ELECTRICAL AND SPECIFICATIONS.
- NOTE 6: Typical door undercut is 3/4"

GLASS TYPES

- see specifications for additional information
- TYPE 1: 1" Insulated Tinted, Tempered, Low E
- TYPE 2: 3/4" Clear Plate Glass in Tempered Frame, see Door for specific rating
- TYPE 3: 3/4" Clear FireLite Glass in rated frame, see Door for specific rating
- TYPE 4: Spandrel Glazing
- TYPE 5: Frosted 1" Insulated Tinted, Tempered, Low E

GENERAL GLAZING NOTES

- NOTE 1: All exterior storefront frames to have sub-base with integral flashing dams each side, no caulking dams.
- NOTE 2: Dimensions indicated are nominal, field verify and provide for shim space.
- NOTE 3: Standard dark bronze anodized color finish at all exterior and interior storefront systems. See SPECIFICATIONS. Match existing.

DETAIL KEYNOTES

- 3/8" gypsum sheathing.
- Batt insulation.
- Hollow metal frame with backend return.
- Door, see DOOR SCHEDULE.
- Metal stud.
- Sealant both sides.
- Hollow metal frame with backend return and recessed metal stud anchor.
- Finish floor.
- Metal track.
- Window, see WINDOW SCHEDULE.

ASHE | BROUSSARD | WEINZITTE ARCHITECTS


This drawing and design are the property of Ashe Broussard Weinzittle Architects. They are submitted on the condition that they are not to be used, reproduced, or copied, in whole or in part, or used for furnishing information to others, without the prior written consent of Ashe Broussard Weinzittle Architects. All common law rights of copyright and otherwise are hereby specifically reserved.

02.07.2025

revision	description	date
1	Addendum No. One	10.15.25

LASALLE GENERAL HOSPITAL
 Workforce Capacity and Medical Access Project
 ED No. 08-79-05595
 187 Ninth St. Jena, Louisiana 71342

project no. 2024.01
 drawn: KPL
 checked: JDW
 project date: FEB 2025
 sheet contents
 drawing no. **A2.4**

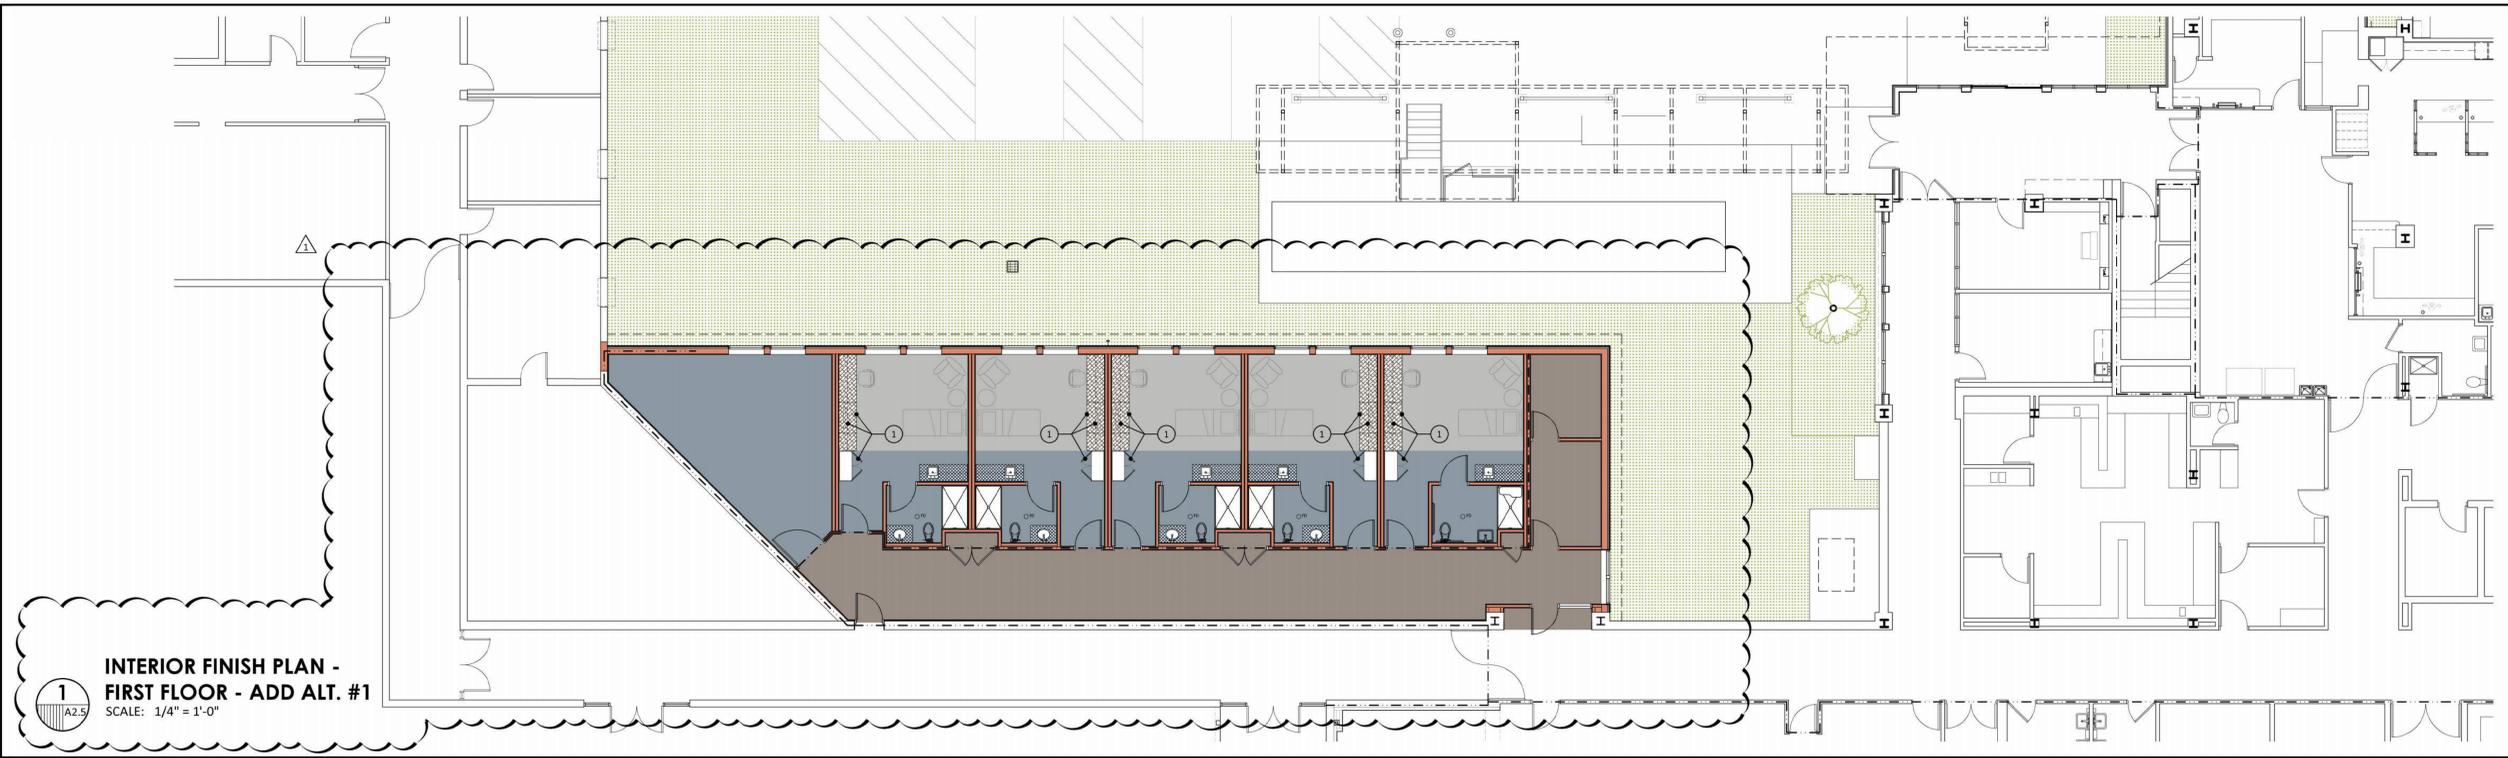

1
INTERIOR FINISH PLAN -
FIRST FLOOR - ADD ALT. #1
 SCALE: 1/4" = 1'-0"

- INTERIOR FINISHES**
 see specifications for additional information
- VCT1 - Vinyl Composition Tile No. 1 - 12" x 12" Tarkett, VCT II, color: 323 Starry Night
 - VCT2 - Vinyl Composition Tile No. 2 - 12" x 12" Tarkett, VCT II color: 557 Shooting Star
 - CT1 - Ceramic Tile No. 1 - 12" x 24" American Olean, Theoretical, color: Creative Gray
 - CT2 - Ceramic Tile No. 2 - 2" x 2" Mosaic American Olean, Theoretical, color: Creative Gray
 - CPT - Carpet Tile - 24" x 24" Mohawk, Counter Casual GT352, color: 969 Gray Wash, installation: Brick Ashlar. Anodized aluminum reducer strip at threshold
 - SSC - Solid Surface Countertop - Wilsonart, color: 9024ML French Blue Melange
 - PLC - Plastic Laminate Countertop - Wilsonart, color: 4843-60 Misted Zephyr

- INTERIOR FINISH KEYNOTES**
- ① Plastic laminate covered cabinets - Wilsonart, color: 4941K-13 Cosmic Soranitz
 - ② Plastic laminate covered cabinets - Wilsonart, color: 4651-60 Navy Legacy
 - ③



2
INTERIOR FINISH PLAN -
SECOND FLOOR
 SCALE: 1/4" = 1'-0"

ASHE | BROUSSARD | WEINZETTLE
 ARCHITECTS

This drawing and design are the property of Ashe Broussard Weinzettle Architects. They are submitted on the condition that they are not to be used, reproduced, or copied, in whole or in part, or used for furnishing information to others, without the prior written consent of Ashe Broussard Weinzettle Architects. All common law rights of copyright and otherwise are hereby specifically reserved.


JAMES D. WEINZETTLE
 No. 3584
 STATE OF LOUISIANA
 REGISTERED ARCHITECT
 02.07.2025

REVISIONS		
revision	description	date
1	Addendum No. One	10.15.25


LASALLE GENERAL HOSPITAL		project no. 2024.01
Workforce Capacity and Medical Access Project		drawn KPL
EDA No. 08-79-05595		checked JDW
187 Ninth St. Jena, Louisiana 71342		project date FEB 2025
sheet contents INTERIOR FINISH PLANS		drawing no. A2.5

ELEVATION KEYNOTES


- 1 Protect existing building from damage.
- 2 New aluminum storefront system with safety glazing.
- 3 New prefinished aluminum fascia, FW-120 Panel by MBCI or approved equal, to match existing in color and size.
- 4 New metal siding, Masterline 16 Wall Panel by MBCI, or approved equal.
- 5 New metal siding, FW-120 Wall Panel by MBCI, or approved equal.
- 6 Brake metal anodized aluminum trim.
- 7 Existing prefinished aluminum fascia, prefinished.
- 8 Existing scored masonry block.
- 9 Existing MRI Trailer to remain, protect from damage.
- 10 Prefinished metal scupper.
- 11 Exterior wall-mounted, channel letter sign. See ELECTRICAL for lighting information. Contractor to provide all necessary concealed support/ blocking behind metal siding.
- 12 Spandrel glazing, this section.
- 13 Landscape by others (N.I.C.).
- 14 Transition sleeve from downspout to neoprene boot connection, refer to CIVIL drawing C2.0 for detail. Provide weathertight seal at wall from downspout to transition sleeve.
- 15 Install metal closure termination strip to seal at transition between panel types. Metal closure termination strip by MBCI, or approved equal.

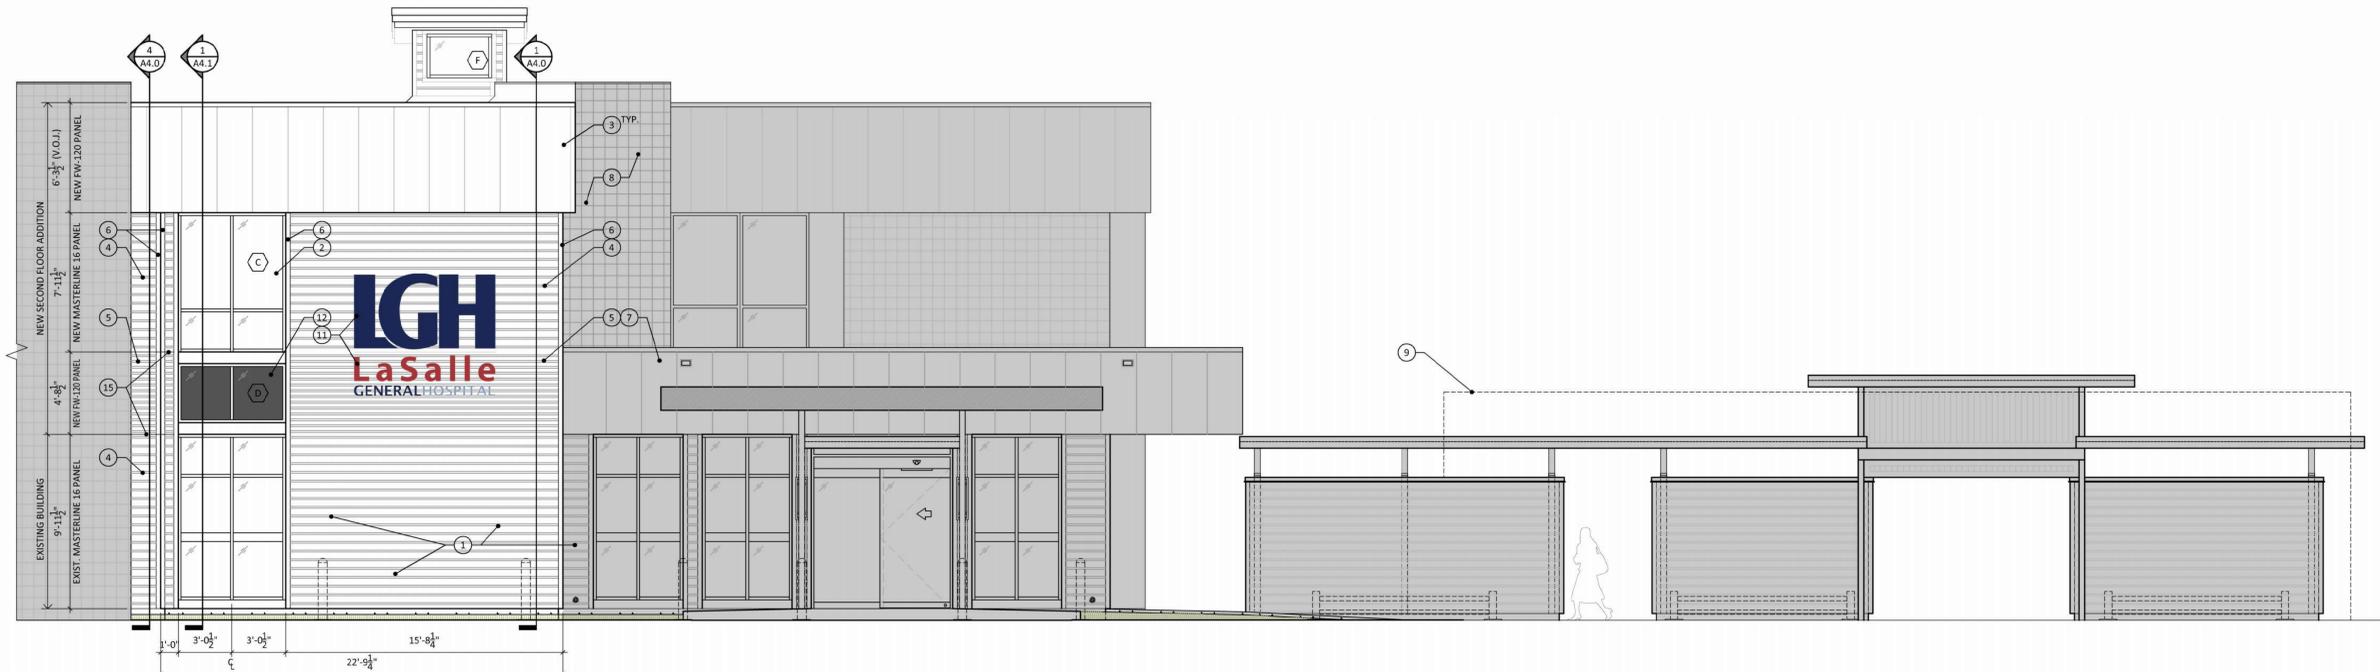


1 EAST ELEVATION - SECOND FLOOR ADDITON
SCALE: 1/4" = 1'-0"

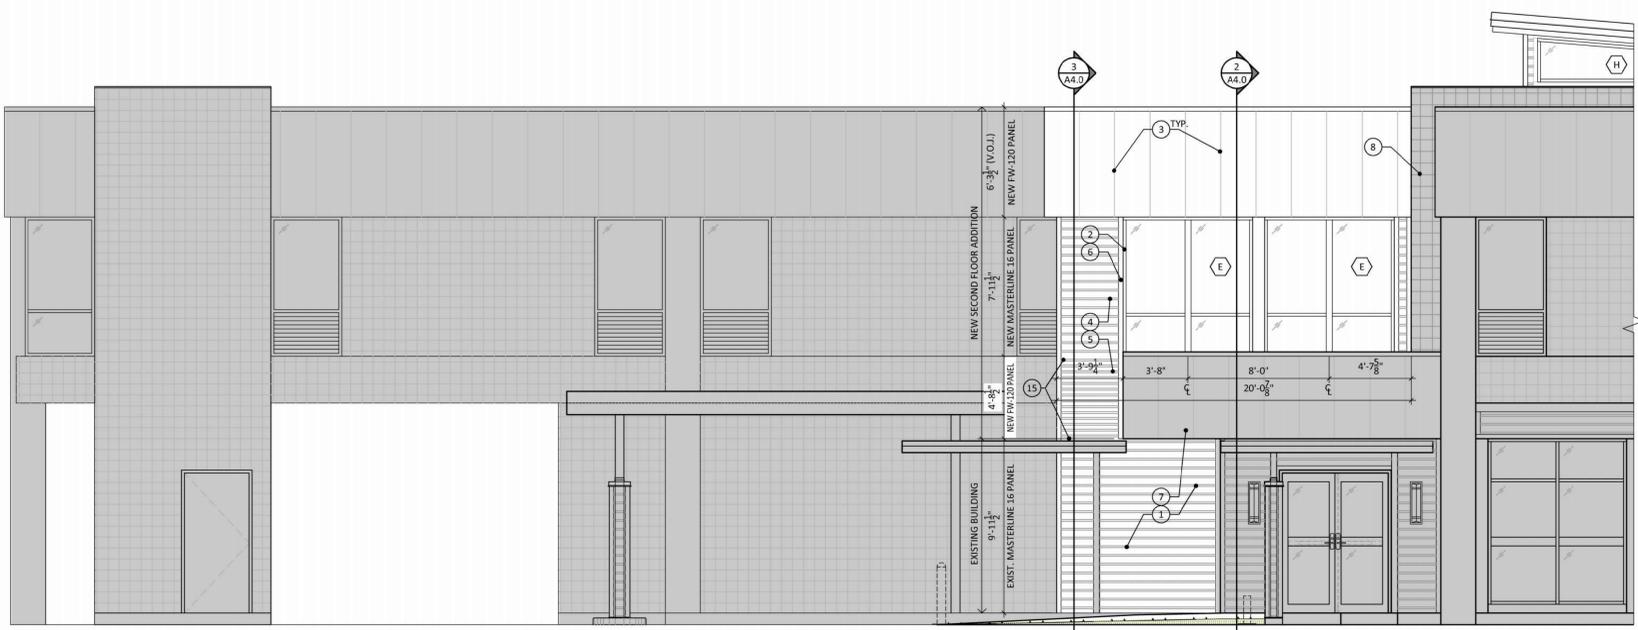

2 NORTH ELEVATION - SECOND FLOOR ADDITION
SCALE: 1/4" = 1'-0"

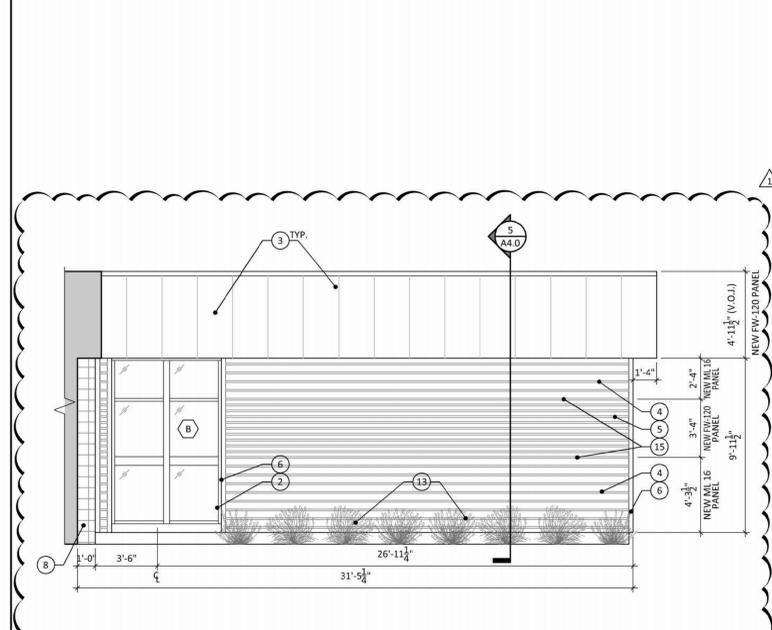

3 SOUTH ELEVATION - PHYSICIAN'S WING - ADD ALT. #1
SCALE: 1/4" = 1'-0"

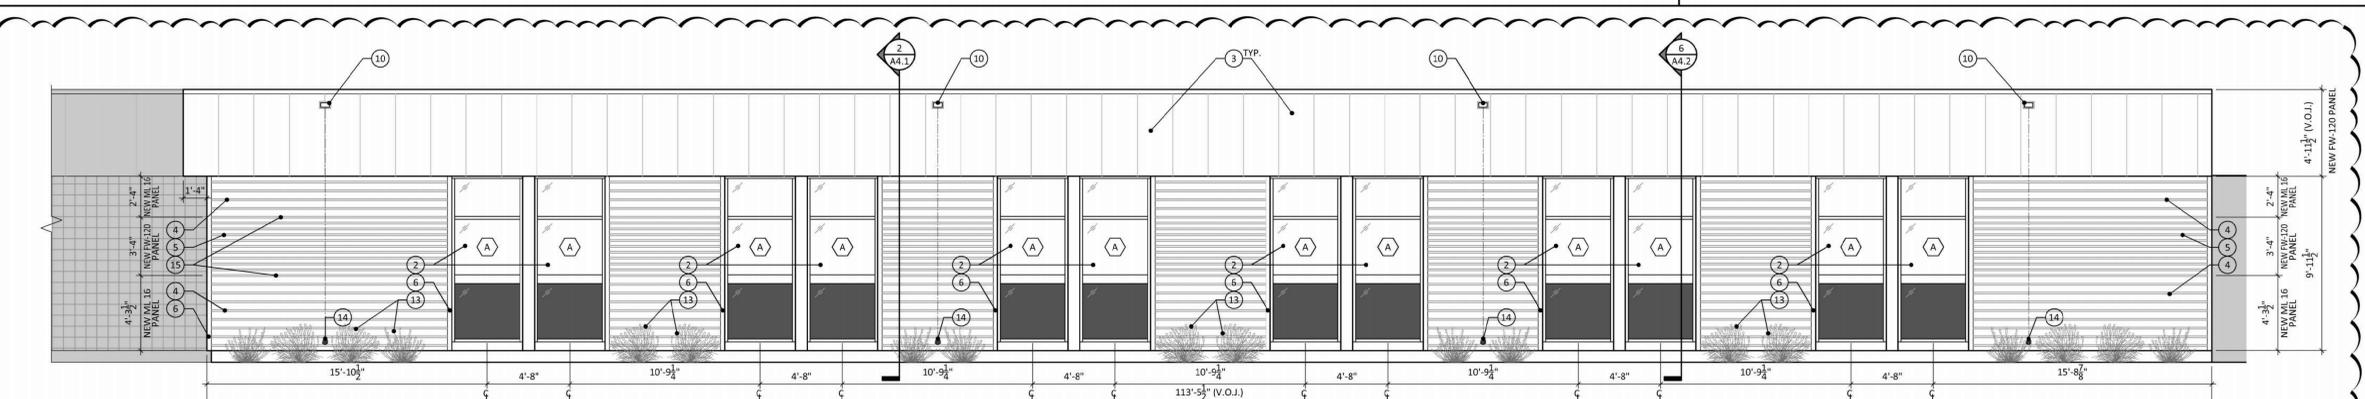

4 EAST ELEVATION - PHYSICIAN'S WING - ADD ALT. #1
SCALE: 1/4" = 1'-0"

ASHE | BROUSSARD | WEINZITTEL ARCHITECTS

This drawing and design are the property of Ashe Broussard Weinzittel Architects. They are submitted on the condition that they are not to be used, reproduced, or copied, in whole or in part, or used for furnishing information to others, without the prior written consent of Ashe Broussard Weinzittel Architects. All common law rights of copyright and otherwise are hereby specifically reserved.


JAMES D. WEINZITTEL
No. 3884
STATE OF LOUISIANA
REGISTERED ARCHITECT
02.07.2025

REVISIONS		
revision	description	date
1	Addendum No. One	10.15.25


LASALLE GENERAL HOSPITAL
Workforce Capacity and Medical Access Project
EDA No. 08-79-05595
187 Ninth St. Jena, Louisiana 71342

project no. 2024.01
drawn KPL
checked JDW
project date FEB 2025
sheet contents drawing no. A3.0


EXTERIOR ELEVATIONS

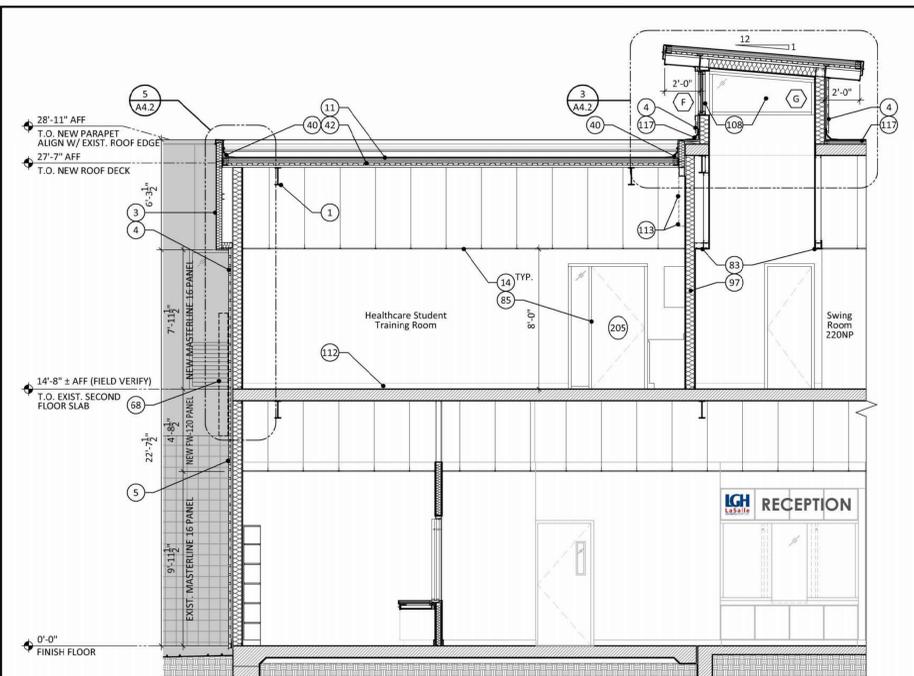


1 SECTION @ HEALTHCARE STUDENT TRAINING ROOM & SWING ROOM 220NP
SCALE: 1/4" = 1'-0"

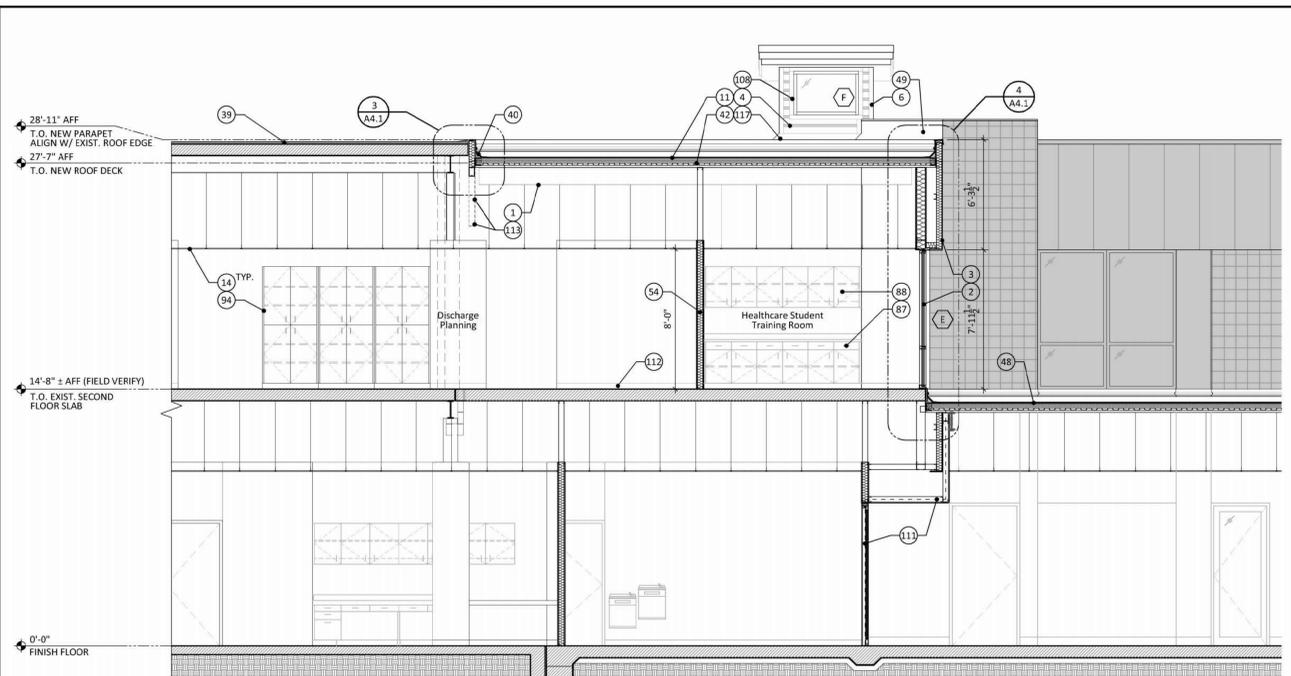

2 SECTION @ DISCHARGE PLANNING & HEALTHCARE STUDENT TRAINING ROOM
SCALE: 1/4" = 1'-0"

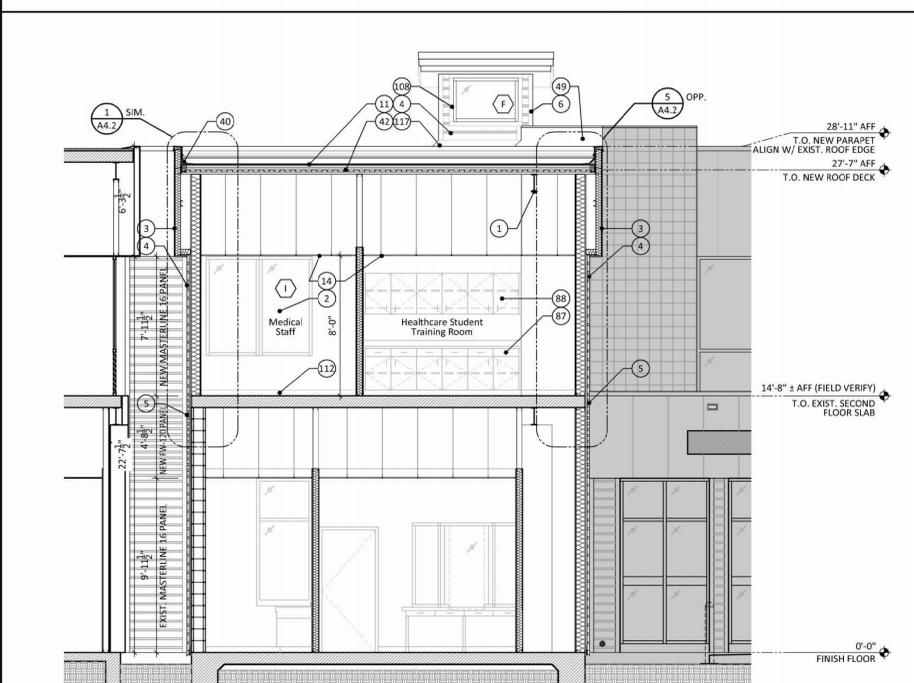


3 SECTION @ MEDICAL STAFF & HEALTHCARE STUDENT TRAINING ROOM
SCALE: 1/4" = 1'-0"

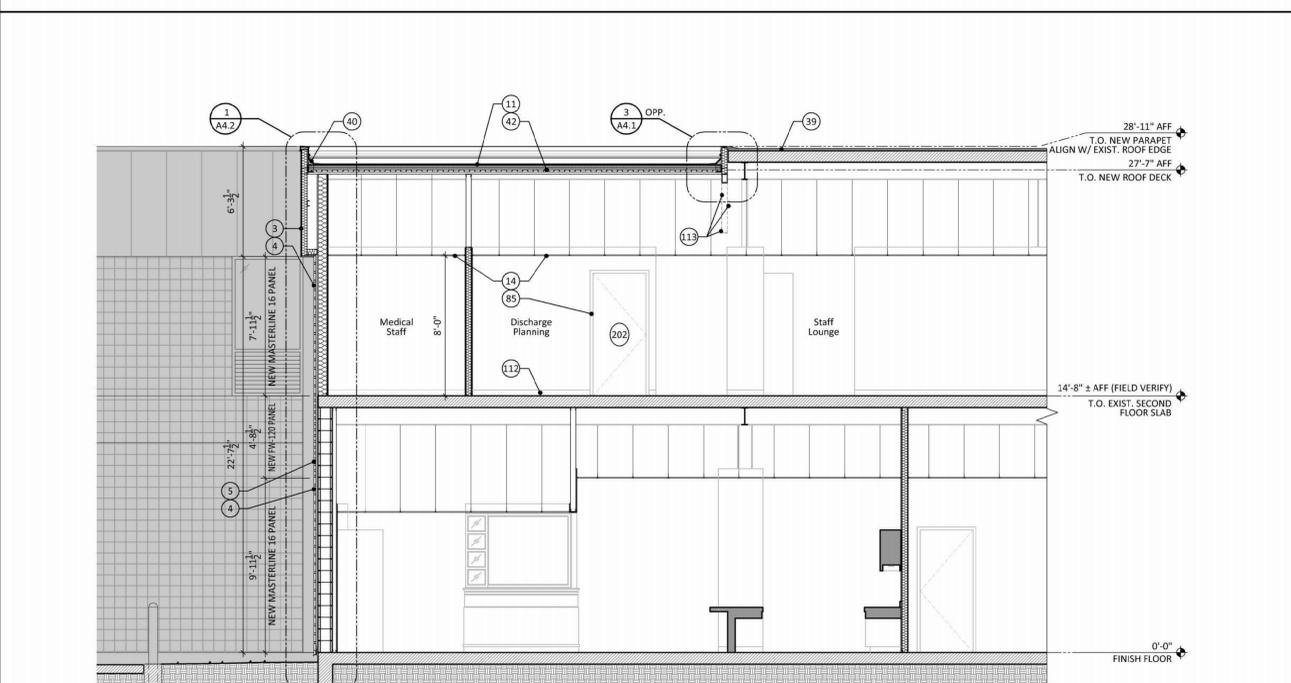

4 SECTION @ MEDICAL STAFF, DISCHARGE PLANNING, & STAFF LOUNGE
SCALE: 1/4" = 1'-0"

SECTION KEYNOTES	
1	See STRUCTURAL.
2	New aluminum storefront system with safety glazing, see WINDOW SCHEDULE.
3	New prefinished aluminum fascia, FW-120 Panel by MBCI or approved equal, to match existing in color and size.
4	New metal siding, Masterline 16 Wall Panel by MBCI, or approved equal.
5	New metal siding, FW-120 Wall Panel by MBCI, or approved equal.
6	Prefinished brake metal aluminum trim. Match finish to adjacent metal panel.
7	Existing prefinished aluminum fascia.
8	Existing scored masonry block.
9	New prefinished aluminum wall panels to match existing prefinished aluminum fascia in style and color.
10	Two (2) layers of 1" polyiso insulation board. Stagger layout.
11	Fully adhered, 2-ply SBS modified bitumen roofing system at new addition. Install per manufacturer's instructions, see SPECIFICATIONS.
12	3" (R-11) batt insulation.
13	1" exterior gypsum board (Densglass) on suspended metal furring, acoustical finish over.
14	Acoustical ceiling tiles, Armstrong 3821 24" x 24" tile in Armstrong Supraline XL Fire Guard 1/8" exposed tee grid, or approved equal.
15	3/8" 25 gauge metal studs at 16" O.C.
16	6" 25 gauge metal studs at 16" O.C.
17	6" (R-19) batt insulation.
18	1/2" cover board.
19	1/2" gypsum board.
20	Create 48" x 48" sump area using 1 1/2" x 18" tapered insulation edge strips, trimmed to fit slope or use prefabricated faced insulation sump panel.
21	1/2" galvanized hat channel at 16" O.C.
22	Prefinished metal coping. See SPECIFICATIONS.
23	1/2" expansion joint with compressible filler and sealant at top.
24	Approximate line of finish grade, slope away from building.
25	Exposed concrete at slab edge.
26	Cut edge sealant by roof manufacturer.
27	Seal roofing membrane edge.
28	Turn roofing membrane down face of nailer.
29	Hem flashing edge, 1/2" typical.
30	Prefinished metal scupper, extend under roof edge flashing and flash as per roof manufacturer typical detail.
31	Concrete slab and foundation, see STRUCTURAL.
32	Drainable fill, see STRUCTURAL.
33	Compact fill, see STRUCTURAL.
34	Vapor barrier, see STRUCTURAL.
35	Existing sidewalk, protect from damage.
36	ADA compliant, low-profile metal threshold, set in bed of sealant.
37	Existing paving, protect from damage.
38	Existing second floor concrete slab.
39	Existing built-up roof to remain.
40	New 5" cant strip at roof to wall (or parapet) transition.
41	Continuous treated 2X nailer.
42	1 1/2" corrugated metal roof deck. See STRUCTURAL.
43	Welded steel angle framing. See STRUCTURAL.
44	Strainer basket.
45	Compression ring.
46	Secure flange to deck with minimum four (4) pan head screws spaced at 12" O.C. maximum.
47	6" PVC roof drain piping.
48	Existing construction shown approximate. Verify at site.
49	Prefinished metal flashing, dimensions to fit location. Close open ends.
50	1/2" exterior grade plywood.
51	Elastomeric sealant joint with backer rod around perimeter of storefront frame as per manufacturer. Caulk interior perimeter of frame.
52	High performance sill flashing by storefront manufacturer with integral end and back dams, set in continuous bed of elastomeric sealant. Integrate flexible flashing at jamb into high performance sill flashing.
53	2 hour fire-rated wall construction per UL Design No. U914. 1/2" type X gypsum board on furring channels at 24" O.C., braced as required. Studs shall run to underside of roof deck. Apply fire-rated sealant at perimeter and at penetrations.
54	New wall construction: 1/2" type X gypsum board on both sides of 3" steel stud framing at 16" O.C., insulate - braced as required.
55	Existing MRI trailer to remain, protect from damage.
56	Existing column to be covered with 1/2" gypsum board, painted.
57	Existing flashing to remain. Protect from damage when tacking new flashing behind existing.
58	Saw cut into existing masonry joint, install prefinished metal flashing, wedge tight, and seal around flashing penetration.
59	Silicone sealant with backer rod.
60	Treated wood blocking as required.
61	Treated 2X4 bottom plate, secure to deck.
62	Treated 2X6.
63	3" x 3" aluminum closure angle.
64	Self-adhesive flexible foam tape.
65	1/2" veneer plywood, painted.
66	1/2" exterior grade plywood.
67	Light fixture, see ELECTRICAL.
68	Exterior wall-mounted, channel letter sign. See ELECTRICAL for lighting information. Contractor to provide all necessary concealed support/blocking behind metal siding.
69	1 1/2" x 14 X 1/2" slitch (12" O.C.).
70	Single head tape sealant.
71	Outside closure.
72	#12-14 X 1/2" SD (12" O.C.).
73	Metal support clip. See STRUCTURAL.
74	6", 25 gauge metal studs at 16" O.C.
75	Roof framing. See STRUCTURAL.
76	Repaint wall near new work, match adjacent.
77	Typical flashing as per roof manufacturer detail.
78	Self-adhesive flexible sheet flashing. Install continuous around opening. Integrate with head flashing, sill flashing, through-wall flashing, and weather barrier per manufacturer's recommendations.
79	Anodized aluminum brake-metal cover to match storefront.
80	1/2" expansion joint with compressible filler and sealant at top.
81	Hex head cap screw with EPDM washer.
82	Protect existing building from damage.
83	Furn-down as indicated. 1/2" gypsum board, painted, on metal stud framing at 16" O.C. Framing must be stable and secure. Attach to structural framing above.
84	Fill voids with approved fire stopping material per UL assembly.
85	Door and frame, see DOOR SCHEDULE.
86	New hand-wash sink, see PLUMBING.
87	Base cabinets, see Detail 3/A5.3.
88	Upper cabinets, see Detail 3/A5.3.
89	Vending machine locations (N.I.C.), see ELECTRICAL for power/data requirements.
90	Dual-height water coolers, see PLUMBING. Install in compliance with ADA requirements as per manufacturer.
91	Plastic laminate-clad counter.
92	Dashdot line indicates 1 hour smoke compartment wall construction per UL Design No. U465. 1/2" type X gypsum board on both sides of 3" steel stud framing at 16" O.C., insulate - braced as required. Studs shall run to underside of roof deck.
93	New wall construction to fill opening left by door removal. Match existing wall construction.
94	New full height wall cabinets.
95	Align new wall construction with existing wall construction.
96	New workstation counter and drawer base cabinet.
97	New wall construction to fill opening left by window removal. 1/2" type X gypsum board on both sides of 6" steel stud framing at 16" O.C., insulate - braced as required. Studs shall run to underside of roof deck.
98	New location for oxygen/suction medical gas system.
99	New wall construction at opening created by removal of portion of scored masonry block wall.
100	Light fixture, see ELECTRICAL.
101	Landscape by others.
102	Exterior wall-mounted sign by Signs & More, (N.I.C.). Contractor to provide all necessary concealed support/blocking behind metal siding.
103	Electromagnetic door holder device connected to fire alarm system.
104	Infill opening with scored masonry block, paint to match existing. Interior face of opening to be filled with metal stud wall construction covered with 1/2" gypsum board, painted.
105	New medical whiteboard by others, (N.I.C.).
106	File drawers with pull and hanging file hardware.
107	Spandrel glazing, this section.
108	Install new clerestory window in patient room to meet daylighting requirements. See Detail 3/A4.2.
109	Existing 2 hour fire-rated wall construction at stairs.
110	Existing 1 hour smoke compartment wall construction.
111	Existing 1 hour fire-rated wall construction per UL Design No. U419.
112	Scheduled base, see FINISH SCHEDULE.
113	Remove existing prefinished aluminum fascia panel and associated framing.
114	New 9 1/2" acoustic separation wall construction between suites: 1/2" type X gypsum board, 3" steel stud framing at 16" O.C., extended to roof deck above, 1/2" pad, 3" steel stud framing at 16" O.C., extended to roof deck above, 1/2" type X gypsum board, insulate - braced as required.
115	Window sill, see Detail 6/A4.2.
116	Tapered rigid roof insulation, 1" per 1'-0" slope.
117	New section of fully adhered, 2-ply SBS modified bitumen roofing system at clerestory lantern.
118	Install termination bar and sealant at end of membrane, typical.
119	Standard roofing membrane flashing system.
120	Prefinished metal counter-flashing.
121	Cricketer from roof insulation to fit location, slope at 1/2" per foot.
122	8", 20 gauge metal studs at 16" O.C.
123	8" (R-30) batt insulation.

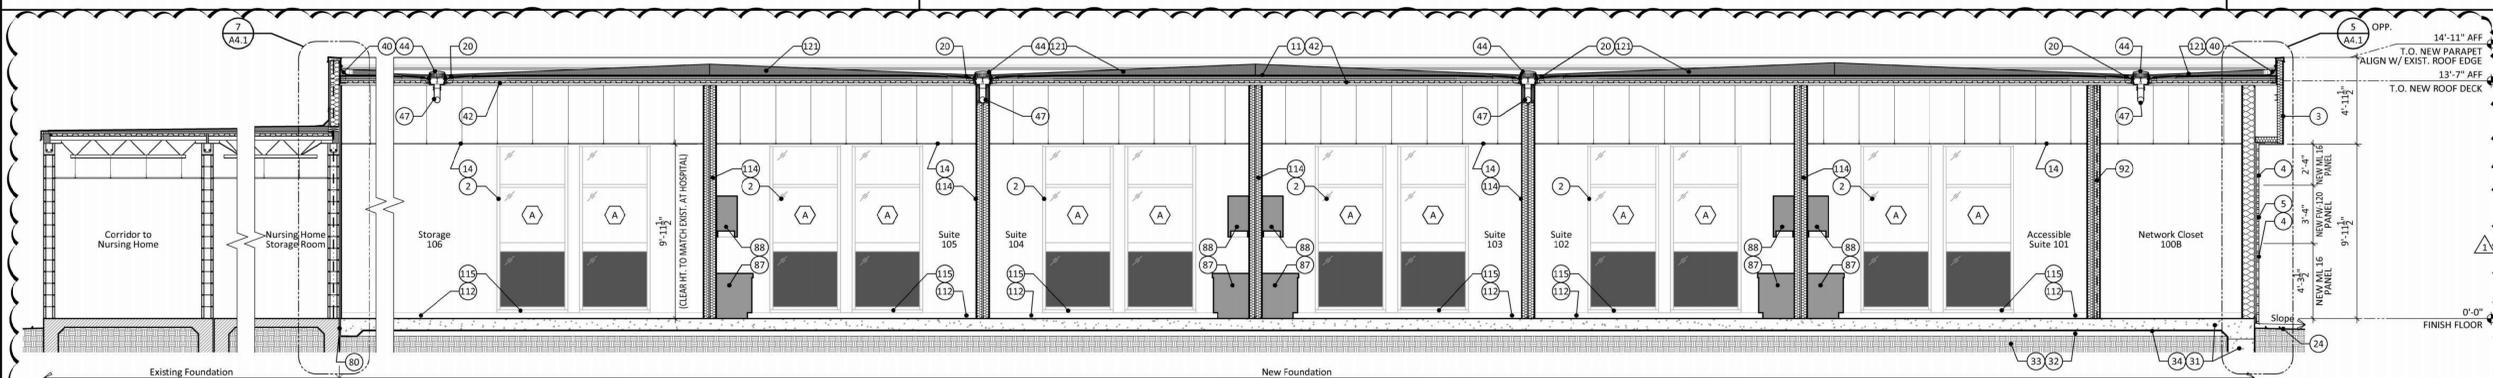

5 SECTION @ PHYSICIAN'S WING - ADD ALT. #1
SCALE: 1/4" = 1'-0"

ASHE | BROUSSARD | WEINZETTEL ARCHITECTS

This drawing and design are the property of Ashe Broussard Weinzettel Architects. They are submitted on the condition that they are not to be used, reproduced, or copied, in whole or in part, or used for furnishing information to others, without the prior written consent of Ashe Broussard Weinzettel Architects. All common law rights of copyright and otherwise are hereby specifically reserved.


02.07.2025

REVISIONS		
revision	description	date
1	Addendum No. One	10.15.25


LASALLE GENERAL HOSPITAL	project no. 2024.01
Workforce Capacity and Medical Access Project	drawn KPL
EDA No. 08-79-05595	checked JDW
187 Ninth St. Jena, Louisiana 71342	project date FEB 2025
sheet contents	drawing no.

BUILDING SECTIONS


A4.0

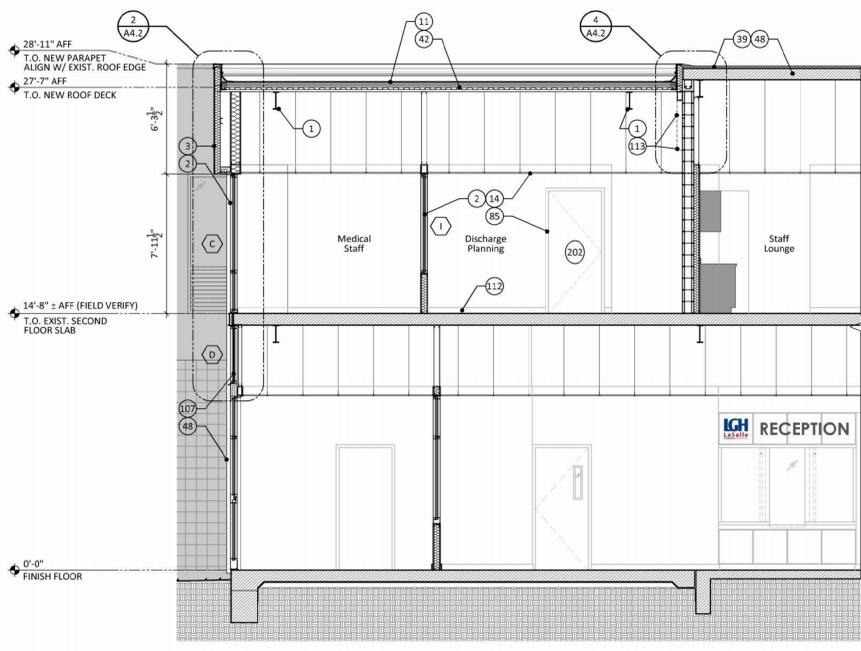


1 SECTION DETAIL THROUGH NEW STOREFRONT
SCALE: 1 1/2" = 1'-0"

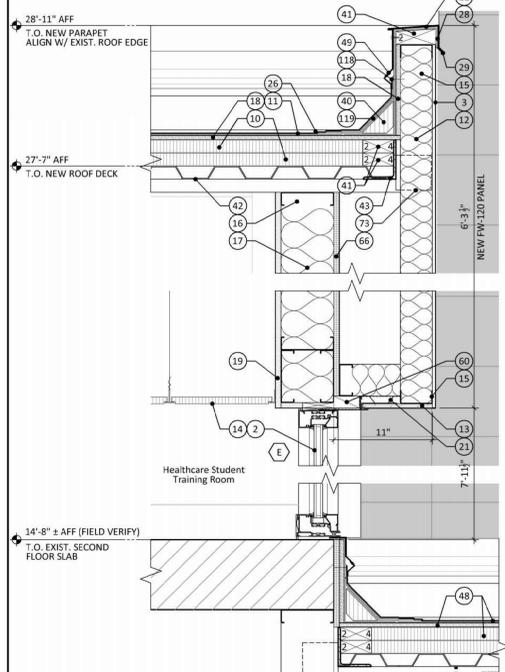


4 SECTION DETAIL @ SECOND FLOOR STOREFRONT
SCALE: 1 1/2" = 1'-0"

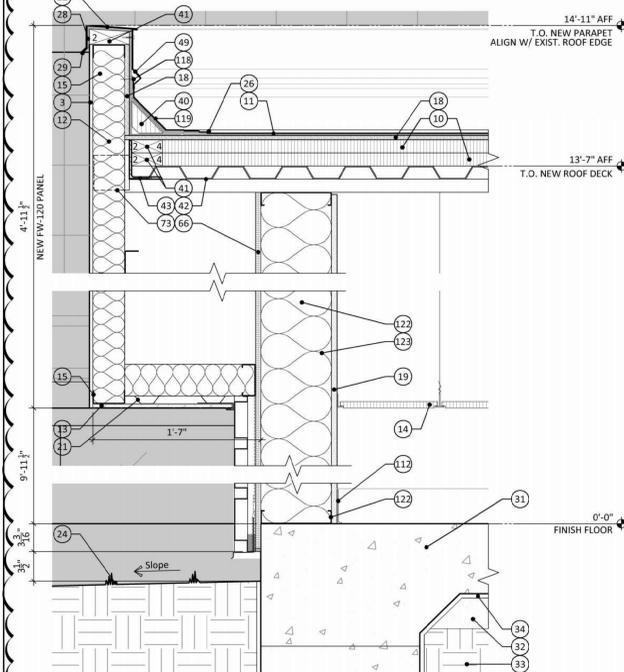


5 SECTION DETAIL @ PHYSICIAN'S WING - ADD ALT. #1
SCALE: 1 1/2" = 1'-0"

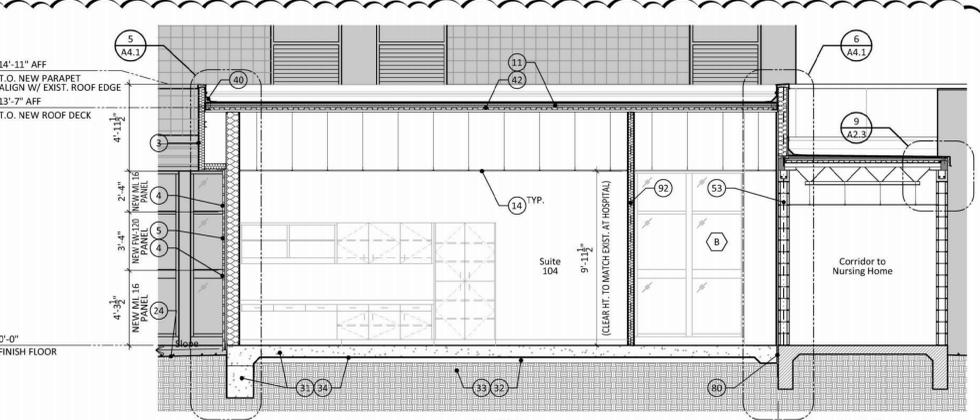


2 SECTION @ PHYSICIAN'S WING - ADD ALT. #1
SCALE: 1/4" = 1'-0"

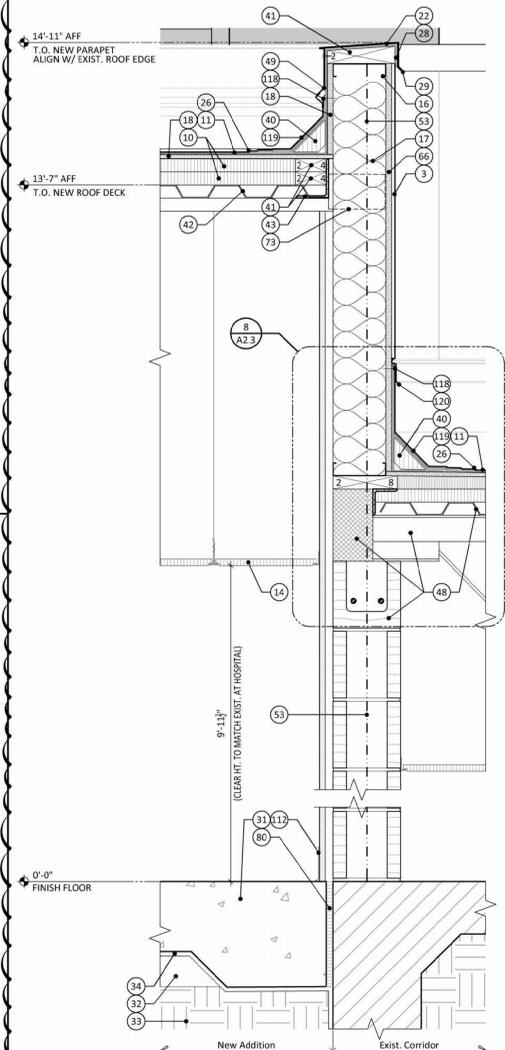

6 SECTION DETAIL @ CORRIDOR TO NURSING HOME & PHYSICIAN'S WING - ADD ALT. #1
SCALE: 1 1/2" = 1'-0"

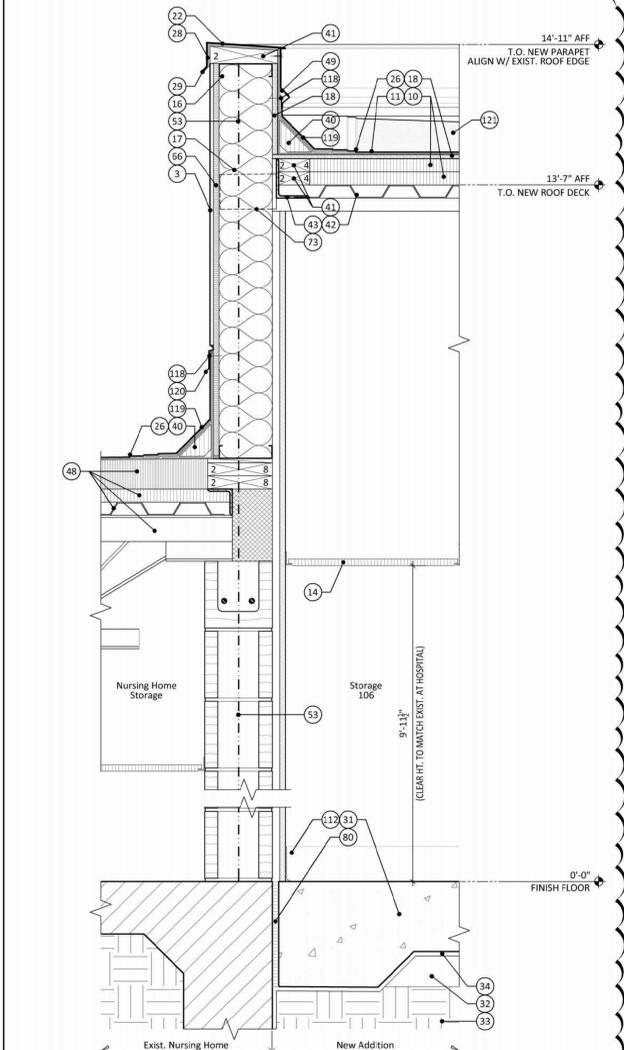

7 SECTION DETAIL @ NURSING HOME & PHYSICIAN'S WING - ADD ALT. #1
SCALE: 1 1/2" = 1'-0"

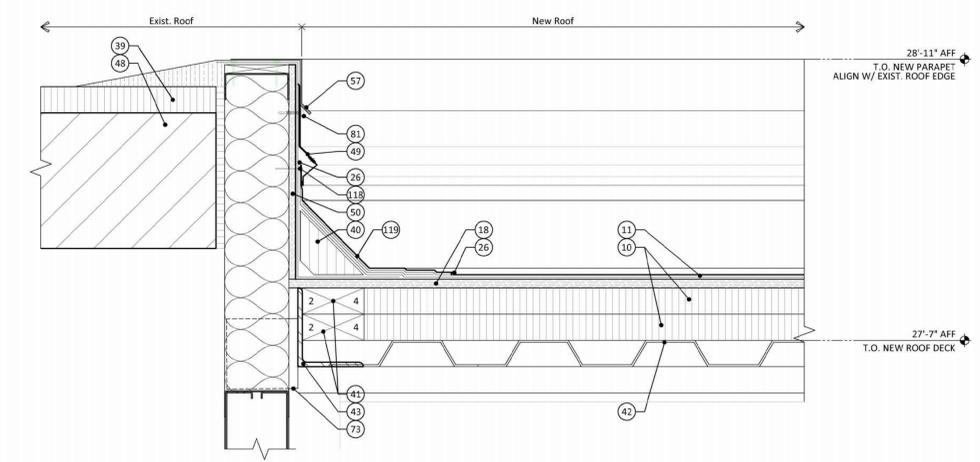

3 SECTION DETAIL @ ROOF OFFSET
SCALE: 3" = 1'-0"

SECTION KEYNOTES	
1	See STRUCTURAL.
2	New aluminum storefront system with safety glazing, see WINDOW SCHEDULE.
3	New prefinished aluminum fascia, FW-120 panel by MBCI or approved equal, to match existing in color and size.
4	New metal siding, Masterline 16 Wall Panel by MBCI, or approved equal.
5	New metal siding, FW-120 Wall Panel by MBCI, or approved equal.
6	Prefinished brake metal aluminum trim. Match finish to adjacent metal panel.
7	Existing scored masonry block.
8	New prefinished aluminum wall panels to match existing prefabricated aluminum fascia in style and color.
9	Two (2) layers of 1" polyiso insulation board. Stagger panel layout.
10	Fully adhered, 2-ply SBS modified bitumen roofing system at new addition, install per manufacturer's instructions, see SPECIFICATIONS.
11	3" (R-11) batt insulation.
12	1/2" exterior gypsum board (Densglass) on suspended metal furring, acrylic stucco finish over.
13	Acoustical ceiling tiles, Armstrong 1821 24" x 24" tile in Armstrong Supraline XL Fire Guard 3/8" exposed tee grid, or approved equal.
14	3" x 25 gauge metal studs at 16" O.C.
15	6" x 25 gauge metal studs at 16" O.C.
16	6" (R-19) batt insulation.
17	1/2" gypsum board.
18	3" cover board.
19	1/2" gypsum board.
20	Create 48" x 48" sump area using 1 1/2" x 18" tapered insulation edge strips, trimmed to fit slope or use prefabricated faced insulation sump panel.
21	1/2" galvanized hat channel at 16" O.C.
22	Prefinished metal coping. See SPECIFICATIONS.
23	1/2" expansion joint with compressible filler and sealant at top.
24	Approximate line of finish grade, slope away from building.
25	Exposed concrete at slab edge.
26	Cut edge sealant by roof manufacturer.
27	Seal roofing membrane edge.
28	Turn roofing membrane down face of nailer.
29	Hem flashing edge, 1/2" typical.
30	Prefinished metal scupper, extend under roof edge flashing and flash as per manufacturer typical detail.
31	Concrete slab and foundation, see STRUCTURAL.
32	Drainable fill, see STRUCTURAL.
33	Compact fill, see STRUCTURAL.
34	Vapor barrier, see STRUCTURAL.
35	Existing sidewalk, protect from damage.
36	ADA compliant, low-profile metal threshold, set in bed of sealant.
37	Existing paving, protect from damage.
38	Existing second floor concrete slab.
39	Existing built-up roof to remain.
40	New 5" cant strip at roof to wall (or parapet) transition.
41	Continuous treated 2X nailer.
42	1 1/2" corrugated metal roof deck. See STRUCTURAL.
43	Welded steel angle framing. See STRUCTURAL.
44	Strainer basket.
45	Compression ring.
46	Secure flange to deck with minimum four (4) pan head screws spaced at 12" O.C. maximum.
47	6" PVC roof drain piping.
48	Existing construction shown approximate. Verify at site.
49	Prefinished metal flashing, dimensions to fit location. Close open ends.
50	1/2" exterior grade plywood.
51	Elastomeric sealant joint with backer rod around perimeter of storefront frame as per manufacturer. Caulk interior perimeter of frame.
52	High performance sill flashing by storefront manufacturer with integral end and back dams; set in continuous bed of elastomeric sealant. Integrate flexible flashing at jamb into high performance sill flashing.
53	2 hour fire-rated wall construction per UL Design No. U914. 1/2" type x gypsum board on both sides of 3" steel stud framing at 16" O.C., insulate - braced as required. Studs shall run to underside of roof deck. Apply fire-rated sealant at perimeter and at penetrations.
54	New wall construction: 1/2" type x gypsum board on both sides of 3" steel stud framing at 16" O.C., insulate - braced as required.
55	Existing MRI trailer to remain, protect from damage.
56	Existing column to be covered with 1/2" gypsum board, painted.
57	Existing flashing to remain. Protect from damage when tacking. New flashing behind existing.
58	Saw cut into existing masonry joint, install prefinished metal flashing, wedge tight, and seal around flashing penetration.
59	Silicone sealant with backer rod.
60	Treated wood blocking as required.
61	Treated 2X4 bottom plate, secure to deck.
62	Treated 2X6.
63	3" x 3" aluminum closure angle.
64	Self-adhesive flexible foam tape.
65	1/2" veneer plywood, painted.
66	1/2" exterior grade plywood.
67	Light fixture, see ELECTRICAL.
68	Exterior wall-mounted, channel letter sign. See ELECTRICAL for lighting information. Contractor to provide all necessary concealed support/blocking behind metal siding.
69	1/2" x 14 X 1/2" stitch (12" O.C.).
70	Single bead tape sealant.
71	Outside closure.
72	#12-14 X 1/2" SD (12" O.C.).
73	Metal support clip. See STRUCTURAL.
74	6" x 25 gauge metal studs at 16" O.C.
75	Roof framing. See STRUCTURAL.
76	Repaint wall near new work, match adjacent.
77	Typical flashing as per manufacturer detail.
78	Self-adhesive flexible sheet flashing. Install continuous around opening; integrate with head flashing, sill flashing, through-wall flashing, and weather barrier per manufacturer's recommendations.
79	Anodized aluminum brake-metal cover to match storefront.
80	1/2" expansion joint with compressible filler and sealant at top.
81	Hex head cap screw with EPDM washer.
82	Protect existing building from damage.
83	Furr-down as indicated, 1/2" gypsum board, painted, on metal stud framing at 16" O.C. Framing must be stable and secure. Attach to structural framing above.
84	Fill voids with approved fire stopping material per UL assembly.
85	Door and frame, see DOOR SCHEDULE.
86	New hand-wash sink, see PLUMBING.
87	Base cabinets, see Detail 3/A5.3.
88	Upper cabinets, see Detail 3/A5.3.
89	Vending machine locations (N.I.C.), see ELECTRICAL for power/data requirements.
90	Dual-height water coolers, see PLUMBING. Install in compliance with ADA requirements as per manufacturer.
91	Plastic laminate-clad counter.
92	Dasbord line indicates 1 hour smoke compartment wall construction per UL Design No. U455. 1/2" type x gypsum board on both sides of 3" steel stud framing at 16" O.C., insulate - braced as required. Studs shall run to underside of roof deck.
93	New wall construction to fill opening left by door removal. Match existing wall construction.
94	New full height wall cabinets.
95	Align new wall construction with existing wall construction.
96	New workstation counter and drawer base cabinet.
97	New wall construction to fill opening left by window removal. 1/2" type x gypsum board on both sides of 6" steel stud framing at 16" O.C., insulate - braced as required. Studs shall run to underside of roof deck.
98	New location for oxygen/suction medical gas system.
99	New wall construction at opening created by removal of portion of scored masonry block wall.
100	Light fixture, see ELECTRICAL.
101	Landscape by others.
102	Exterior wall-mounted sign by Signs & More, (N.I.C.). Contractor to provide all necessary concealed support/blocking behind metal siding.
103	Electromagnetic door holder device connected to fire alarm system.
104	Infill opening with scored masonry block, paint to match existing. Interior face of opening to be filled with metal stud wall construction covered with 1/2" gypsum board, painted.
105	New medical whiteboard by others, (N.I.C.).
106	File drawers with pull and hanging file hardware.
107	Spandrel glazing, this section.
108	Install new clerestory window in patient room to meet daylighting requirements. See Detail 3/A4.2.
109	Existing 2 hour fire-rated wall construction at stairs.
110	Existing 1 hour smoke compartment wall construction.
111	Existing 1 hour fire-rated wall construction per UL Design No. U419.
112	Scheduled base, see FINISH SCHEDULE.
113	Remove existing prefabricated aluminum fascia panel and associated framing.
114	New 9" acoustic separation wall construction between suites: 1/2" type x gypsum board, 3" steel stud framing at 16" O.C., extended to roof deck above, 1/2" type x gypsum board, insulate - braced as required.
115	Window sill, see Detail 6/A4.2.
116	Tapered rigid roof insulation, 1" per 1'-0" slope.
117	New section of fully adhered, 2-ply SBS modified bitumen roofing system at clerestory lantern.
118	Install termination bar and sealant at end of membrane, typical.
119	Standard roofing membrane flashing system.
120	Prefinished metal counter-flashing.
121	Crickle from roof insulation to fit location, slope at 1/2" per foot.
122	8" x 20 gauge metal studs at 16" O.C.
123	8" (R-30) batt insulation.

ASHE | BROUSSARD | WEINZITTE ARCHITECTS

This drawing and design are the property of Ashe Broussard Weinzittle Architects. They are submitted on the condition that they are not to be used, reproduced, or copied, in whole or in part, or used for furnishing information to others, without the prior written consent of Ashe Broussard Weinzittle Architects. All common law rights of copyright and otherwise are hereby specifically reserved.

02.07.2025


REVISIONS		
revision	description	date
1	Addendum No. One	10.15.25

LASALLE GENERAL HOSPITAL
Workforce Capacity and Medical Access Project
EDA No. 08-79-05995
187 Ninth St. Jena, Louisiana 71342


project no. 2024.01
drawn: JFL
checked: JDW
project date: FEB 2025
sheet contents: drawing no.

BUILDING SECTIONS & SECTION DETAILS


A4.1

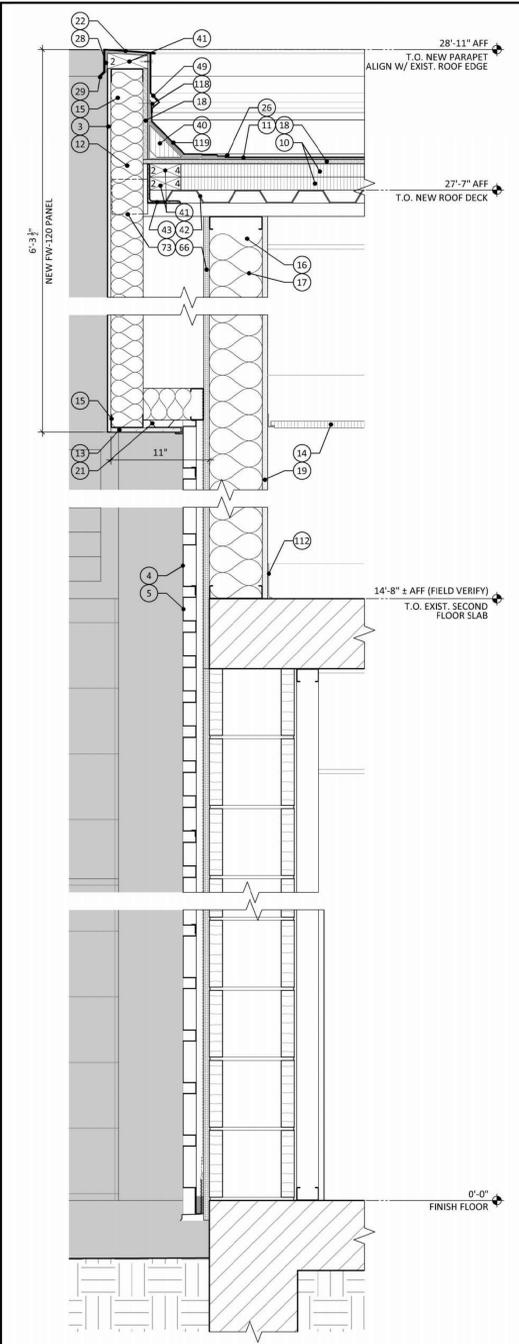


1 SECTION DETAIL THROUGH NEW SIDING
SCALE: 1 1/2" = 1'-0"

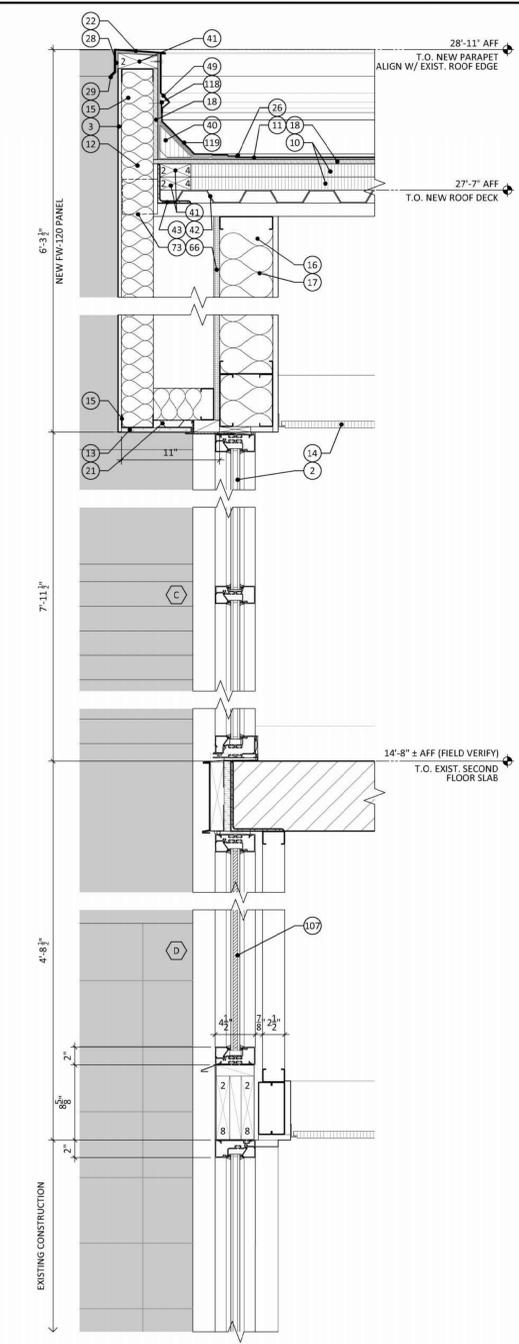


2 SECTION DETAIL THROUGH STOREFRONT
SCALE: 1 1/2" = 1'-0"

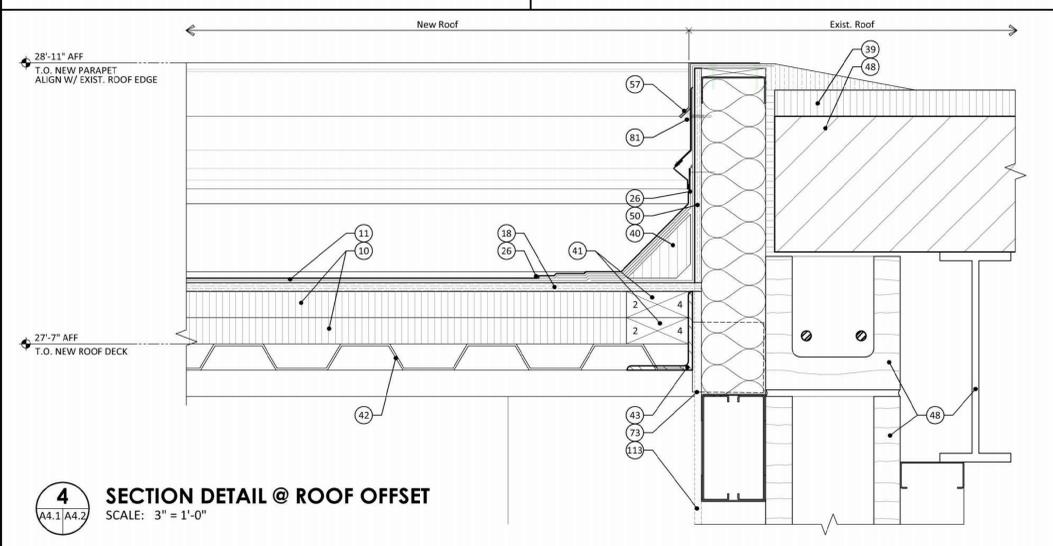


4 SECTION DETAIL @ ROOF OFFSET
SCALE: 3" = 1'-0"

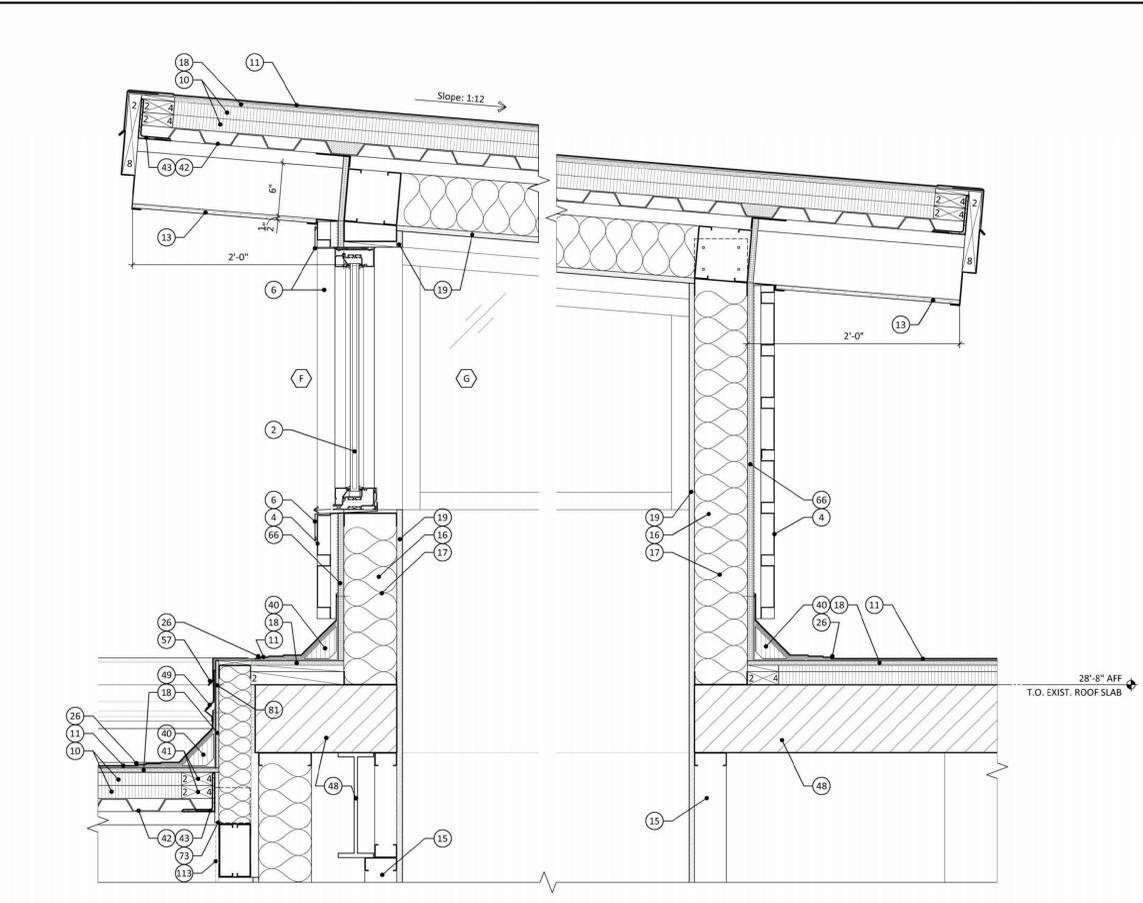

3 SECTION DETAIL THROUGH NEW CLERESTORY LANTERN
SCALE: 1 1/2" = 1'-0"

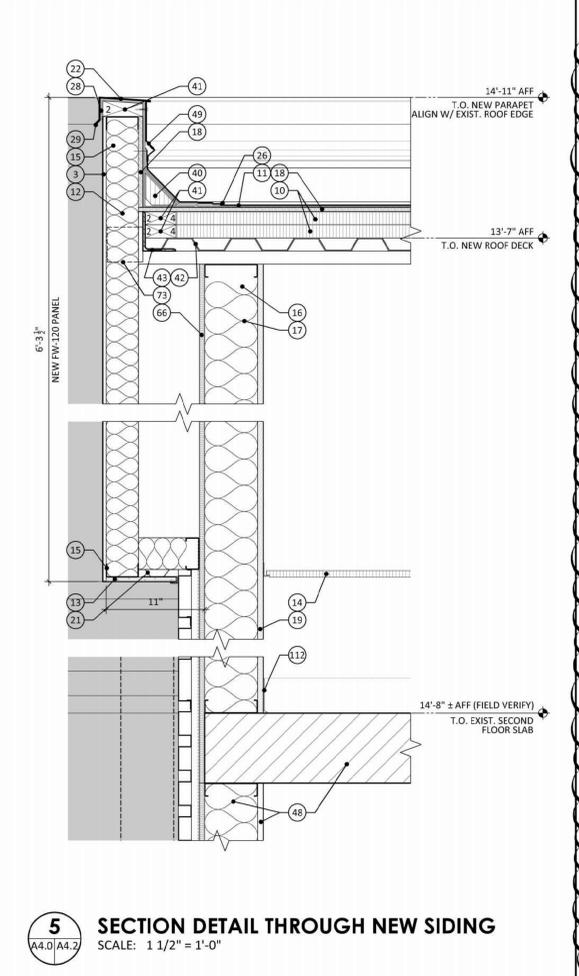

5 SECTION DETAIL THROUGH NEW SIDING
SCALE: 1 1/2" = 1'-0"

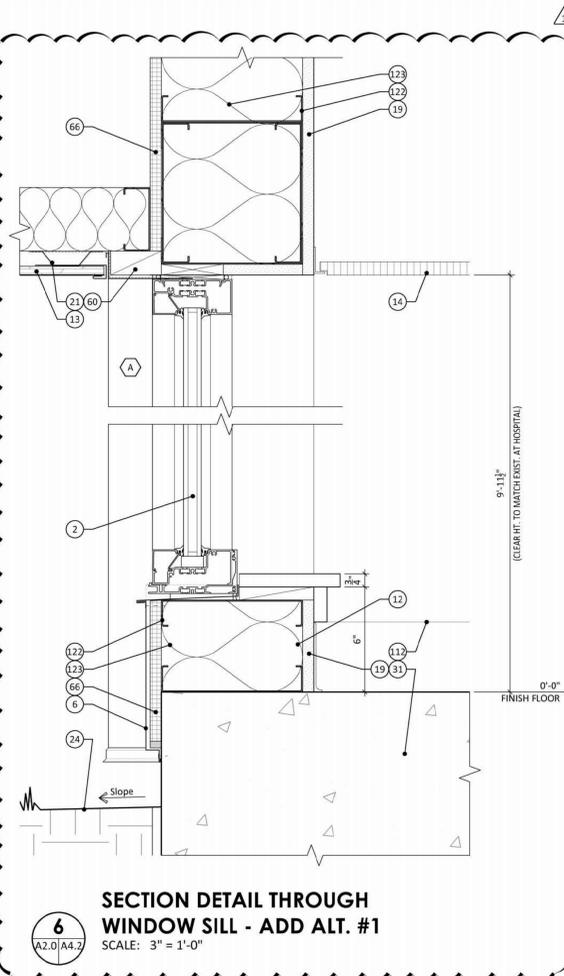

6 SECTION DETAIL THROUGH WINDOW SILL - ADD ALT. #1
SCALE: 3" = 1'-0"

SECTION KEYNOTES	
1	See STRUCTURAL.
2	New aluminum storefront system with safety glazing, see WINDOW SCHEDULE.
3	New prefinished aluminum fascia, FW-120 panel by MBCI or approved equal, to match existing in color and size.
4	New metal siding, Masterline 16 Wall Panel by MBCI, or approved equal.
5	New metal siding, FW-120 Wall Panel by MBCI, or approved equal.
6	Prefinished brake metal aluminum trim. Match finish to adjacent metal panel.
7	Existing prefinished aluminum fascia.
8	Existing scored masonry block.
9	New prefinished aluminum wall panels to match existing prefinished aluminum fascia in style and color.
10	Two (2) layers of 1 1/2" polyiso insulation board. Stagger panel layout.
11	Fully adhered, 2-ply SBS modified bitumen roofing system at new addition. Install per manufacturer's instructions, see SPECIFICATIONS.
12	3" (R-11) batt insulation.
13	1/2" exterior gypsum board (Densglass) on suspended metal furring, acrylic stucco finish over.
14	Acoustical ceiling tiles, Armstrong 1821 24" x 24" tile in Armstrong Supraline XL Fire Guard 1/8" exposed tee grid, or approved equal.
15	3/8", 25 gauge metal studs at 16" O.C.
16	6", 25 gauge metal studs at 16" O.C.
17	6" (R-19) batt insulation.
18	1/2" cover board.
19	3/8" gypsum board.
20	Create 48" x 48" sump area using 1 1/2" x 18" tapered insulation edge strips, trimmed to fit slope or use prefabricated faced insulation sump panel.
21	1/2" galvanized hat channel at 16" O.C.
22	Prefinished metal coping. See SPECIFICATIONS.
23	1/2" expansion joint with compressible filler and sealant at top.
24	Approximate line of finish grade, slope away from building.
25	Exposed concrete at slab edge.
26	Cut edge sealant by roof manufacturer.
27	Seal roofing membrane edge.
28	Turn roofing membrane down face of nailer.
29	Hem flashing edge, 1/2" typical.
30	Prefinished metal scupper, extend under roof edge flashing and flash as per roof manufacturer typical detail.
31	Concrete slab and foundation, see STRUCTURAL.
32	Drainable fill, see STRUCTURAL.
33	Compact fill, see STRUCTURAL.
34	Vapor barrier, see STRUCTURAL.
35	Existing sidewalk, protect from damage.
36	ADA compliant, low-profile metal threshold, set in bed of sealant.
37	Existing paving, protect from damage.
38	Existing second floor concrete slab.
39	Existing built-up roof to remain.
40	New 5" cant strip at roof to wall (or parapet) transition.
41	Continuous treated 2X nailer.
42	1 1/2" corrugated metal roof deck. See STRUCTURAL.
43	Welded steel angle framing. See STRUCTURAL.
44	Strainer basket.
45	Compression ring.
46	Secure flange to deck with minimum four (4) pan head screws spaced at 12" O.C. maximum.
47	6" PVC roof drain piping.
48	Existing construction shown approximate. Verify at site.
49	Prefinished metal flashing, dimensions to fit location. Close open ends.
50	1/2" exterior grade plywood.
51	Elastomeric sealant joint with backer rod around perimeter of storefront frame as per manufacturer. Caulk interior perimeter of frame.
52	High performance sill flashing by storefront manufacturer with integral end and back dams, set in continuous bed of elastomeric sealant. Integrate flexible flashing at jamb into high performance sill flashing.
53	2 hour fire-rated wall construction per UL Design No. U914. 1/2" type x gypsum board on both sides of 3" steel stud framing at 16" O.C., insulate - braced as required. Studs shall run to underside of roof deck. Apply fire-rated sealant at perimeter and at all penetrations.
54	New wall construction: 1/2" type x gypsum board on both sides of 3" steel stud framing at 16" O.C., insulate - braced as required.
55	Existing MRI trailer to remain, protect from damage.
56	Existing column to be covered with 1/2" gypsum board, painted.
57	Existing flashing to remain. Protect from damage when tasking new flashing behind existing.
58	Saw cut into existing masonry joint, install prefinished metal flashing, wedge tight, and seal around flashing penetration.
59	Silicone sealant with backer rod.
60	Treated wood blocking as required.
61	Treated 2X4 bottom plate, secure to deck.
62	Treated 2X6.
63	3" x 3" aluminum closure angle.
64	Self-adhesive flexible foam tape.
65	1/2" veneer plywood, painted.
66	1/2" exterior grade plywood.
67	Light fixture, see ELECTRICAL.
68	Exterior wall-mounted, channel letter sign. See ELECTRICAL for lighting information. Contractor to provide all necessary concealed support/blocking behind metal siding.
69	1/2" x 14" x 1/2" stitch (12" O.C.).
70	Single bead tape sealant.
71	Outside closure.
72	#12-14 X 1/2" SD (12" O.C.).
73	Metal support clip. See STRUCTURAL.
74	6", 25 gauge metal studs at 16" O.C.
75	Roof framing. See STRUCTURAL.
76	Repaint wall near new work, match adjacent.
77	Typical flashing as per roof manufacturer detail.
78	Self-adhesive flexible sheet flashing. Install continuous around opening; integrate with head flashing, sill flashing, through-wall flashing, and weather barrier per manufacturer's recommendations.
79	Anodized aluminum brake-metal cover to match storefront.
80	1/2" expansion joint with compressible filler and sealant at top.
81	Hex head cap screw with EPDM washer.
82	Protect existing building from damage.
83	Fur-down as indicated, 1/2" gypsum board, painted, on metal stud framing at 16" O.C. Framing must be stable and secure. Attach to structural framing above.
84	Fill voids with approved fire stopping material per UL assembly.
85	Door and frame, see DOOR SCHEDULE.
86	New hand-wash sink, see PLUMBING.
87	Base cabinets, see Detail 3/A5.3.
88	Upper cabinets, see Detail 3/A5.3.
89	Vending machine locations (N.I.C.), see ELECTRICAL for power/data requirements.
90	Dual-height water coolers, see PLUMBING. Install in compliance with ADA requirements as per manufacturer.
91	Plastic laminate-clad counter.
92	Dashed line indicates 1 hour smoke compartment wall construction per UL Design No. U465. 1/2" type x gypsum board on both sides of 3" steel stud framing at 16" O.C., insulate - braced as required. Studs shall run to underside of roof deck.
93	New wall construction to fill opening left by door removal. Match existing wall construction.
94	New full height wall cabinets.
95	Align new wall construction with existing wall construction.
96	New workstation counter and drawer base cabinet.
97	New wall construction to fill opening left by window removal. 1/2" type x gypsum board on both sides of 6" steel stud framing at 16" O.C., insulate - braced as required. Studs shall run to underside of roof deck.
98	New location for oxygen/suction medical gas system.
99	New wall construction at opening created by removal of portion of scored masonry block wall.
100	Light fixture, see ELECTRICAL.
101	Landscaping by others.
102	Exterior wall-mounted sign by Signs & More, (N.I.C.). Contractor to provide all necessary concealed support/blocking behind metal siding.
103	Electromagnetic door holder device connected to fire alarm system.
104	Infill opening with scored masonry block, paint to match existing. Interior face of opening to be filled with metal stud wall construction covered with 1/2" gypsum board, painted.
105	New medical whiteboard by others, (N.I.C.).
106	File drawers with pull and hanging file hardware.
107	Spandrel glazing, this section.
108	Install new clerestory window in patient room to meet daylighting requirements. See Detail 3/A4.2.
109	Existing 2 hour fire-rated wall construction at stairs.
110	Existing 1 hour smoke compartment wall construction.
111	Existing 1 hour fire-rated wall construction per UL Design No. U419.
112	Scheduled base, see FINISH SCHEDULE.
113	Remove existing prefinished aluminum fascia panel and associated framing.
114	New 9 1/2" acoustic separation wall construction between suites: 1/2" type x gypsum board, 3" steel stud framing at 16" O.C., extended to roof deck above, 1/2" type x gypsum board, insulate - braced as required.
115	Window sill, see Detail 6/A4.2.
116	Tapered rigid roof insulation, 1/2" per 1'-0" slope.
117	New section of fully adhered, 2-ply SBS modified bitumen roofing system at clerestory lantern.
118	Install termination bar and sealant at end of membrane, typical.
119	Standard roofing membrane flashing system.
120	Prefinished metal counter-flashing.
121	Crickle from roof insulation to fit location, slope at 1/2" per foot.
122	8", 20 gauge metal studs at 16" O.C.
123	8" (R-30) batt insulation.

ASHE | BROUSSARD | WEINZITTE ARCHITECTS

This drawing and design are the property of Ashe Broussard Weinzittle Architects. They are submitted on the condition that they are not to be used, reproduced, or copied, in whole or in part, or used for furnishing information to others, without the prior written consent of Ashe Broussard Weinzittle Architects. All common law rights of copyright and otherwise are hereby specifically reserved.

02.07.2025


REVISIONS		
revision	description	date
1	Addendum No. One	10.15.25

LASALLE GENERAL HOSPITAL
Workforce Capacity and Medical Access Project
EDA No. 08-79-05595
187 Ninth St. Jena, Louisiana 71342


project no. 2024.01
drawn: JFL
checked: JDW
project date: FEB 2025
sheet contents: drawing no.

SECTION DETAILS


A4.2

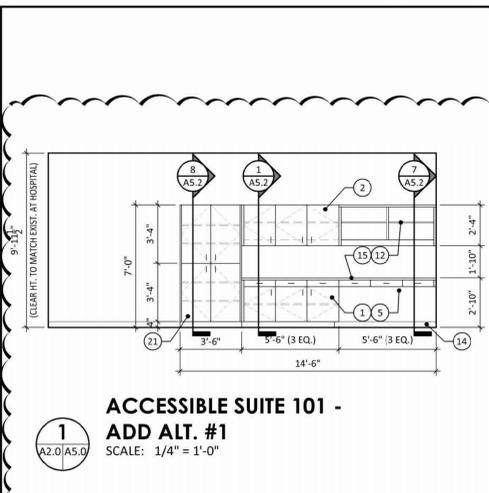


1
ACCESSIBLE SUITE 101 -
ADD ALT. #1
SCALE: 1/4" = 1'-0"

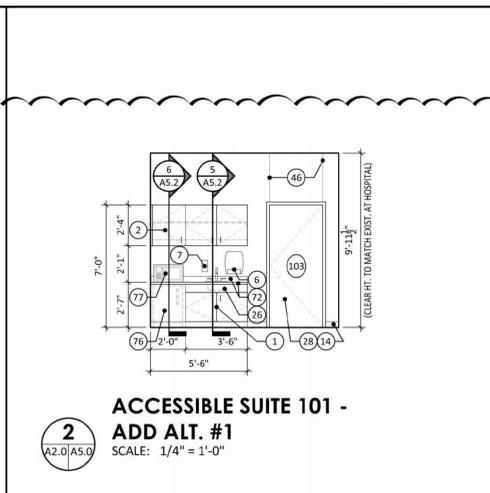

2
ACCESSIBLE SUITE 101 -
ADD ALT. #1
SCALE: 1/4" = 1'-0"

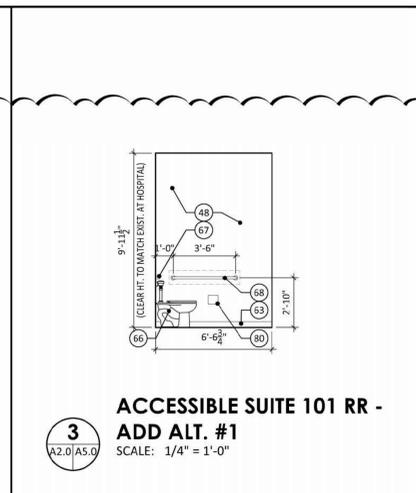

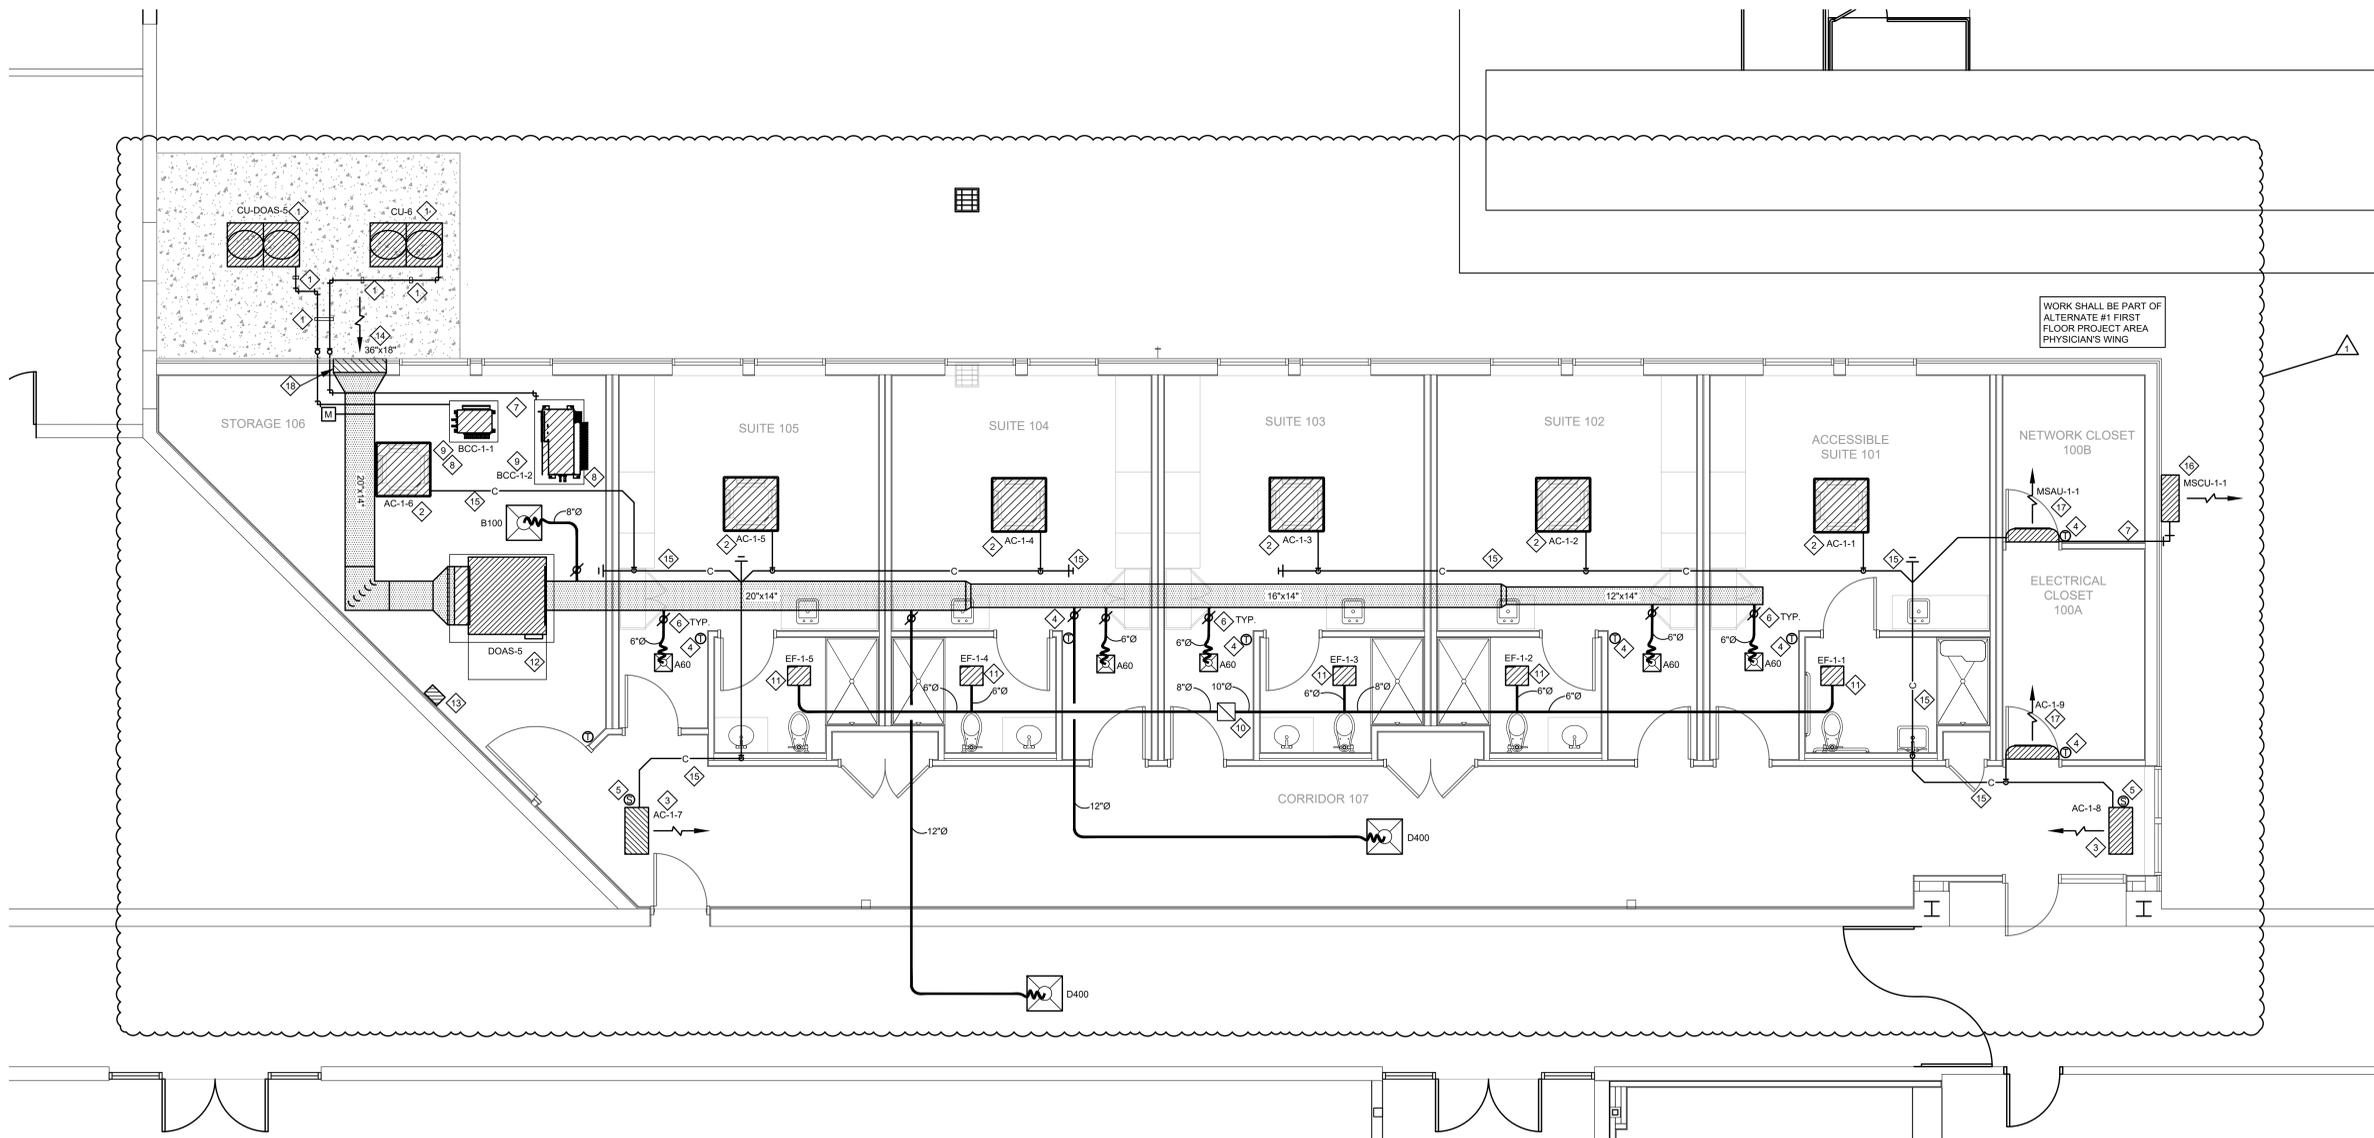

MECHANICAL PLAN - PHYSICIAN'S WING
 SCALE: 1/4" = 1'-0"

GENERAL MECHANICAL NOTES:

- A. ALL WORK SHALL COMPLY WITH LOCAL, STATE, AND FEDERAL CODES TO THE SATISFACTION OF CODE AUTHORITIES HAVING JURISDICTION.
- B. COORDINATE ALL CEILING DEVICES, DUCTWORK, ETC. WITH LIGHTING, STRUCTURAL, ETC. THROUGH GENERAL CONTRACTOR. REFER TO ALL DRAWINGS, (STRUCTURAL, PLUMBING, ELECTRICAL, ARCHITECTURAL, ETC.) NOTIFY ARCHITECT/ENGINEER CONCERNING ANY CONFLICTS NOTED PRIOR TO BIDS FOR CLARIFICATION TO THE SATISFACTION OF THE BIDDER. REFER TO SPECIFICATIONS FOR REQUIREMENTS. REFER TO LATEST ARCHITECTURAL REFLECTED CEILING PLAN. COORDINATE ALL CEILING DEVICE LOCATIONS WITH CEILING GRID.
- C. ALL SUPPLY, RETURN, EXHAUST, AND OUTSIDE AIR DUCTWORK SHALL BE EXTERNALLY INSULATED UNLESS NOTED OTHERWISE ON DRAWINGS. DUCT SIZES SHOWN ARE CLEAR METAL TO METAL. WRAP ALL DUCTWORK EXTERNALLY.
- D. HARDCAST ALL NEW DUCTWORK JOINTS FOR AIRTIGHT SYSTEM. REFER TO DETAILS FOR DUCTWORK TAP, SPLITTER, BRANCH CONFIGURATION, ETC. INSTALL IN ACCORDANCE WITH SMACNA RECOMMENDATIONS AND INSTALLATION GUIDELINES.
- E. VERIFY ALL OUTSIDE AIR INTAKES ARE A MINIMUM OF TEN FEET FROM EXHAUST OUTLETS, SEWER VENTS, ETC.
- F. CONTRACTOR SHALL SEAL ALL PIPING AND DUCT PENETRATIONS THROUGH WALLS AND FLOORS AS PER THE RATED UL DESIGNATION'S REQUIREMENTS. REFER TO ARCHITECTURAL PLANS FOR ALL UL RATINGS.
- G. PROVIDE ACCESS PANELS (PER SPECIFICATIONS) AS NEEDED FOR ACCESS TO ALL NEW FIRE DAMPERS, MANUAL DAMPERS, AND MOTORIZED DAMPERS. COORDINATE FINAL LOCATION/SIZE WITH ENGINEER/OWNER. ALL DAMPERS, ACCESS PANELS, ETC. SHALL BE INSTALLED FOR MAXIMUM ACCESSIBILITY.
- H. CONTRACTOR SHALL CAP AND SEAL ALL DUCTWORK DURING CONSTRUCTION TO PREVENT CONTAMINATION DUE TO CONSTRUCTION DEBRIS.

MECHANICAL KEYNOTES:

- 9. INSTALL CONDENSING UNITS ON STAND ON CONCRETE PAD PROVIDED BY GENERAL CONTRACTOR. COORDINATE LOCATION WITH MANUFACTURER'S RECOMMENDED CLEARANCES. PROVIDE REFRIGERANT PIPING SUPPORTS PER DETAILS. PIPE DRAIN PAN TO EDGE OF SLAB AND TURN DOWN.
- 10. PROVIDE AND INSTALL AN INDOOR 3x3' 4 WAY AIRFLOW CEILING CASSETTE UNIT IN CEILING GRID IN THIS VICINITY. COORDINATE EXACT LOCATION WITH FINAL ARCHITECTURAL REFLECTIVE CEILING PLAN PRIOR TO ROUGH-IN. INSTALL AS PER MANUFACTURER'S INSTRUCTIONS AND DIRECTIONS, PROVIDING ALL ACCESSORIES AND ITEMS REQUIRED. COORDINATE LOCATION WITH ARCHITECT/GENERAL CONTRACTOR PRIOR TO ROUGH-IN.
- 11. INDOOR ONE-WAY THROW CEILING CASSETTE UNIT IN THIS VICINITY. COORDINATE EXACT LOCATION WITH FINAL ARCHITECTURAL REFLECTIVE CEILING PLAN PRIOR TO ROUGH-IN. INSTALL AS PER MANUFACTURER'S INSTRUCTIONS AND DIRECTIONS, PROVIDING ALL ACCESSORIES AND ITEMS REQUIRED. COORDINATE LOCATION WITH ARCHITECT/GENERAL CONTRACTOR PRIOR TO ROUGH-IN.
- 12. INSTALL MITSUBISHI SIMPLE MA THERMOSTAT WHERE SHOWN. LABEL EACH SENSOR TO INDICATE UNIT SERVED. (TYPICAL)
- 13. UNIT SHALL BE CONTROLLED BY TEMPERATURE SENSOR ON UNIT.
- 14. INSTALL MANUAL BALANCING DAMPER AT DUCT TAP SPIN FITTING ABOVE LAY-IN CEILING AND BALANCE TO CFM INDICATED AT GRILLE. DUCT TAPS SHALL BE A MINIMUM OF 12" FROM END OF SUPPLY AIR DUCT. (TYPICAL)
- 15. TYPE "K" HARD COPPER REFRIGERANT PIPING RISES UP EXTERIOR WALL FROM OUTDOOR UNIT TO ASSOCIATED BRANCH CONTROLLER / MSAU. INSTALL ALL TEES, ELBOWS, ETC. PER MANUFACTURER'S RECOMMENDATIONS. COORDINATE EXACT ROUTING WITH MANUFACTURER PRIOR TO ROUGH-IN.
- 16. TYPE "L" SOFT COPPER SHALL BE USED FOR REFRIGERANT LINES FROM BRANCH CONTROLLER TO EACH INDIVIDUAL VRF INDOOR UNIT BEING SERVED BY THAT SYSTEM EXCEPT WHERE LINE SETS CAN BE SEEN FROM BELOW (EXPOSED). REFER TO ARCHITECTURAL CEILING PLAN PRIOR TO ROUGH-INS. INSTALL ALL TEES, ELBOWS, ETC. PER MANUFACTURER'S RECOMMENDATIONS. COORDINATE EXACT ROUTING WITH MANUFACTURER PRIOR TO ROUGH-IN.
- 17. INSTALL BRANCH CONTROLLER ABOVE CEILING IN THIS VICINITY. PROVIDE GALVANIZED DRAIN PAN EXTENDING 4" AROUND UNIT AND VALVES. COORDINATE ACCESS WITH LIGHTING, DUCTWORK, AND CEILING GRID. PROVIDE AND INSTALL BALL VALVE AT EACH BRANCH CONNECTION IN ACCESSIBLE LOCATION ABOVE CEILING PER DETAIL.
- 18. 12"x12" EXHAUST DUCTWORK RISES UP TO EXHAUST HOOD (COOK MODEL GI 12"x12") WHERE SHOWN.
- 19. FAN SHALL BE CONTROLLED BY OCCUPANCY SENSOR WITH 15 MINUTE TIMER.
- 20. INSTALL DEDICATED OUTSIDE AIR SYSTEM ABOVE CEILING WHERE SHOWN. INSTALL UNIT IN GALVANIZED DRAIN PAN EXTENDING 4" AROUND UNIT WITH FLOAT SWITCH. INSTALL FACTORY PROVIDED FILTER RACK ON DOAS UNIT. COORDINATE LOCATION OF UNIT WITH ALL TRADES AND LOCATE FOR MAXIMUM ACCESSIBILITY.
- 21. VRF SYSTEM CONTROLLER. COORDINATE 120 V JUNCTION BOX WITH ELECTRICAL CONTRACTOR PRIOR TO INSTALLATION.
- 22. EXHAUST/OUTSIDE AIR LOUVER (GREENHECK EVH-501D, RUSKIN EME5625, OR APPROVED EQUAL, COLOR SPECIFIED BY ARCHITECT) WITH BIOSCREEN AT SIZE INDICATED IN THIS VICINITY. COORDINATE EXACT LOCATION WITH ARCHITECTURAL ELEVATIONS AND STRUCTURAL DRAWINGS PRIOR TO FABRICATING DUCTWORK. CONTRACTOR SHALL PROVIDE PLENUM BOX FULL SIZE OF LOUVER FOR DUCT CONNECTION.
- 23. INSTALL 2" INSULATED PVC CONDENSATE HEADER AT SIZE INDICATED APPROXIMATELY WHERE SHOWN. CONTRACTOR SHALL EXTEND INSULATED CONDENSATE DRAIN LINES FROM EACH AC UNIT TO CONDENSATE HEADER AND TERMINATE WITH AIR GAP INTO HUB DRAIN. REFER TO DETAIL. PROVIDE CLEAN OUT PLUGS AT EACH END AND CHANGE IN DIRECTION GREATER THAN 45 DEGREES. REFER TO P2.0 FOR LOCATION OF HUB DRAINS.
- 24. INSTALL CONDENSING UNIT ON FACTORY SUPPLIED WALL BRACKET. INSTALL TOP OF UNIT 12" FROM CEILING. COORDINATE LOCATION WITH MANUFACTURER'S RECOMMENDED CLEARANCES.
- 25. INSTALL WALL-MOUNTED MINI-SPLIT UNIT ABOVE DOOR. CONDENSATE DRAIN LINE SHALL TERMINATE INTO CONDENSATE HEADER.
- 26. INSTALL EDGE OF LOUVER 10'-6" FROM EXTERIOR WALL OF NURSING HOME.

ASHE I BROUSSARD I WEINZITTE ARCHITECTS


This drawing and design are the property of Ashe Broussard Weinzittle Architects. They are submitted on the condition that they are not to be used, reproduced, or copied, in whole or in part, or used for furnishing information to others, without the prior written consent of Ashe Broussard Weinzittle Architects. All common law rights of copyright and otherwise are hereby specifically reserved.



REVISIONS		
revision	description	date
1	Addendum No. One	10.15.25

LASALLE GENERAL HOSPITAL		project no. 2024.01
Workforce Capacity and Medical Access Project		drawn by EM
EDA No. 08-79-05595		checked by CC
187 Ninth St. Jena, Louisiana 71342		project date JAN 2025
Email: adginc@adginc.org		sheet contents
MECHANICAL PLAN - PHYSICIAN'S WING		drawing no. M2.0R1

ADG ENGINEERING
 ASSOCIATED DESIGN GROUP, INC.
 3909 W Congress Street, Suite 201
 Lafayette, Louisiana 70506
 Phone: (337) 234-5710
 Email: adginc@adginc.org
 Project No. 24277

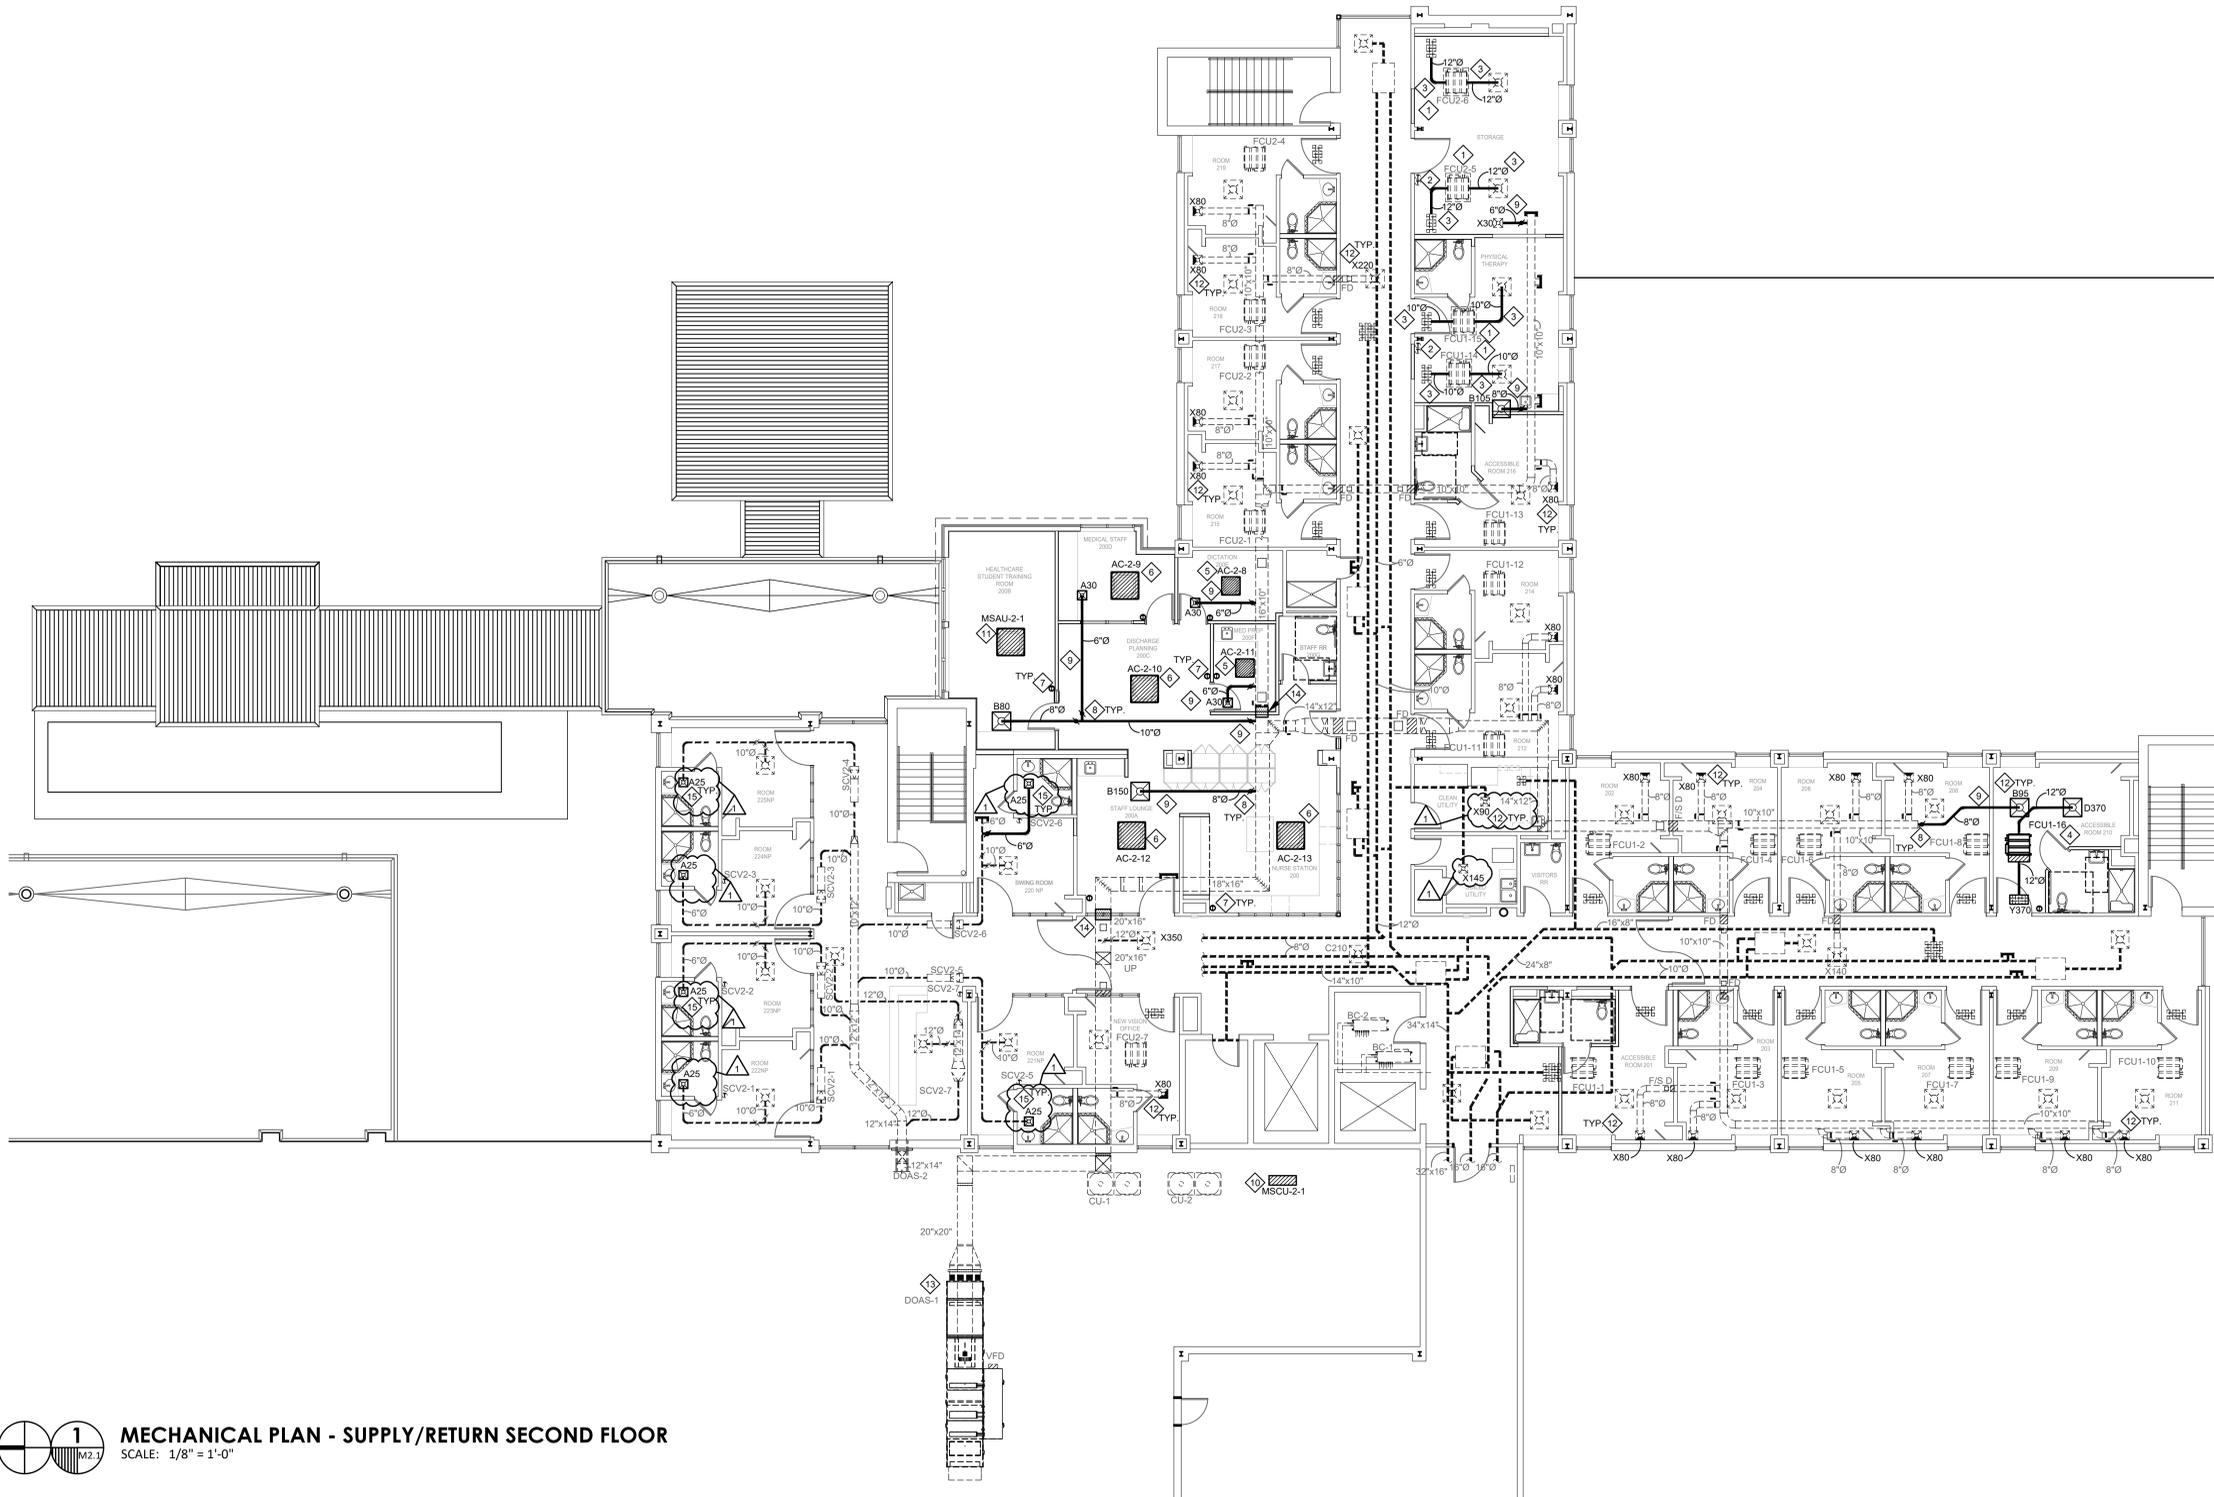

1 MECHANICAL PLAN - SUPPLY/RETURN SECOND FLOOR
SCALE: 1/8" = 1'-0"

GENERAL MECHANICAL NOTES:

- A. ALL WORK SHALL COMPLY WITH LOCAL, STATE, AND FEDERAL CODES TO THE SATISFACTION OF CODE AUTHORITIES HAVING JURISDICTION.
- B. COORDINATE ALL CEILING DEVICES, DUCTWORK, ETC. WITH LIGHTING, STRUCTURAL, ETC. THROUGH GENERAL CONTRACTOR. REFER TO ALL DRAWINGS, (STRUCTURAL, PLUMBING, ELECTRICAL, ARCHITECTURAL, ETC.) NOTIFY ARCHITECT/ENGINEER CONCERNING ANY CONFLICTS NOTED PRIOR TO BIDS FOR CLARIFICATION TO THE SATISFACTION OF THE BIDDER. REFER TO SPECIFICATIONS FOR REQUIREMENTS. REFER TO LATEST ARCHITECTURAL REFLECTED CEILING PLAN. COORDINATE ALL CEILING DEVICE LOCATIONS WITH CEILING GRID.
- C. ALL SUPPLY, RETURN, EXHAUST, AND OUTSIDE AIR DUCTWORK SHALL BE EXTERNALLY INSULATED UNLESS NOTED OTHERWISE ON DRAWINGS. DUCT SIZES SHOWN ARE CLEAR METAL TO METAL. WRAP ALL DUCTWORK EXTERNALLY.
- D. HARDCAST ALL NEW DUCTWORK JOINTS FOR AIRTIGHT SYSTEM. REFER TO DETAILS FOR DUCTWORK TAP, SPLITTER, BRANCH CONFIGURATION, ETC. INSTALL IN ACCORDANCE WITH SMACNA RECOMMENDATIONS AND INSTALLATION GUIDELINES.
- E. VERIFY ALL OUTSIDE AIR INTAKES ARE A MINIMUM OF TEN FEET FROM EXHAUST OUTLETS, SEWER VENTS, ETC.
- F. CONTRACTOR SHALL SEAL ALL PIPING AND DUCT PENETRATIONS THROUGH WALLS AND FLOORS AS PER THE RATED UL DESIGNATIONS REQUIREMENTS. REFER TO ARCHITECTURAL PLANS FOR ALL UL RATINGS.
- G. PROVIDE ACCESS PANELS (PER SPECIFICATIONS) AS NEEDED FOR ACCESS TO ALL NEW FIRE DAMPERS, MANUAL DAMPERS, AND MOTORIZED DAMPERS. COORDINATE FINAL LOCATION/SIZE WITH ENGINEER/OWNER. ALL DAMPERS, ACCESS PANELS, ETC. SHALL BE INSTALLED FOR MAXIMUM ACCESSIBILITY.
- H. CONTRACTOR SHALL CAP AND SEAL ALL DUCTWORK DURING CONSTRUCTION TO PREVENT CONTAMINATION DUE TO CONSTRUCTION DEBRIS.

MECHANICAL KEYNOTES:

- 1. RE-INSTALL EXISTING CONCEALED TYPE VRF INDOOR UNIT AND ASSOCIATED ACCESSORIES (DRAINS, DRAIN PANS, FILTER RACKS, ETC.) WHERE SHOWN.
- 2. RE-INSTALL EXISTING THERMOSTAT WHERE SHOWN.
- 3. EXTEND NEW DUCTWORK AS SHOWN FOR EXISTING VRF INDOOR UNITS.
- 4. PROVIDE AND INSTALL NEW CONCEALED TYPE VRF INDOOR UNIT WHERE INDICATED WITH EMERGENCY DRAIN PAN AND FLOAT SWITCH. PROVIDE RECOMMENDED CLEARANCE AROUND NEW UNIT. INSTALL AS PER MANUFACTURER'S INSTRUCTIONS AND DIRECTIONS, PROVIDING ALL ACCESSORIES, FACTORY PROVIDED FILTER, AND ITEMS REQUIRED. COORDINATE LOCATION WITH ARCHITECT/GENERAL CONTRACTOR PRIOR TO ROUGH-IN.
- 5. PROVIDE AND INSTALL AN INDOOR 2X2' 4-WAY AIRFLOW CEILING CASSETTE UNIT IN CEILING GRID IN THIS VICINITY. COORDINATE EXACT LOCATION WITH FINAL ARCHITECTURAL REFLECTIVE CEILING PLAN PRIOR TO ROUGH-IN. INSTALL AS PER MANUFACTURER'S INSTRUCTIONS AND DIRECTIONS, PROVIDING ALL ACCESSORIES AND ITEMS REQUIRED. COORDINATE LOCATION WITH ARCHITECT/GENERAL CONTRACTOR PRIOR TO ROUGH-IN.
- 6. PROVIDE AND INSTALL AN INDOOR 3X3' 4-WAY AIRFLOW CEILING CASSETTE UNIT IN CEILING GRID IN THIS VICINITY. COORDINATE EXACT LOCATION WITH FINAL ARCHITECTURAL REFLECTIVE CEILING PLAN PRIOR TO ROUGH-IN. INSTALL AS PER MANUFACTURER'S INSTRUCTIONS AND DIRECTIONS, PROVIDING ALL ACCESSORIES AND ITEMS REQUIRED. COORDINATE LOCATION WITH ARCHITECT/GENERAL CONTRACTOR PRIOR TO ROUGH-IN.
- 7. INSTALL MITSUBISHI SIMPLE MA THERMOSTAT WHERE SHOWN. LABEL EACH SENSOR TO INDICATE UNIT SERVED. (TYPICAL)
- 8. INSTALL MANUAL BALANCING DAMPER AT DUCT TAP SPIN FITTING ABOVE LAY-IN CEILING AND BALANCE TO CFM INDICATED AT GRILLE. DUCT TAPS SHALL BE A MINIMUM OF 12" FROM END OF SUPPLY AIR DUCT. (TYPICAL)
- 9. CONNECT NEW DUCTWORK TO EXISTING OUTSIDE AIR DUCTWORK WHERE SHOWN.
- 10. INSTALL NEW MINI-SPLIT CONDENSING UNIT ON ROOF SLEEPER SUPPORTS. SECURE UNIT TO ROOF SLEEPER RIGIDLY THROUGH UNIT ANCHOR POINTS PER MANUFACTURER'S RECOMMENDATIONS. REFERENCE ARCHITECTURAL DETAILS FOR ROOF SUPPORT.
- 11. INSTALL 3X3' MINI-SPLIT INDOOR UNIT IN CEILING WHERE SHOWN.
- 12. BALANCE OUTSIDE AIR GRILLE TO CFM SHOWN. (TYPICAL)
- 13. EXISTING DOAS-1 SHALL BE BALANCED TO 2,700 CFM. REBALANCE ALL ASSOCIATED GRILLES TO CFM SHOWN. BALANCE PREHEAT COIL TO 9.1 GPM. BALANCE COOLING COIL TO 49.3 GPM. BALANCE REHEAT COIL TO 6.6 GPM.
- 14. PATCH DUCTWORK WHERE SHOWN.
- 15. INSTALL NEW DIFFUSER IN NEW CEILING GRID IN RESTROOMS APPROXIMATELY WHERE SHOWN. (TYPICAL)

ASHE | BROUSSARD | WEINZITTE
ARCHITECTS

This drawing and design are the property of Ashe Broussard Weinzittle Architects. They are submitted on the condition that they are not to be used, reproduced, or copied in whole or in part, or used for furnishing information to others, without the prior written consent of Ashe Broussard Weinzittle Architects. All common law rights of copyright and otherwise are hereby specifically reserved.




REVISIONS		
revision	description	date
1	Addendum No. One	10.15.25

LASALLE GENERAL HOSPITAL		project no. 2024.01
Workforce Capacity and Medical Access Project		drawn EM
EDA No. 08-79-05595		checked CC
187 Ninth St. Jena, Louisiana 71342		project date JAN 2025
sheet contents MECHANICAL PLAN - SUPPLY/RETURN SECOND FLOOR		drawing no. M2.1R1



ASSOCIATED DESIGN GROUP, INC.
3909 W Congress Street, Suite 201
Lafayette, Louisiana 70506
Phone: (337) 234-5710
Email: adginc@adginc.org
Project No. 24277

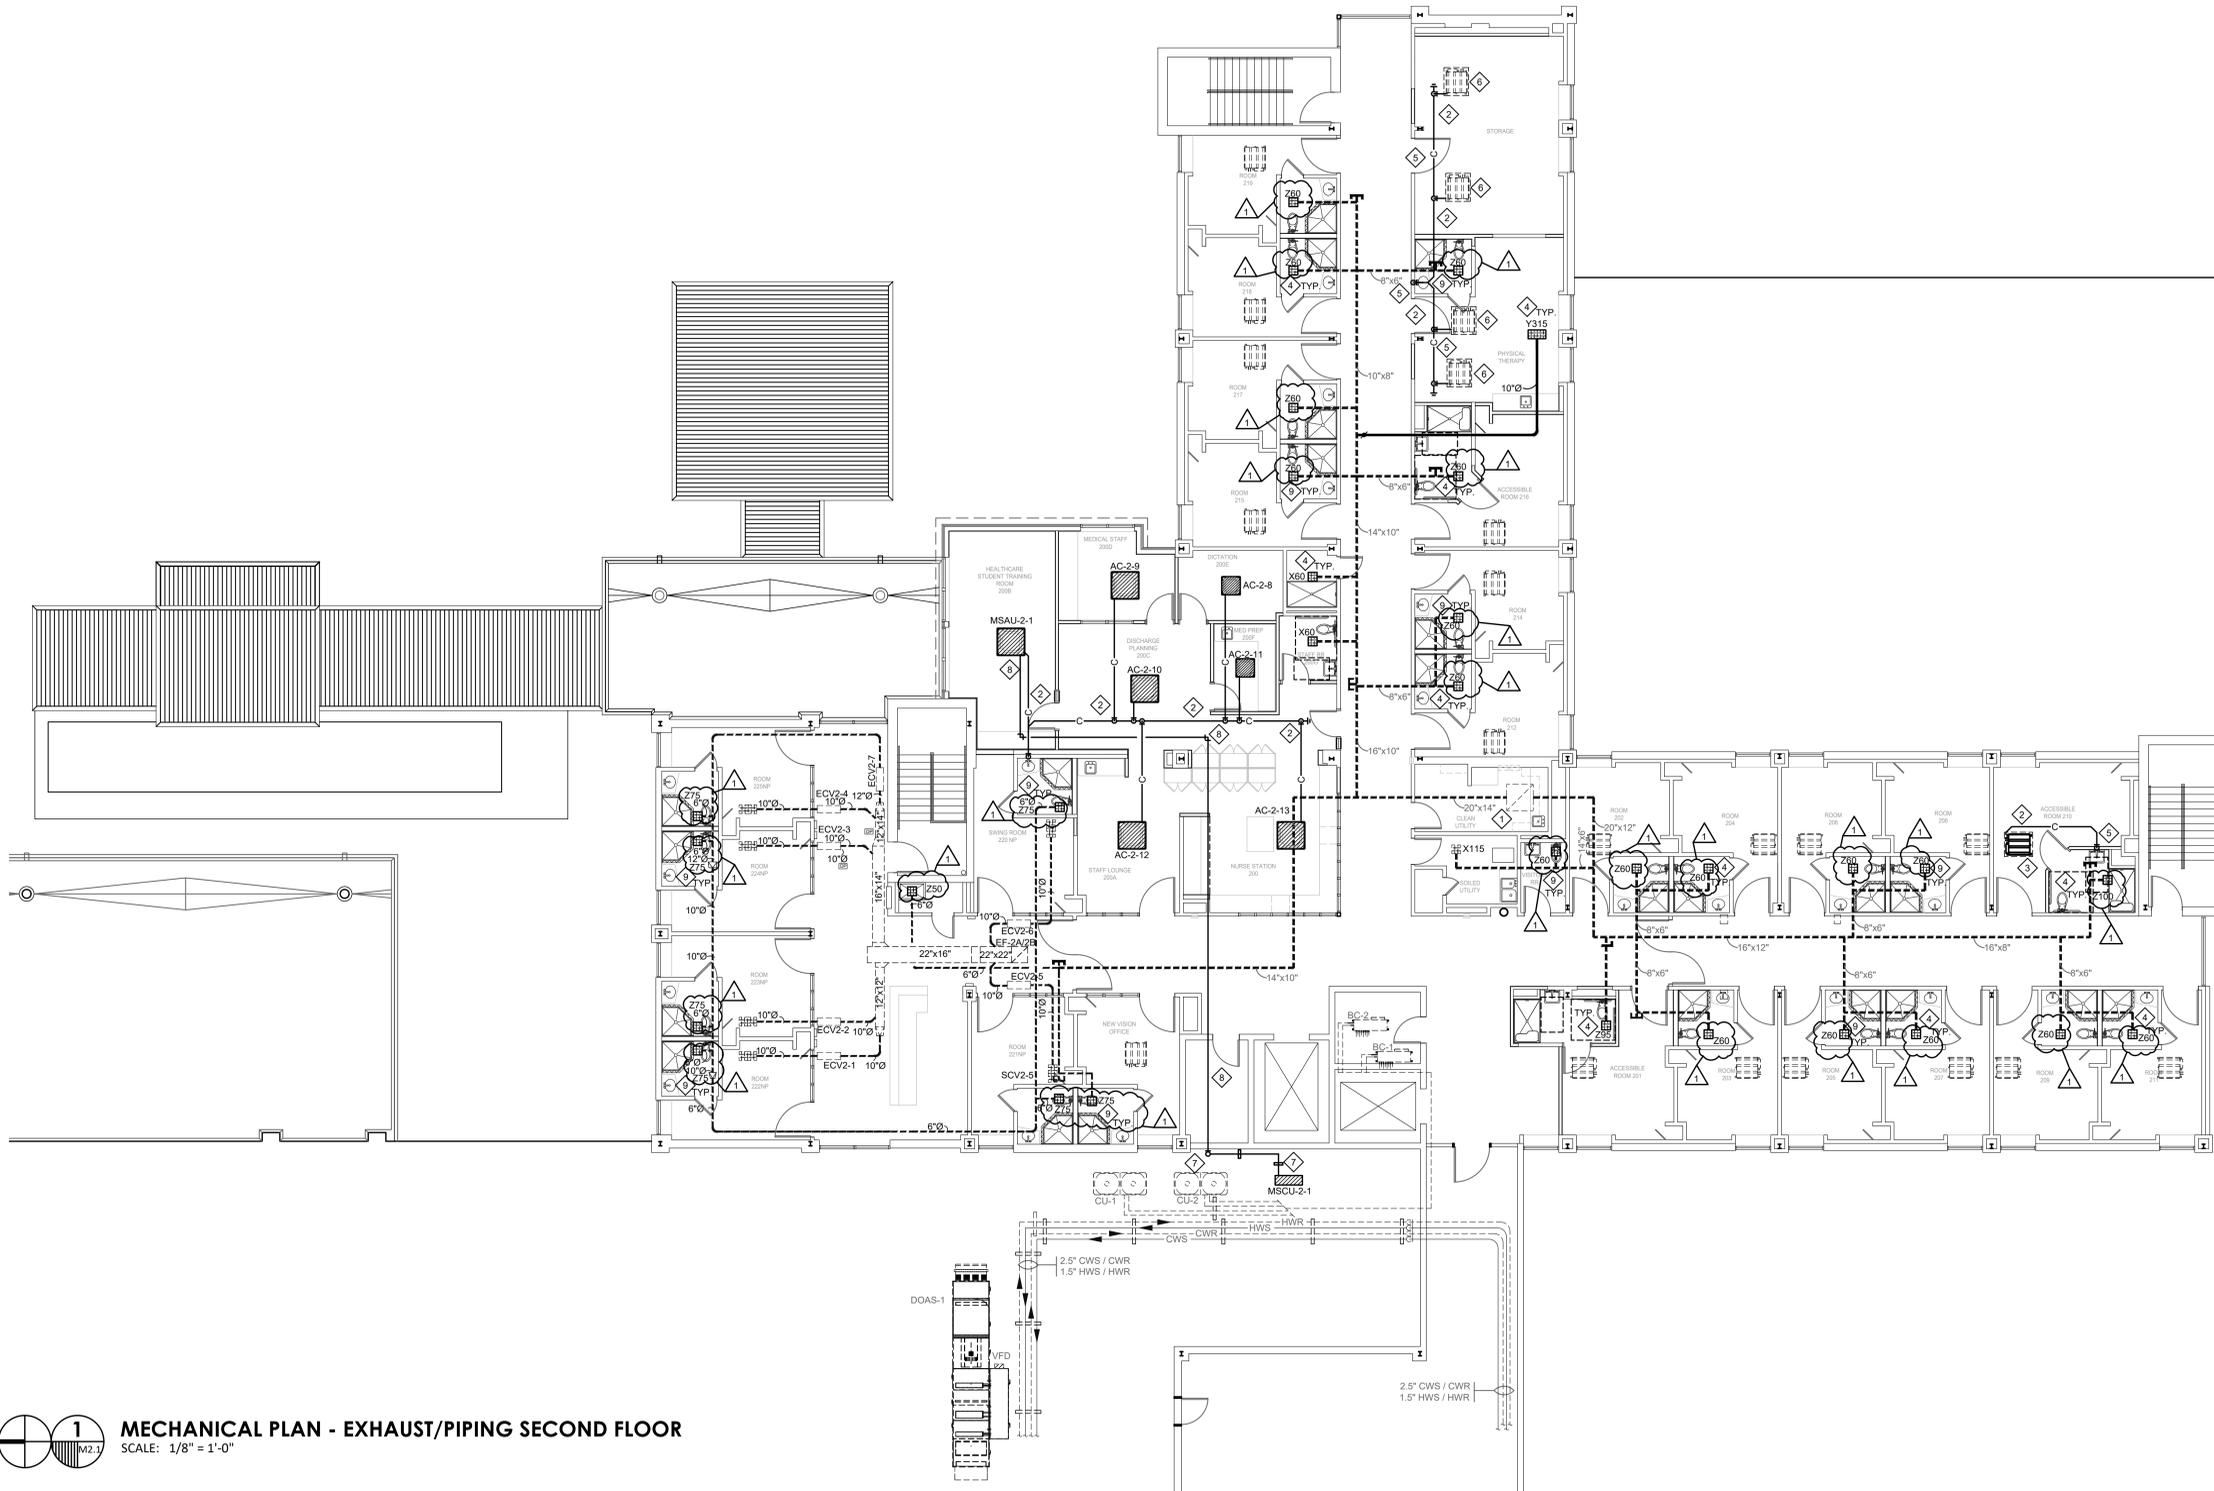

1 MECHANICAL PLAN - EXHAUST/PIPING SECOND FLOOR
 SCALE: 1/8" = 1'-0"

GENERAL MECHANICAL NOTES:

- A. ALL WORK SHALL COMPLY WITH LOCAL, STATE, AND FEDERAL CODES TO THE SATISFACTION OF CODE AUTHORITIES HAVING JURISDICTION.
- B. COORDINATE ALL CEILING DEVICES, DUCTWORK, ETC. WITH LIGHTING, STRUCTURAL, ETC. THROUGH GENERAL CONTRACTOR. REFER TO ALL DRAWINGS, (STRUCTURAL, PLUMBING, ELECTRICAL, ARCHITECTURAL, ETC.) NOTIFY ARCHITECT/ENGINEER CONCERNING ANY CONFLICTS NOTED PRIOR TO BIDS FOR CLARIFICATION TO THE SATISFACTION OF THE BIDDER. REFER TO SPECIFICATIONS FOR REQUIREMENTS. REFER TO LATEST ARCHITECTURAL REFLECTED CEILING PLAN. COORDINATE ALL CEILING DEVICE LOCATIONS WITH CEILING GRID.
- C. ALL SUPPLY, RETURN, EXHAUST, AND OUTSIDE AIR DUCTWORK SHALL BE EXTERNALLY INSULATED UNLESS NOTED OTHERWISE ON DRAWINGS. DUCT SIZES SHOWN ARE CLEAR METAL TO METAL. WRAP ALL DUCTWORK EXTERNALLY.
- D. HARDCAST ALL NEW DUCTWORK JOINTS FOR AIRTIGHT SYSTEM. REFER TO DETAILS FOR DUCTWORK TAP, SPLITTER, BRANCH CONFIGURATION, ETC. INSTALL IN ACCORDANCE WITH SMACNA RECOMMENDATIONS AND INSTALLATION GUIDELINES.
- E. VERIFY ALL OUTSIDE AIR INTAKES ARE A MINIMUM OF TEN FEET FROM EXHAUST OUTLETS, SEWER VENTS, ETC.
- F. CONTRACTOR SHALL SEAL ALL PIPING AND DUCT PENETRATIONS THROUGH WALLS AND FLOORS AS PER THE RATED UL DESIGNATIONS REQUIREMENTS. REFER TO ARCHITECTURAL PLANS FOR ALL UL RATINGS.
- G. PROVIDE ACCESS PANELS (PER SPECIFICATIONS) AS NEEDED FOR ACCESS TO ALL NEW FIRE DAMPERS, MANUAL DAMPERS, AND MOTORIZED DAMPERS. COORDINATE FINAL LOCATION/SIZE WITH ENGINEER/OWNER. ALL DAMPERS, ACCESS PANELS, ETC. SHALL BE INSTALLED FOR MAXIMUM ACCESSIBILITY.
- H. CONTRACTOR SHALL CAP AND SEAL ALL DUCTWORK DURING CONSTRUCTION TO PREVENT CONTAMINATION DUE TO CONSTRUCTION DEBRIS.

MECHANICAL KEYNOTES:

- 1 REBALANCE EXHAUST FAN ON ROOF TO 1950 CFM.
- 2 INSTALL 2" INSULATED PVC CONDENSATE HEADER AT SIZE INDICATED APPROXIMATELY WHERE SHOWN. CONTRACTOR SHALL EXTEND INSULATED CONDENSATE DRAIN LINES FROM EACH AC UNIT TO CONDENSATE HEADER AND TERMINATE WITH AIR GAP. REFER TO DETAIL. PROVIDE CLEAN OUT PLUGS AT EACH END AND CHANGE IN DIRECTION GREATER THAN 45 DEGREES. REFER TO SHEET P2.01 FOR EXACT LOCATION OF HUB DRAIN.
- 3 INSTALL HORIZONTAL AIR HANDLING UNIT ABOVE CEILING IN EMERGENCY DRAIN PAN. EMERGENCY DRAIN PAN SHALL EXTEND 4" ALL AROUND PERIMETER OF UNIT WITH A 3/4" INSULATED COPPER EMERGENCY DRAIN PIPE WITH BALL VALVE (NC). EXTEND INSULATED COPPER CONDENSATE DRAIN LINE TO HUB DRAIN AND TERMINATE DOWN WITH 2" AIR GAP. PROVIDE FLOAT SWITCH IN EMERGENCY DRAIN PAN AND INTERLOCK WITH AHU FAN MOTOR. INSTALL FACTORY SUPPLIED FILTER RACK.
- 4 BALANCE EXHAUST GRILLES TO CFM SHOWN. (TYPICAL)
- 5 RE-ROUTE CONDENSATE FROM EXISTING/NEW INDOOR VRF UNIT TO HUB DRAIN. REFER TO SHEET P2.01 FOR EXACT LOCATION OF HUB DRAIN.
- 6 RE-INSTALL EXISTING VRF INDOOR UNIT IN EMERGENCY DRAIN PAN.
- 7 ROUTE TYPE "K" HARD COPPER REFRIGERANT PIPING ON MAPA MB SERIES ROOF SUPPORTS. PIPING RISES EXTERIOR WALL AND PENETRATES BUILDING WHERE SHOWN.
- 8 ROUTE TYPE "K" HARD COPPER REFRIGERANT PIPING AT MAX HEIGHT ABOVE CEILING. INSTALL ALL TEES, ELBOWS, ETC. PER MANUFACTURER'S RECOMMENDATIONS. COORDINATE EXACT ROUTING WITH MANUFACTURER'S RECOMMENDATIONS. COORDINATE EXACT ROUTING WITH MANUFACTURER PRIOR TO ROUGH-IN.
- 9 INSTALL NEW GRILLE IN NEW CEILING GRID IN RESTROOMS APPROXIMATELY WHERE SHOWN. (TYPICAL)

ASHE I BROUSSARD I WEINZITTE
 ARCHITECTS

This drawing and design are the property of Ashe Broussard Weinzitte Architects. They are submitted on the condition that they are not to be used, reproduced, or copied in whole or in part, or used for furnishing information to others, without the prior written consent of Ashe Broussard Weinzitte Architects. All common law rights of copyright and otherwise are hereby specifically reserved.



REVISIONS		
revision	description	date
1	Addendum No. One	10.15.25

LASALLE GENERAL HOSPITAL		project no. 2024.01
Workforce Capacity and Medical Access Project		drawn by EM
EDA No. 08-79-05595		checked by CC
187 Ninth St. Jena, Louisiana 71342		project date JAN 2025
sheet contents MECHANICAL PLAN - EXHAUST/PIPING SECOND FLOOR		drawing no. M2.2R1



ASSOCIATED DESIGN GROUP, INC.
 3909 W Congress Street, Suite 201
 Lafayette, Louisiana 70506
 Phone: (337) 234-5710
 Email: adginc@adginc.org
 Project No. 24277

MITSUBISHI ELECTRIC TRANE HVAC US: CITY MULTI VRF INDOOR UNIT SCHEDULE

SYSTEM TAG	ROOM NAME	TAG REFERENCE	MODEL	TYPE	NOMINAL COOLING CAPACITY (BTU/H)	NOMINAL HEATING CAPACITY (BTU/H)	COOLING DESIGN ENTERING TEMP DB(WB)(F)	HEATING DESIGN ENTERING TEMP DB(WB)(F)	CORRECTED COOLING CAPACITY		HEATING DIVERSITY FULL/PARTIAL	HEATING CAPACITY (BTU/H)	PEAK FAN AIRFLOW (CFM)	VOLTAGE / PHASE	POWER COOLING 208V(KW)	POWER HEATING 208V(KW)	ELECTRICAL MCA/MFS	NOTES	
									COOLING DIVERSITY FULL/PARTIAL	COOLING TOTAL CAPACITY (BTU/H)									
CU-DOAS-5	STORAGE 106	DOAS-5	PEFY-AF120CFMR-E	DOAS CEILING (CONCEALED)	112,000	61,400	80.0/67.0	70	FULL DEMAND	115,658.7	11,264.0	FULL DEMAND	53,730.1	1200	208/1/60	0.66	0.66	0.36/0.36/15	2.3,4.5,6,7,8,9
CU-6	ACCESSIBLE SUITE 101	AC-1-1	PLFY-P15NEMU-E	CEILING-CASSETTE (FOUR-WAY)	15,000	17,000	80.0/67.0	70	FULL DEMAND	11,264.0	9,924.2	FULL DEMAND	6,771.1	600	208/1/60	0.02	0.02	0.36/0.36/15	2.3,4.5,6,7,8,9
CU-6	SUITE 102	AC-1-2	PLFY-P15NEMU-E	CEILING-CASSETTE (FOUR-WAY)	15,000	17,000	80.0/67.0	70	FULL DEMAND	11,264.0	9,924.2	FULL DEMAND	6,771.1	600	208/1/60	0.02	0.02	0.36/0.36/15	2.3,4.5,6,7,8,9
CU-6	SUITE 103	AC-1-3	PLFY-P15NEMU-E	CEILING-CASSETTE (FOUR-WAY)	15,000	17,000	80.0/67.0	70	FULL DEMAND	11,264.0	9,924.2	FULL DEMAND	6,771.1	600	208/1/60	0.02	0.02	0.36/0.36/15	2.3,4.5,6,7,8,9
CU-6	SUITE 104	AC-1-4	PLFY-P15NEMU-E	CEILING-CASSETTE (FOUR-WAY)	15,000	17,000	80.0/67.0	70	FULL DEMAND	11,264.0	9,924.2	FULL DEMAND	6,771.1	600	208/1/60	0.02	0.02	0.36/0.36/15	2.3,4.5,6,7,8,9
CU-6	SUITE 105	AC-1-5	PLFY-P15NEMU-E	CEILING-CASSETTE (FOUR-WAY)	15,000	17,000	80.0/67.0	70	FULL DEMAND	11,264.0	9,924.2	FULL DEMAND	6,771.1	600	208/1/60	0.02	0.02	0.36/0.36/15	2.3,4.5,6,7,8,9
CU-6	STORAGE 106	AC-1-6	PLFY-P15NEMU-E	CEILING-CASSETTE (FOUR-WAY)	15,000	17,000	80.0/67.0	70	FULL DEMAND	11,264.0	9,924.2	FULL DEMAND	6,771.1	600	208/1/60	0.02	0.02	0.36/0.36/15	2.3,4.5,6,7,8,9
CU-6	CORRIDOR 107	AC-1-7	PMFY-P12NBMU-ERS	CEILING-CASSETTE (ONE-WAY)	12,000	13,500	80.0/67.0	70	FULL DEMAND	10,802.7	7,391.8	FULL DEMAND	8,791.9	328	208/1/60	0.04	0.04	0.28/15	2.3,4.5,6,7,8,9
CU-6	CORRIDOR 107	AC-1-8	PMFY-P12NBMU-ERS	CEILING-CASSETTE (ONE-WAY)	12,000	13,500	80.0/67.0	70	FULL DEMAND	10,802.7	7,391.8	FULL DEMAND	8,791.9	328	208/1/60	0.04	0.04	0.28/15	2.3,4.5,6,7,8,9
CU-6	ELECTRICAL CLOSET 100A	AC-1-9	PKFY-P12NHMU-E	WALL-MOUNTED	12,000	N/A	80.0/67.0	N/A	FULL DEMAND	10,802.7	8,132.8	N/A	N/A	388	208/1/60	0.03	0.03	0.38/0.38/15	1.3,4.5,7,8,9
MSCU-1-1	NETWORK CLOSET 100B	MSAU-1-1	PKA-A18H4	WALL-MOUNTED	18,000	N/A	80.0/67.0	N/A	FULL DEMAND	17,623.9	12,076.8	N/A	N/A	425	N/A	N/A	N/A	POWERED BY OUTDOOR UNIT	1.3,4.5,7,8,9
HRCU-1	PATIENT ROOM 210	FCU-1-16	PEFY-P12NMSU-ER2	CEILING-CONCEALED (DUCTED)	11,900	13,600	80.0/67.0	70	FULL DEMAND	9,521.3	7,657.0	FULL DEMAND	8,363.5	371	208/1/60	0.07	0.05	0.68/0.74/15	1.2,3,4,5,6,7,8
HRCU-2	DICTATION 200E	AC-2-8	PLFY-P06NFMU-E	CEILING-CASSETTE (FOUR-WAY)	5,000	5,600	80.0/67.0	70	FULL DEMAND	4,291.2	4,122.2	FULL DEMAND	3,746.1	280	208/1/60	0.02	0.02	0.24/0.24/15	1.2,3,4,5,6,7,8
HRCU-2	MEDICAL STAFF 200D	AC-2-9	PLFY-EP15NEMU-E	CEILING-CASSETTE (FOUR-WAY)	15,000	17,000	80.0/67.0	70	FULL DEMAND	12,873.5	10,531.4	FULL DEMAND	11,372.1	600	208/1/60	0.03	0.02	0.39/0.39/15	1.2,3,4,5,6,7,8
HRCU-2	DISCHARGE PLANNING 200C	AC-2-10	PLFY-EP08NEMU-E	CEILING-CASSETTE (FOUR-WAY)	8,000	9,000	80.0/67.0	70	FULL DEMAND	6,865.9	6,020.4	FULL DEMAND	6,020.5	600	208/1/60	0.03	0.02	0.39/0.39/15	1.2,3,4,5,6,7,8
HRCU-2	MED PREP 200F	AC-2-11	PLFY-P06NFMU-E	CEILING-CASSETTE (FOUR-WAY)	5,000	5,600	80.0/67.0	70	FULL DEMAND	4,291.2	4,122.2	FULL DEMAND	3,746.1	280	208/1/60	0.02	0.02	0.24/0.24/15	1.2,3,4,5,6,7,8
HRCU-2	STAFF LOUNGE 200A	AC-2-12	PLFY-EP08NEMU-E	CEILING-CASSETTE (FOUR-WAY)	8,000	9,000	80.0/67.0	70	FULL DEMAND	6,865.9	6,112.9	FULL DEMAND	6,020.5	530	208/1/60	0.02	0.02	0.31/1/15	1.2,3,4,5,6,7,8
HRCU-2	NURSE STATION 200	AC-2-13	PLFY-EP18NEMU-E	CEILING-CASSETTE (FOUR-WAY)	18,000	20,000	80.0/67.0	70	FULL DEMAND	15,448.2	12,449.4	FULL DEMAND	13,379.0	636	208/1/60	0.03	0.02	0.43/0.43/15	1.2,3,4,5,6,7,8
MSCU-2-1	HEALTHCARE TRAINING 200B	MSAU-2-1	PLA-A24B4	CEILING-CASSETTE (FOUR-WAY)	24,000	26,000	80.0/67.0	70	FULL DEMAND	25,277.7	18,063.9	FULL DEMAND	17,038.1	640	N/A	N/A	N/A	POWERED BY OUTDOOR UNIT	1.2,3,4,5,6,7,8

- NOTES:**
- NOMINAL COOLING CAPACITIES ARE BASED ON INDOOR COIL EAT 80/67°F (DBWB), OUTDOOR OF 95°F (DB).
 - NOMINAL HEATING CAPACITIES ARE BASED ON INDOOR COIL EAT OF 70°F (DB), OUTDOOR OF 43°F (WB).
 - SEE OUTDOOR UNIT SCHEDULE FOR OUTDOOR AMBIENT CONDITIONS, CONNECTED CAPACITY, AND OTHER FACTORIES ASSOCIATED WITH CORRECTED CAPACITIES.
 - SEE SCHEMATIC PIPING/CONTROL DIAGRAM FOR INDICATION OF REQUIRED INDOOR UNIT REMOTE CONTROLLERS, SYSTEM CONTROLLERS, AND INTEGRATION DEVICES.
 - FULL DEMAND CORRECTED CAPACITY INCLUDES DE-RATE ASSOCIATED WITH INDOOR VS. OUTDOOR CONNECTED CAPACITY INDICATED ON OUTDOOR UNIT SCHEDULE FOR ASSOCIATED SYSTEM. PARTIAL CAPACITY ASSUMES SUFFICIENT EXISTING SUCH THAT THE CONNECTED CAPACITY DE-RATE DOES NOT APPLY. IT IS THE MANUFACTURER'S RESPONSIBILITY TO ENSURE "DIAMOND SYSTEM BUILDING" IS SET IN THE APPROPRIATE OUTPUT CAPACITY SETTING (FULL DEMAND/PARTIAL DEMAND) PRIOR TO GENERATING THIS SCHEDULE.
 - IT IS RECOMMENDED TO ALWAYS BASE HEATING CAPACITY ON FULL DEMAND.
 - UNIT SHALL BE PROVIDED WITH BIPOLE IONIZATION (PLASMA AIR MODEL 600 OR APPROVED EQUAL).
 - PROVIDE TWO SETS OF WASHABLE FILTERS FOR ALL CEILING CASSETTES AND WALL HUNG UNITS.
 - EQUIPMENT IS PART OF ALTERNATE #1.

FAN SCHEDULE

No	SERVICE	MIN CFM	EXT. SP	RPM	SONES	FAN HP	TYPE	DRIVE	ELECTRIC SERVICE	CONTROL	REMARKS	NOTES
EF-1-1	SUITE 1 RR	70	0.25"	729	1	30 W	CEILING	DIRECT	120/1/60	OCC SENSOR	COOK MODEL GC-148 OR APPROVED EQUIVALENT	1.2,3
EF-1-2	SUITE 2 RR	70	0.25"	729	1	30 W	CEILING	DIRECT	120/1/60	OCC SENSOR	COOK MODEL GC-148 OR APPROVED EQUIVALENT	1.2,3
EF-1-3	SUITE 3 RR	70	0.25"	729	1	30 W	CEILING	DIRECT	120/1/60	OCC SENSOR	COOK MODEL GC-148 OR APPROVED EQUIVALENT	1.2,3
EF-1-4	SUITE 4 RR	70	0.25"	729	1	30 W	CEILING	DIRECT	120/1/60	OCC SENSOR	COOK MODEL GC-148 OR APPROVED EQUIVALENT	1.2,3
EF-1-5	SUITE 5 RR	70	0.25"	729	1	30 W	CEILING	DIRECT	120/1/60	OCC SENSOR	COOK MODEL GC-148 OR APPROVED EQUIVALENT	1.2,3

- NOTES:**
- FANS SHALL HAVE W.B.E. GRILLE, BACKDRAFT DAMPER, S.S.S.C., AND MOUNTING BRACKETS.
 - OCCUPANCY SENSOR WITH 15 MINUTE TIMER TO BE PROVIDED BY DIVISION 23 CONTRACTOR AND INSTALLED BY DIVISION 26 CONTRACTOR.
 - EQUIPMENT IS PART OF ALTERNATE #1.

GRILLE SCHEDULE

SYMBOL	SIZE	SERVICE	LOCATION	FINISHED	REMARKS	NOTES
A	12"x12"	SUPPLY	CEILING	BY ARCH	TITUS MODEL TMS-AA, 3 CONE, W/ 6" NECK OR APPROVED EQUAL	1, 3, 4
B	24"x24"	SUPPLY	CEILING	BY ARCH	TITUS MODEL TMS-AA, 3 CONE, W/ 8" NECK OR APPROVED EQUAL	1, 3, 4
C	24"x24"	SUPPLY	CEILING	BY ARCH	TITUS MODEL TMS-AA, 3 CONE, W/ 10" NECK OR APPROVED EQUAL	1, 3, 4
D	24"x24"	SUPPLY	CEILING	BY ARCH	TITUS MODEL TMS-AA, 3 CONE, W/ 12" NECK OR APPROVED EQUAL	1, 3, 4
X					EXISTING GRILLE TO REMAIN	
W	24"x24"	R/A E/A	CEILING	BY ARCH	TITUS MODEL 50F, EGGCRATE GRILLE W/ REMOVABLE CORE OR APPROVED EQUAL	2, 4
Y	24"x12"	R/A E/A	CEILING	BY ARCH	TITUS MODEL 50F, EGGCRATE GRILLE W/ REMOVABLE CORE OR APPROVED EQUAL	2, 4
Z	12"x12"	R/A E/A	CEILING	BY ARCH	TITUS MODEL 50F, EGGCRATE GRILLE W/ REMOVABLE CORE OR APPROVED EQUAL	2, 4

- NOTES:**
- TOPS OF ROUND NECK DIFFUSERS SHALL BE INSULATED. REFER TO DETAIL.
 - SHEET METAL CONTRACTOR TO PROVIDE SHEET METAL CEILING BOX FOR ATTACHMENT OF RECTANGLE DUCTWORK TO R/A/E/A AIR REGISTER.
 - ALL SUPPLY DIFFUSERS SHALL BE 4-WAY PATTERN UNLESS SHOWN OTHERWISE ON PLANS OR REQUIRED AS PER DETAIL.
 - DIFFUSERS/GRILLES SHALL BE PROVIDED WITH ALL ACCESSORIES/OPTIONS REQUIRED FOR COMPLETE INSTALLATION IN EACH CEILING TYPE. REFER TO ARCHITECTURAL REFLECTED CEILING PLAN.

MITSUBISHI ELECTRIC TRANE HVAC US: CITY MULTI VRF OUTDOOR UNIT SCHEDULE

SYSTEM TAG	TAG REFERENCE	MODEL NUMBER	MODULES	NOMINAL COOLING CAPACITY (BTU/H)	NOMINAL HEATING CAPACITY (BTU/H)	COOLING EFFICIENCY IEER/IEER (SEER)	HEATING COP @ 47°F (HSPF)	NOM SYSTEM CONNECTED CAPACITY (% OF NOM)	DESIGN COOLING OUTDOOR TEMP DB (°F)	DESIGN HEATING OUTDOOR TEMP DB (°F)	CORRECTED COOLING TOTAL CAPACITY (BTU/H)	CORRECTED HEATING TOTAL CAPACITY (BTU/H)	INVERTER DRIVEN COMPRESSOR TYPE / QUANTITY	ELECTRICAL-POWER MODULE				NOTES
														VOLTAGE / PHASE	MCA	RFS	MCCP	
CU-DOAS-5	CU-DOAS-5	PURY-P120YNU-A	P120	120,000	135,000	0	0	100.0%	95.0	21.2	124,263.4	106,613.1	SCROLL/1	460V/3-PHASE 3 WIRE	25	25	40	1.2,3,4,5,6,7,8,9
CU-6	CU-6	PURY-EP120YNU-A	EP120	120,000	135,000	22.35/10.5	3.875	105.0%	95.0	21.2	112,613.4	92,615.1	SCROLL/1	460V/3-PHASE 3 WIRE	26	N/A	40	1.2,3,4,5,6,7,8,9
MSCU-1-1	MSCU-1-1	PUZ-A18NH4	N/A	18,000	19,000	0	0	100.0%	95.0	21.2	17,623.9	12,258.3	N/A	208/230V/1-PHASE	18	25	30	1.2,3,4,5,6,7,8,9
MSCU-2-1	MSCU-2-1	PUZ-A24NH4	N/A	24,000	26,000	0	0	100.0%	95.0	21.2	25,277.7	17,038.1	N/A	208/230V/1-PHASE	13	15	20	1.2,3,4,5,7,8,9
HRCU-1 (EX)	HRCU-1	PURY-P96YKMU-A	P96	96,000	108,000	20.9/13.3	3.710	118.8%	95.0	21.2	90,892.2	78,838.4	SCROLL/1	460V/3-PHASE 3 WIRE	15	20	26	8
HRCU-2 (EX)	HRCU-2	PURY-P96YKMU-A	P96	96,000	108,000	20.9/13.3	3.710	109.4%	95.0	21.2	90,200.4	78,936.0	SCROLL/1	460V/3-PHASE 3 WIRE	15	20	26	8

- NOTES:**
- NOMINAL COOLING CAPACITIES ARE BASED ON INDOOR COIL EAT 80/67°F (DBWB), OUTDOOR OF 95°F (DB).
 - NOMINAL HEATING CAPACITIES ARE BASED ON INDOOR COIL EAT OF 70°F (DB), OUTDOOR OF 43°F (WB).
 - EFFICIENCY VALUES FOR IEER, IEER, COP ARE BASED ON AHRI 1230 TEST METHOD FOR MIXTURE OF DUCTED AND NON-DUCTED UNITS.
 - FOR SYSTEMS WITH MULTIPLE MODULES, REFRIGERANT PIPE DIMENSIONS INDICATED TOTAL SYSTEM COMBINED PIPING DOWNSTREAM OF MODULE TWINNING.
 - ADDED FIELD CHARGE LISTED IS IN ADDITION TO FACTORY CHARGE. THIS MUST BE UPDATED BASED UPON FINAL AS-BUILT PIPING LAYOUT.
 - PROVIDE A IMC450 PROGRAMMABLE THREE PHASE VOLTAGE MONITOR WITH 25 FAULT MEMORY ON ALL EQUIPMENT REQUIRING THREE PHASE ELECTRICAL.
 - UNIT SHALL BE PROVIDED WITH LOW AMBIENT CONTROLS.
 - EXISTING UNIT TO REMAIN. UNIT SHALL BE FULLY RE-COMMISSIONED BY MANUFACTURER REPRESENTATIVE. DOCUMENTATION SHALL BE PROVIDED AT COMPLETION OF PROJECT.
 - EQUIPMENT IS PART OF ALTERNATE #1.

VRF HEAT RECOVERY BRANCH CIRCUIT CONTROLLER

SYSTEM TAG	TAG REFERENCE	MODEL NUMBER	TYPE (DOUBLE / MAIN / SUB)	NUMBER OF PORTS	CONNECTED CAPACITY TO BC	VOLTAGE / PHASE	POWER COOLING 208V (KW)	POWER HEATING 208V (KW)	MCA	NOTES
CU-DOAS-5	BCC-1-1	CMB-P108NU-G	SINGLE	6	112,000	208/230V/1	0.086	0.04	0.52/0.47	1,2
CU-6	BCC-1-2	CMB-P1018NU-J1	SINGLE	16	126,000	208/230V/1	0.243/0.314	0.122/0.157	1.47/1.72	1,2
HRCU-1 (EX)	BC-1	CMB-P1018NU-G1	SINGLE	16	113,600	208/230V/1	0.217	0.106	1.30/1.18	1
HRCU-2 (EX)	BC-2	CMB-P1018NU-G1	SINGLE	16	105,100	208/230V/1	0.217	0.106	1.30/1.18	1

- NOTES:**
- INCLUDE DIAMOND BACK BALL VALVES BY-SERIES, 700PSIG WORKING PRESSURE, FULL PORT, 410A RATED.
 - EQUIPMENT IS PART OF ALTERNATE #1.

HVAC LEGEND

SYMBOL	DESCRIPTION	SYMBOL	DESCRIPTION
A.F.F.	ABOVE FINISHED FLOOR	⊕	THERMOSTAT
A.F.G.	ABOVE FINISHED GRADE	EF	EXHAUST FAN
FCU	FAN COIL UNIT	VD	MANUAL VOLUME DAMPER (REC.)
DOAS	DEDICATED OUTSIDE AIR SYSTEM	⊘	MANUAL VOLUME DAMPER (RND.)
— C —	INSULATED CONDENSATE DRAIN LINE	M	MOTORIZED VOLUME DAMPER
FD	FIRE DAMPER	A85	TYPE "A" DIFFUSER @ 85 CFM
AP	ACCESS PANEL	BMS	BUILDING MANAGEMENT SYSTEM
FSD	FIRE / SMOKE DAMPER	VFD	VARIABLE FREQUENCY DRIVE

AIR BALANCE SCHEDULE CFM (1ST FLOOR)


ITEM	O.A.	E.A.	PRESSURE
DOAS-5	1,200		+1,200
EF-1-1		70	-70
EF-1-2		70	-70
EF-1-3		70	-70
EF-1-4		70	-70
EF-1-5		70	-70
TOTALS	+1,200	-350	+850

AIR BALANCE SCHEDULE CFM (2ND FLOOR)


ITEM	O.A.	E.A.	PRESSURE
DOAS-1	2,700		+2,700
DOAS-2	2,700		+2,700
EX. ROOF EF		1950	-1950
EF-2A/2B		2700	-2700
TOTALS	+5,400	-4,650	+750

ASHE I BROUSSARD I WEINZITTE ARCHITECTS

This drawing and design are the property of Ashe Broussard Weinzittle Architects. They are submitted on the condition that they are not to be used, reproduced, or copied in whole or in part, or used for furnishing information to others, without the prior written consent of Ashe Broussard Weinzittle Architects. All common law rights of copyright and otherwise are hereby specifically

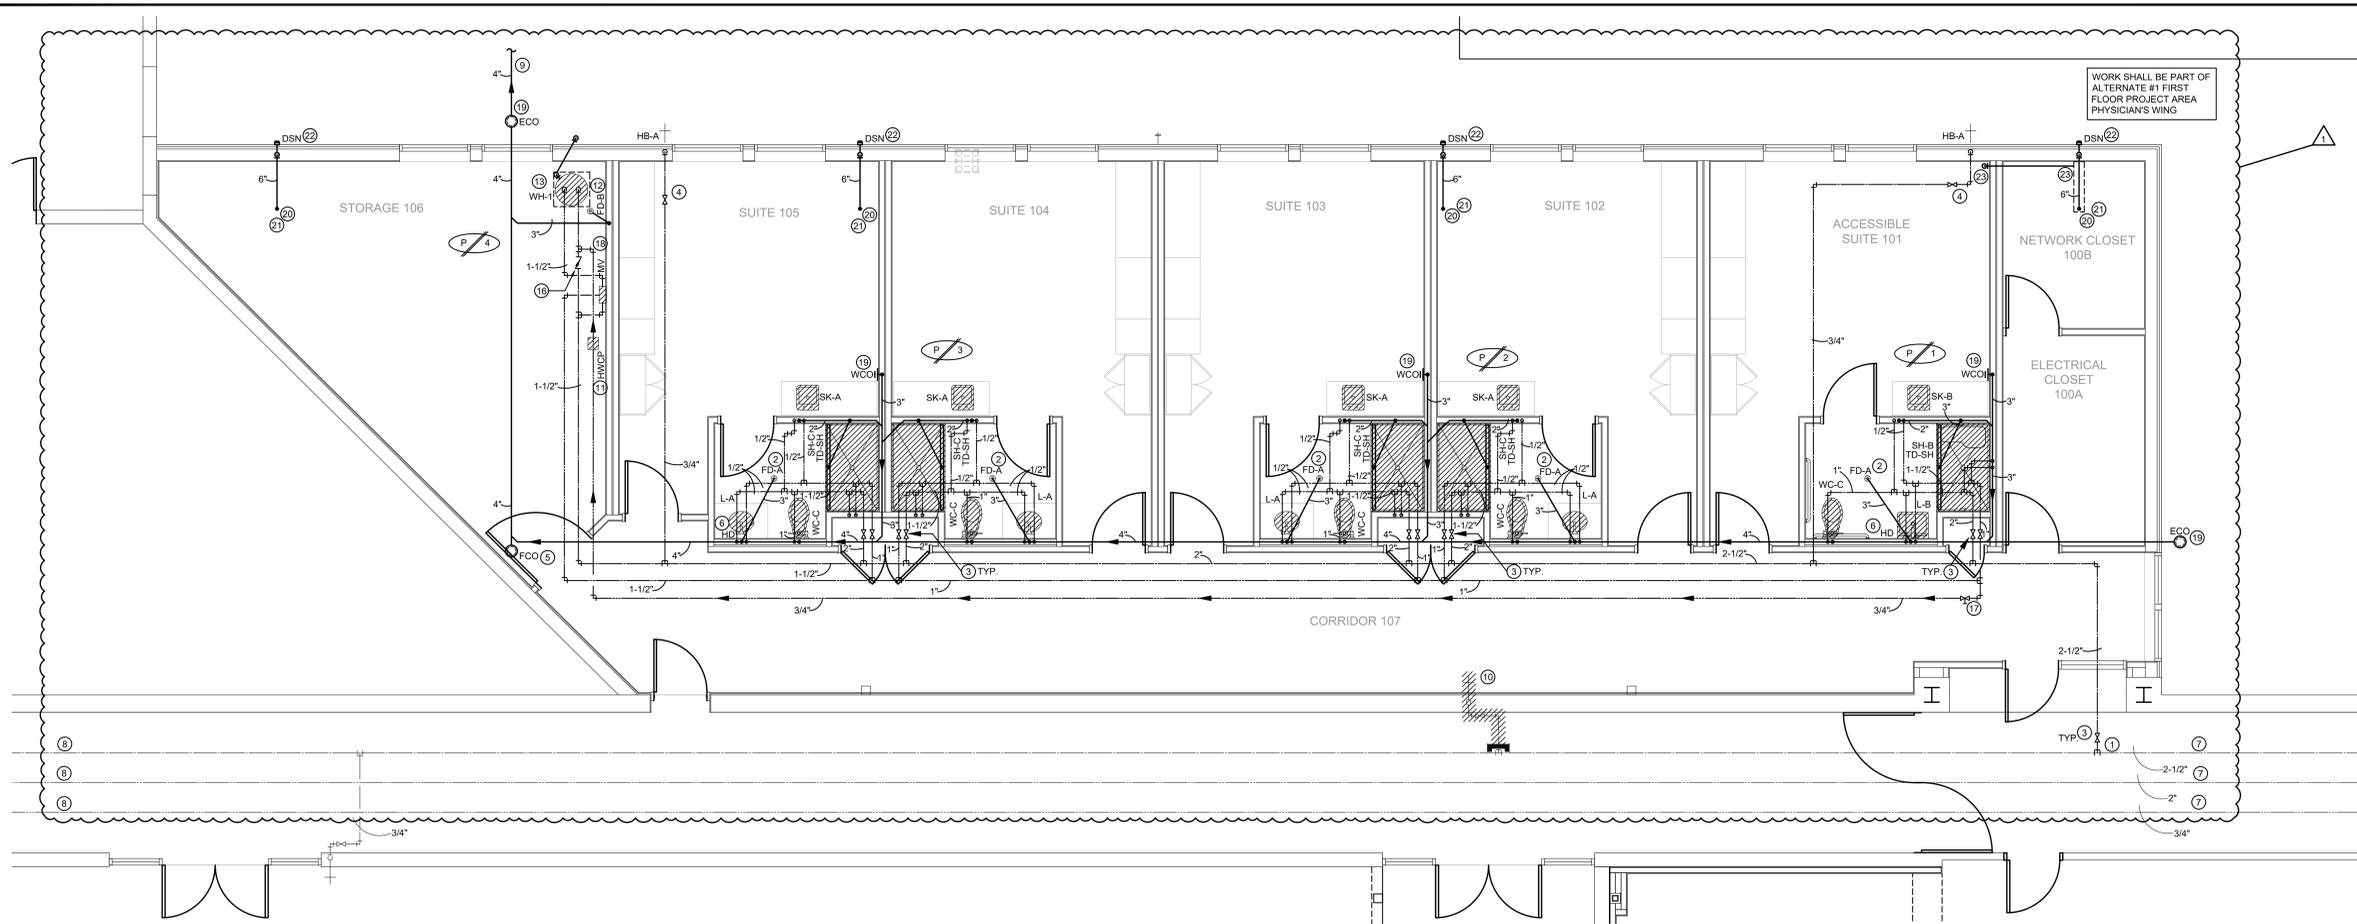

1 PLUMBING PLAN - PHYSICIAN'S WING
SCALE: 1/4" = 1'-0"

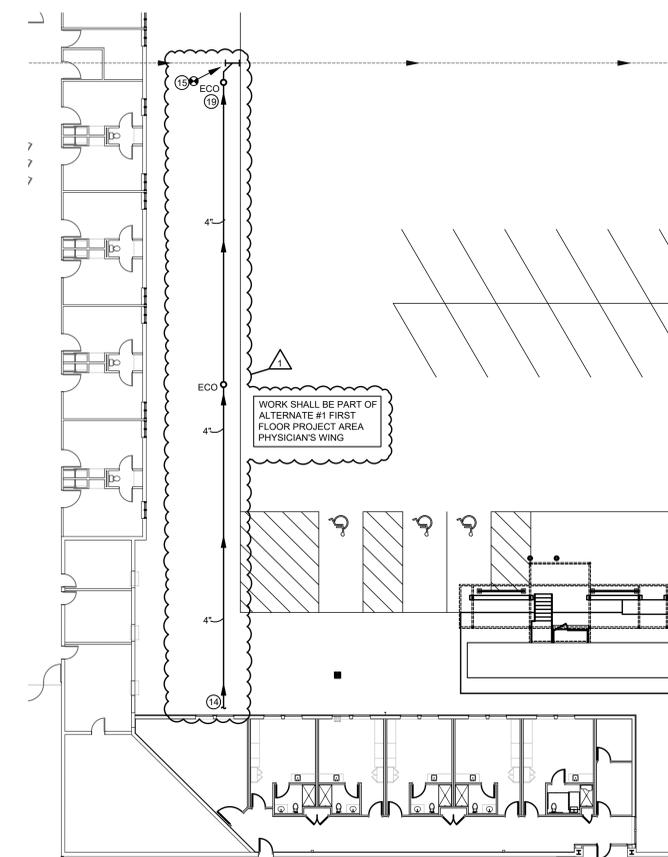

2 PLUMBING PLAN - SITE PLAN
SCALE: 1/16" = 1'-0"

GENERAL PLUMBING NOTES:

- A. ALL WORK SHALL BE IN ACCORDANCE WITH APPLICABLE LOCAL, STATE, AND FEDERAL CODES (INCLUDING INTERNATIONAL PLUMBING CODE, INTERNATIONAL FUEL GAS CODE, NFPA, ETC.) AND APPLICABLE DEQ AND DHHP REGULATIONS TO THE SATISFACTION OF THE AUTHORITIES HAVING JURISDICTION. CONTRACTOR SHALL OBTAIN REQUIRED PERMITS AND APPROPRIATE WORK AUTHORIZATION PRIOR TO BEGINNING OF WORK.
- B. CONTRACTOR SHALL VERIFY EXACT LOCATION OF UTILITIES, INVERT ELEVATIONS, ETC. PRIOR TO BEGINNING ANY ROUGH-IN OF SUBSURFACE WORK. COORDINATE ALL UTILITY TIE-IN REQUIREMENTS WITH RESPECTIVE UTILITIES.
- C. REFER TO ARCHITECTURAL DRAWINGS FOR ALL DIMENSIONS, DETAILS, ETC. INSTALL WORK TO CONFORM TO ARCHITECTURAL AND STRUCTURAL DRAWINGS AS REQUIRED. REVIEW COMPLETE SET OF CONTRACT DOCUMENTS PRIOR TO SUBMITTING BID.
- D. COORDINATE ALL UTILITY SERVICE DISRUPTIONS TO OTHER UTILITY CUSTOMERS WITH RESPECTIVE UTILITY. ALL UTILITY RELOCATION (SUCH AS WATER) SHALL BE DONE IN STRICT COMPLIANCE WITH UTILITY COMPANY STANDARDS AND REQUIREMENTS. CONTACT UTILITY COMPANY AND VERIFY AND DOCUMENT REQUIREMENTS, COST, CHARGES, ETC. CONTRACTOR SHALL FULLY COMPLY WITH ALL UTILITY COMPANY REQUIREMENTS.
- E. COORDINATE ALL WORK THROUGH GENERAL CONTRACTOR. COORDINATE CUTTING, PATCHING, TRENCHING WORK WITH SITE GRADING/PAVING PLAN.
- F. UNDERGROUND UTILITIES ARE APPROXIMATE. VERIFY INVERTS AND EXACT LOCATIONS WITH UTILITY PERSONNEL. VERIFY ALL EASEMENTS WITH APPROPRIATE PARTIES. ADJUST ALL UTILITY LINES ACCORDINGLY.
- G. COORDINATE INSTALLATION OF ALL PLUMBING, PIPING, ETC. WITH STRUCTURE. ALL DOMESTIC WATER BRANCH LINES SHALL HAVE VALVES AT MAINLINES.

PLUMBING KEYNOTES:

1. CONNECT TO EXISTING WATER SERVICE IN THIS VICINITY. VERIFY EXACT TIE-IN LOCATION PRIOR TO ANY ROUGH-INS.
2. TAP OFF LAVATORY P-TRAP WITH 1/2" CHROME LINE TO WALL AND CONTINUE IN WALL WITH 1/2" SOFT COPPER LINE TO BELOW GRADE TO TRAP PRIMER CONNECTION FLOOR DRAIN. ALL EXPOSED SUPPLY LINES SHALL BE CHROME (J.R. SMITH 2698 OR EQUAL P-TRAP TYPE).
3. PROVIDE BALL TYPE CUTOFF VALVE ABOVE CEILING IN ACCESSIBLE LOCATION FOR ISOLATION. (TYPICAL)
4. 3/4" DOMESTIC COLD WATER LINE TO NEW HOSE BIBB. PROVIDE A BALL TYPE SHUT-OFF VALVE ABOVE ACCESSIBLE CEILING (TYPICAL).
5. INSTALL NEW FLOOR CLEANOUT WHERE SHOWN.
6. PROVIDE 2" INSULATED HUB DRAIN ABOVE CEILING WITH ACCESS PANEL. COORDINATE WITH MECHANICAL CONTRACTOR PRIOR TO ROUGH-IN.
7. DOMESTIC WATER FROM EXISTING HOSPITAL.
8. DOMESTIC WATER CONTINUES TO EXISTING NURSING HOME.
9. REFER TO SITE PLAN ON THIS SHEET FOR CONTINUATION.
10. REMOVE HOSE BIBB WHERE SHOWN. CAP COLD WATER NEAR ACTIVE MAIN.
11. INSTALL HOT WATER RECIRCULATION PUMP WHERE SHOWN.
12. PROVIDE PROSET TRAP GUARD IN FLOOR DRAIN.
13. WATER HEATER SHALL BE INSTALLED 3'-0" A.F.F. ON STAND IN DRAIN PAN ON FLOOR. PIPE T&P RELIEF LINE AND EMERGENCY DRAIN PAN LINE FULL SIZE FROM WATER HEATER TO EXTERIOR. SEAL PENETRATIONS WEATHER TIGHT. TERMINATE RELIEF AND EMERGENCY DRAIN LINE TO EXTERIOR 6" A.F.G. WITH 90° ELBOW.
14. REFER TO PHYSICIAN'S WING ON THIS SHEET FOR CONTINUATION.
15. CONNECT TO EXISTING SEWER EXITING NURSING HOME APPROXIMATELY WHERE SHOWN. VERIFY SIZE, LOCATION, AND INVERT OF EXISTING SANITARY SEWER PRIOR TO ANY AND ALL ROUGH-INS.
16. INSTALL CHECK VALVE WHERE SHOWN.
17. INSTALL CALIBRATED BALANCING VALVE WHERE SHOWN.
18. INSTALL THERMOSTATIC MIXING VALVE WHERE SHOWN. ROUTE DOMESTIC COLD WATER LINE AND 140°F DOMESTIC HOT WATER LINE FROM WATER HEATER TO INLET PORTS OF MIXING VALVE. ROUTE 120°F DOMESTIC HOT WATER LINE FROM OUTLET PORT TO FIXTURES SHOWN.
19. INSTALL NEW EXTERNAL CLEANOUT WHERE SHOWN.
20. PRIMARY ROOF DRAIN (RD) INSTALLED ON ROOF IN THIS VICINITY. COORDINATE WITH ARCHITECTURAL DRAWINGS AND ROOFING CONTRACTOR PRIOR TO ROUGH-IN.
21. 6" INSULATED STORM DRAIN LEADER DOWN FROM ROOF DRAIN.
22. 6" INSULATED STORM DRAIN LINE TO DOWN SPOUT (DSN) APPROXIMATELY 0'-6" A.F.F.
23. INSTALL DRAIN PAN BENEATH STORM DRAIN LINE WHERE SHOWN. ROUTE DRAIN PIPE FROM PAN TO WHERE SHOWN IN ACCESSIBLE SUITE 101. ELBOW DRAIN PIPE DOWNWARD ABOVE CEILING.

WORK SHALL BE PART OF ALTERNATE #1 FIRST FLOOR PROJECT AREA PHYSICIAN'S WING

WORK SHALL BE PART OF ALTERNATE #1 FIRST FLOOR PROJECT AREA PHYSICIAN'S WING

ASHE | BROUSSARD | WEINZITTE
ARCHITECTS

This drawing and design are the property of Ashe Broussard Weinzittle Architects. They are submitted on the condition that they are not to be used, reproduced, or copied in whole or in part, or used for furnishing information to others, without the prior written consent of Ashe Broussard Weinzittle Architects. All common law rights of copyright and otherwise are hereby specifically reserved.

R. CAMPBELL, II
LICENSED PROFESSIONAL ENGINEER
10/15/05

REVISIONS		
revision	description	date
1	Addendum No. One	10.15.25

LASALLE GENERAL HOSPITAL
Workforce Capacity and Medical Access Project
EDA No. 08-79-05595
187 Ninth St. Jena, Louisiana 71342
Email: adginc@adginc.org

project no. 2024.01
drawn: EM
checked: CC
project date: JAN 2025
sheet contents: PLUMBING PLAN - PHYSICIAN'S WING
drawing no. P2.0R1




ASSOCIATED DESIGN GROUP, INC.
3909 W Congress Street, Suite 201
Lafayette, Louisiana 70506
Phone: (337) 234-5710
Email: adginc@adginc.org

Project No. 24277

MARK DESCRIPTION	MANUFACTURER	SERVICES					DESCRIPTION
		TRAP	WASTE	VENT	HW	CW	
WC-A WATER CLOSET BEDPAN WASHER FLUSH VALVE FLOOR MOUNT PATIENT ROOM ADA	KOHLER - K-96057-SSL SLOAN - REGAL BPW-1150 CHURCH - 295C	INT.	4"	3"	--	1"	WHITE, VITREOUS CHINA, SIPHON JET ACTION FLOOR MOUNT WATER CLOSET WITH ELONGATED BOWL, BED PAN LUGS AND 1-1/2" TOP SPUD, EXPOSED CHROME PLATED, DIAPHRAGM TYPE BED PAN FLUSH VALVE WITH VACUUM BREAKER, ADJUSTABLE TAIL PIECE, ANGLE STOP AND OFFSET. PROVIDE WHITE, OPEN FRONT SEATLESS COVER, WITH STAINLESS STEEL CHECK HINGES. INSTALL FLUSH VALVE HANDLE ON WIDE SIDE OF STALL.
WC-B WATER CLOSET FLUSH VALVE FLOOR MOUNT PUBLIC ADA	KOHLER - K-96053 SLOAN - REGAL 1111-16 CHURCH - 295C	INT.	4"	3"	--	1"	WHITE, VITREOUS CHINA, SIPHON JET ACTION FLOOR MOUNT WATER CLOSET WITH ELONGATED BOWL AND 1-1/2" TOP SPUD, EXPOSED CHROME PLATED, DIAPHRAGM TYPE FLUSH VALVE WITH VACUUM BREAKER, ADJUSTABLE TAIL PIECE, ANGLE STOP. PROVIDE WHITE, OPEN FRONT SEATLESS COVER, WITH STAINLESS STEEL CHECK HINGES. INSTALL FLUSH VALVE HANDLE ON WIDE SIDE OF STALL.
WC-C WATER CLOSET TANK TYPE FLOOR MOUNT SUITES ADA	KOHLER - K-3493 CHURCH - 500CCSS	INT.	4"	3"	--	1"	WHITE, VITREOUS CHINA, ELONGATED BOWL, PRESSURE-LITE 1/4 GAL. FLUSH 17" HIGH FLOOR MOUNT WATER CLOSER WITH ELONGATED BOWL, TANK, LEVER HANDLE, AND BOLT CAPS, WHITE OPEN FRONT SEATLESS COVER WITH S.S. CHECK HINGE. INSTALL AS PER ADA REQUIREMENTS. INSTALL FLUSH HANDLE ON WIDE SIDE OF STALL. PART OF ALTERNATE 1
L-A UNDERMOUNT CHINA PATIENT ROOM R/R ADA	KOHLER - K-2209 T&S - B-2866-05FC-CR KOHLER - K-7715 WATTS - LFSUG-B-M2 WATTS - TCA-411 TRUEBRO - 102	1-1/4"	2"	2"	1/2"	1/2"	17" OVAL, WHITE VITREOUS CHINA, UNDERMOUNT BATHROOM SINK, DECK MOUNTED FAUCET WITH QUARTER-TURN CERAMIC DISC VALVES, 4" WRIST BLADE HANDLES, GRID DRAIN W/ PERFORATED STRAINER & TAILPIECE, 1-1/4" 17 GA. P-TRAP WITH CLEANOUT AND 3/8" ANGLE SUPPLIES WITH STOPS. PROVIDE ASSE 1070 THERMOSTATIC MIXING VALVE UNDER LAVATORY. INSULATE P-TRAP, HOT AND COLD WATER SUPPLIES WITH TRUEBRO 102 LAVGUARD.
L-B SINK WALL MOUNT PATIENT ROOMS ADA	KOHLER - K-2030 T&S - B-2866-05FC-CR KOHLER - K-7715 WATTS - LFSUG-B-M2 WATTS - TCA-411 TRUEBRO - 102	1-1/4"	2"	2"	1/2"	1/2"	20-3/4"x18-1/4" WHITE VITREOUS CHINA WALL HUNG LAVATORY WITH 8" CENTERS, WIDESPREAD GOOSENECK FAUCET WITH QUARTER-TURN CERAMIC DISC VALVES, 4" WRIST BLADE HANDLES, GRID DRAIN WITH PERFORATED STRAINER AND TAILPIECE, 1-1/4" 17 GA. P-TRAP WITH CLEANOUT AND 3/8" ANGLE SUPPLIES WITH STOPS. PROVIDE ASSE 1070 THERMOSTATIC MIXING VALVE UNDER LAVATORY. PROVIDE CONCEALED ARM FLOOR MOUNTED CARRIER WITH ANCHORS. INSULATE P-TRAP, HOT AND COLD WATER SUPPLIES, MOUNT AT ADA HEIGHT.
SK-A SINK SINGLE COMPARTMENT	ELKAY - LR1919 T&S - B-2866-05FC-CR WATTS - LFSUG-B-M2 TRUEBRO - 102	1-1/2"	2"	2"	1/2"	1/2"	18 GA. TYPE 302 SS SINGLE COMPARTMENT SINK 19-1/2"x19"x7-1/2" DEEP, WIDESPREAD GOOSENECK FAUCET WITH QUARTER-TURN CERAMIC DISC VALVES, 4" WRIST BLADE HANDLES, LK-99 DRAIN WITH STRAINER, WITH CAST BRASS CONTINUOUS WASTE AND P-TRAP. ANGLE SUPPLIES WITH STOPS. PROVIDE ASSE 1070 THERMOSTATIC MIXING VALVE UNDER SINK.
SH-A SHOWER	SHOWER BY ARCHITECT LEONARD - 76-1A	3"	3"	2"	3/4"	3/4"	SINGLE HANDLE THERMOSTATIC AND PRESSURE BALANCING MIXING SHOWER VALVE, VACUUM BREAKER, WALL BRASS SHOWER HEAD (1.5 GPM). INSTALL FD-A.
SH-B SHOWER ADA	TILED SHOWER BY ARCHITECT LEONARD - 76-2A	3"	3"	2"	3/4"	3/4"	SINGLE HANDLE THERMOSTATIC AND PRESSURE BALANCING MIXING SHOWER VALVE, VACUUM BREAKER, HAND/WALL BRASS SHOWER HEAD (1.5 GPM), DIVERter VALVE, 60" HOSE, 24" GLIDE BAR. INSTALL AS PER ADA REQUIREMENTS.
SH-C SHOWER	TILED SHOWER BY ARCHITECT LEONARD - 76-1A	3"	3"	2"	3/4"	3/4"	SINGLE HANDLE THERMOSTATIC AND PRESSURE BALANCING MIXING SHOWER VALVE, VACUUM BREAKER, WALL BRASS SHOWER HEAD (1.5 GPM). PART OF ALTERNATE 1
TD-SH TROUGH DRAIN	QUICKDRAIN USA - PLD57-N	--	--	--	--	--	18 GAUGE 316L STAINLESS STEEL, 5" TROUGH DRAIN WITH "LINES" DRAIN COVER. PROVIDE ALL ACCESSORIES FOR COMPLETE INSTALLATION.
HB-A HOSE BIBB	WOODFORD - B85	--	--	--	--	3/4"	3/4" FREEZELESS WALL HYDRANT IN FLUSH MOUNTED LOCKING RECESS WALL BOX WITH INTEGRAL DRAIN, VACUUM BREAKER AND TEE KEY IN POLISHED BRASS FINISH. VERIFY WALL THICKNESS.
FD-A FLOOR DRAIN	ZURN - Z415 B	3"	3"	2"	--	--	CAST IRON FLOOR DRAIN W/ FLANGE, INTEGRAL CLAMPING COLLAR, SEEPAGE OPENING, ADJUSTABLE 6" DIA., NICKEL BRONZE STRAINER W/ SQUARE PERFORATIONS, TRAP PRIMER CONNECTION, P-TRAP.
FD-B FLOOR DRAIN	ZURN - ZN415-I	3"	3"	2"	--	--	CAST IRON FLOOR DRAIN W/ FLANGE, INTEGRAL CLAMPING COLLAR, SEEPAGE OPENING, ADJUSTABLE 7" DIA., NICKEL BRONZE EXTENDED RIM STRAINER WITH SQUARE PERFORATIONS, P-TRAP.
FCO FLOOR CLEANOUT	ZURN - Z1400	--	LINE SIZE	--	--	--	CAST IRON FLOOR CLEANOUT WITH ROUND ADJUSTABLE SCORATED NICKEL BRONZE TOP. COORDINATE TOP STYLE WITH FINISHED FLOOR MATERIAL (CARPET, TILE, ETC.)
ECO EXTERIOR CLEANOUT	JONES STEPHENS - S36-008	--	LINE SIZE	--	--	--	CAST IRON FRAME AND COVER MARKED "SEWER CLEANOUT". PROVIDE AS DETAILED IN CONCRETE SLAB.
RD ROOF DRAIN	ZURN - ZC100F-EA-C	--	LINE SIZE	--	--	--	CAST IRON ROOF DRAIN WITH FLANGE, FLASHING RING WITH GRAVEL STOP, CAST IRON DOME, BEARING PAN, DECK CLAMP AND ADJUSTABLE EXTENSION.

SYMBOL	DESCRIPTION	SYMBOL	DESCRIPTION
	SANITARY SEWER LINE	WC	WATER CLOSET
	STORM DRAIN LINE	SK	SINK
	DOMESTIC COLD WATER LINE	L	LAVATORY
	DOMESTIC HOT WATER LINE	SH	SHOWER
	DOMESTIC HOT WATER RETURN LINE	IMB	ICE MAKER BOX
	ABOVE FINISHED FLOOR	TD	TRENCH DRAIN
	FLOOR CLEANOUT	RD	ROOF DRAIN
	EXTERIOR CLEANOUT	V.T.R.	VENT THRU ROOF
	FLOOR DRAIN		BALL VALVE
	HOSE BIBB		WATER HAMMER ARRESTOR

PLUMBING RISER SYMBOL

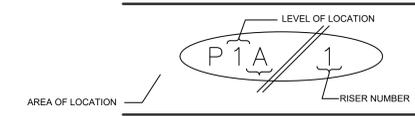

ELECTRIC WATER HEATER SCHEDULE


UNIT NO	LOCATION	STORAGE GAL	HEATING ELEMENTS (KW)	ELECTRIC SERVICE	REMARKS
WH-1	STORAGE	50	15.0	480-3-60	AO SMITH MODEL DRE52-12 OR APPROVED EQUIVALENT

PART OF ALTERNATE 1
 * ALL TRAP PRIMER LINES BELOW SINKS SHALL BE INSULATED.
 ** CONTRACTOR SHALL PROVIDE ALL ACCESSORIES REQUIRED FOR A COMPLETE WORKING SYSTEM.


APPROVED EQUALS: THE FOLLOWING MANUFACTURERS OF PLUMBING FIXTURES AND DRAINS OF COMPARABLE QUALITY TO THOSE ITEMS SPECIFIED ARE CONSIDERED APPROVED EQUALS SUBJECT TO COMPLIANCE WITH REQUIREMENTS OF THE INDIVIDUAL SPECIFICATIONS.

- PLUMBING FIXTURES:
 DRAINS, CLEANOUTS, CARRIERS: AMERICAN STANDARD, MANSFIELD, SLOAN, TOTO, ZURN
 JOSEPH, J.R. SMITH, MIFAB, WATTS, ZURN
 ADVANCE TABCO, GRIFFIN, JUST
 SINKS: ACORN, FLORSTONE, MUSTEE, STERN WILLIAMS, ZURN
 SERVICE SINKS: J.R. SMITH, MIFAB, PRIER, WATTS, ZURN
 DELANY, ZURN
 FLUSH VALVES: ACORN, BRADLEY, CASH ACME, LAWLER, POWERS, WATTS
 CHICAGO, MOEN COMMERCIAL, SLOAN, SPEAKMAN, T & S, ZURN
 TEMPERING VALVE: BEECO, WATTS, WILKINS
 FAUCETS: ACORN, HAWS, HALSEY TAYLOR, OASIS
 BEMIS, BENEKE, CENTOCO, ZURN
 ELECTRIC WATER COOLERS: AQUARIUS, AQUA BATH
 TOILETS SEATS: BEMIS, BENEKE, CENTOCO, ZURN
 SHOWERS: AQUARIUS, AQUA BATH
 SUPPLIES: BRASSCRAFT, EASTMAN, McGUIRE, SPECIFIED TRIM, ZURN
 BACKFLOW PREVENTER: BEECO, WATTS, WILKINS
 OTHER MANUFACTURERS: SUBMIT FOR PRIOR APPROVAL.


* MANUFACTURERS REQUESTING PRIOR APPROVAL FOR ALTERNATE SINKS/FAUCETS SHALL SUBMIT PRODUCT DATA WITH DIMENSIONS FOR ARCHITECT/ENGINEER REVIEW.

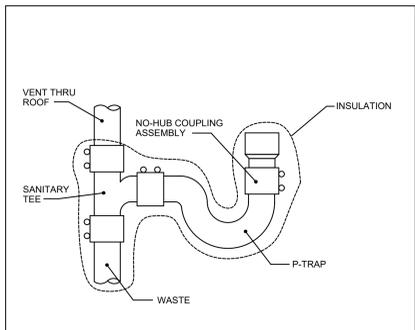


1 HUB DRAIN "HD" DETAIL
NO SCALE

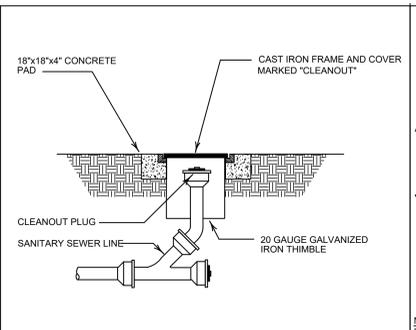


2 EXTERIOR CLEANOUT "ECO" DETAIL
NO SCALE

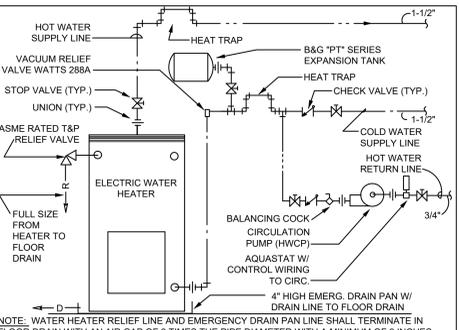


3 ELECTRIC WATER HEATER PIPING DIAGRAM
NO SCALE

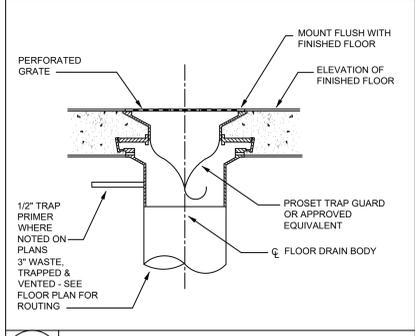


4 FLOOR DRAIN "FD-A" DETAIL
NO SCALE

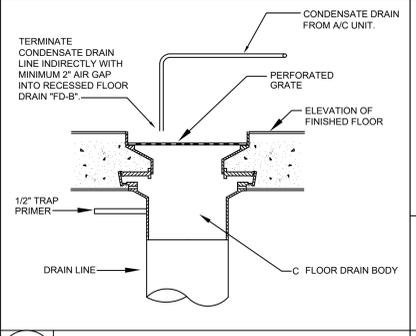


5 FLOOR DRAIN "FD-B" DETAIL
NO SCALE

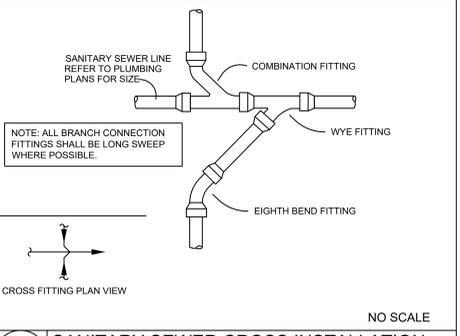


6 SANITARY SEWER CROSS INSTALLATION METHOD CONNECTION DETAIL (TYPICAL)
NO SCALE

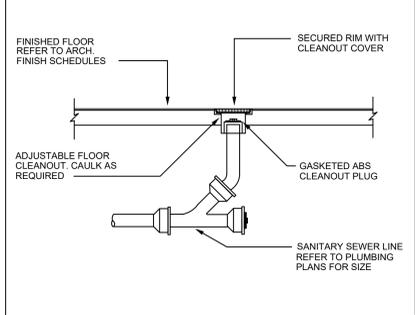


7 FLOOR CLEANOUT "FCO" DETAIL
NO SCALE

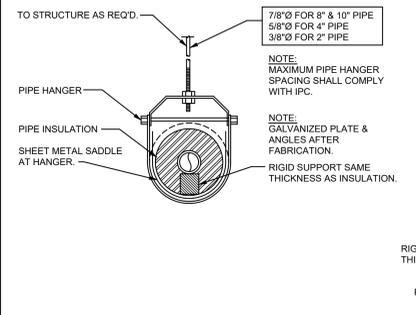


8 INSULATED PIPE HANGER DETAIL
NO SCALE

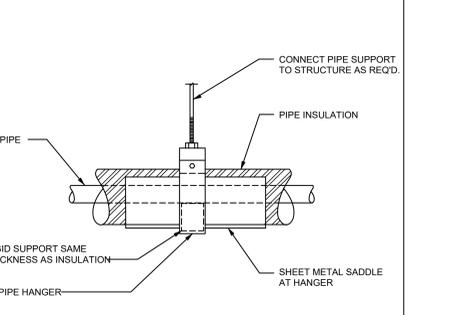


9 WALL CLEANOUT "WCO" DETAIL
NO SCALE

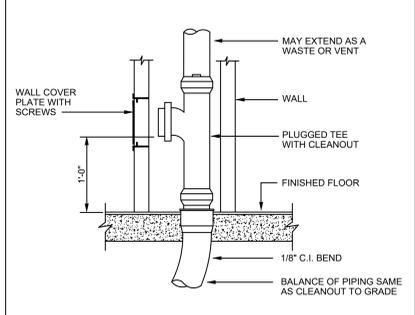

10 TRAP PRIMER ASSEMBLY
NO SCALE

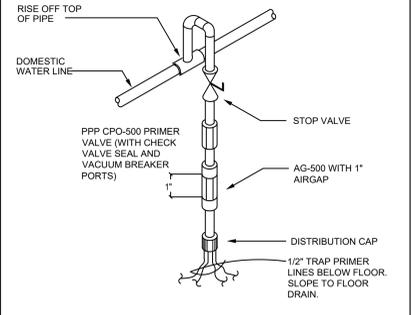

11 TRAP PRIMER DETAIL
NO SCALE

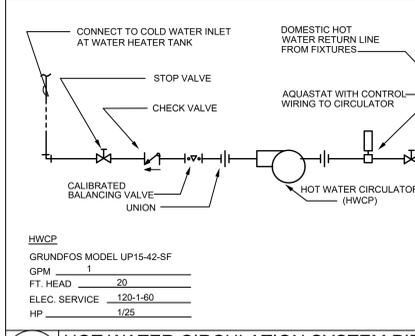

12 HOT WATER CIRCULATION SYSTEM PIPING DIAGRAM (HWCP)
NO SCALE

HWCP	GRUNDFOS MODEL UP15-42-SF
GPM	1
FT. HEAD	20
ELEC. SERVICE	120-1-60
HP	1/25

ASHE I BROUSSARD I WEINZITTEL ARCHITECTS

This drawing and design are the property of Ashe Broussard Weinzittel Architects. They are submitted on the condition that they are not to be used, reproduced, or copied in whole or in part, or used for furnishing information to others, without the prior written consent of Ashe Broussard Weinzittel Architects. All common law rights of copyright and otherwise are hereby specifically reserved.




REVISIONS		
revision	description	date
1	Addendum No. One	10.15.25

LASALLE GENERAL HOSPITAL		project no.
Workforce Capacity and Medical Access Project		2024.01
EDA No. 08-79-05595		drawn by EM
187 Ninth St. Jena, Louisiana 71342		checked by CC
Email: adginc@adginc.com		project date JAN 2025
Project No. 24277		sheet contents PLUMBING SCHEDULES / DETAILS
		drawing no. P3.0R1



ASSOCIATED DESIGN GROUP, INC.
 3909 W Congress Street, Suite 201
 Lafayette, Louisiana 70506
 Phone: (337) 234-5710
 Email: adginc@adginc.com

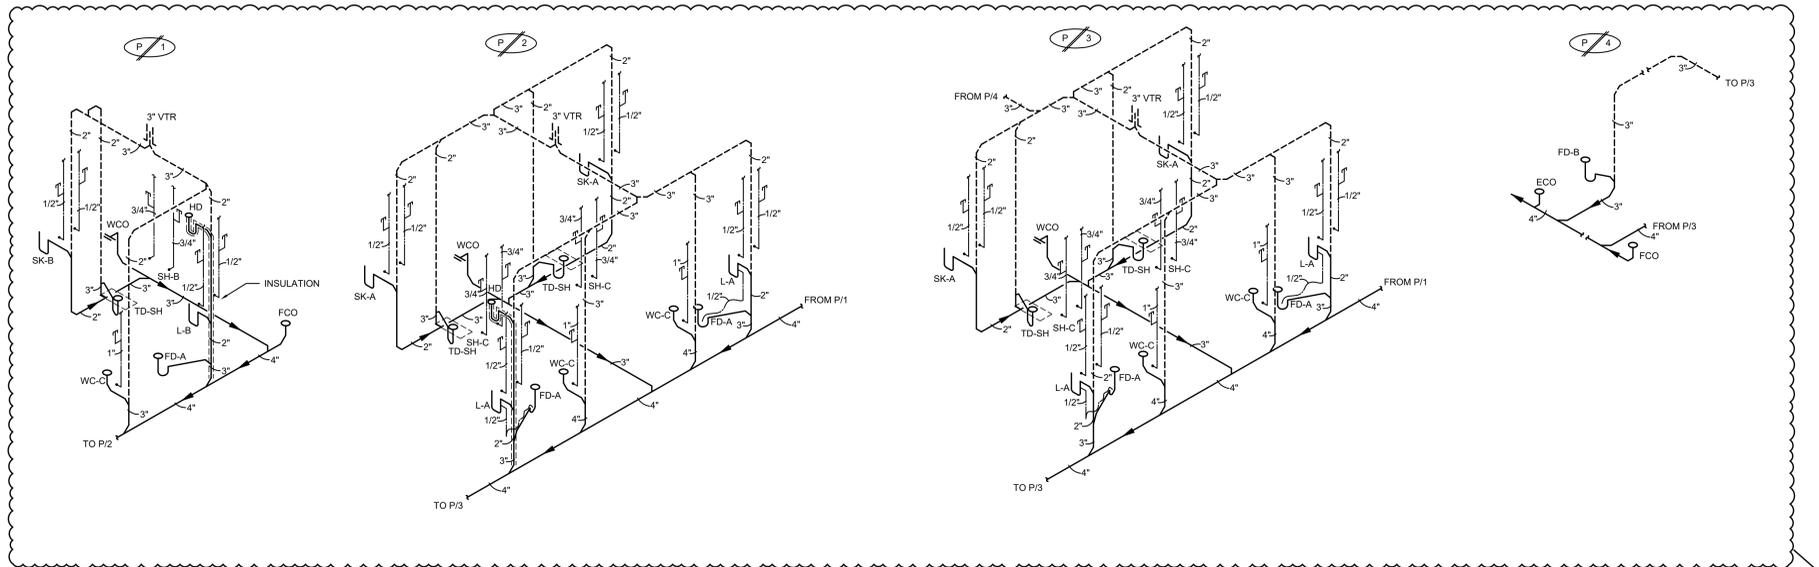

ALL RISERS SHALL BE A PART OF ALTERNATE #1 FIRST FLOOR PROJECT AREA PHYSICIAN'S WING.

1 PLUMBING RISERS
SCALE: N.T.S.

ASHE | BROUSSARD | WEINZITTEL
ARCHITECTS

This drawing and design are the property of Ashe Broussard Weinzittel Architects. They are submitted on the condition that they are not to be used, reproduced, or copied, in whole or in part, or used for furnishing information to others, without the prior written consent of Ashe Broussard Weinzittel Architects. All common law rights of copyright and otherwise are hereby specifically reserved.




REVISIONS		
revision	description	date
1	Addendum No. One	10.15.25

LASALLE GENERAL HOSPITAL Workforce Capacity and Medical Access Project EDA No. 08-79-05595 187 Ninth St. Jena, Louisiana 71342	project no. 2024.01
	drawn by EM
sheet contents PLUMBING RISERS	checked by CC
	project date JAN 2025
	drawing no. P3.1R1




ASSOCIATED DESIGN GROUP, INC.
3909 W Congress Street, Suite 201
Lafayette, Louisiana 70506
Phone: (337) 234-5710
Email: adginc@adginc.org
Project No. 24277

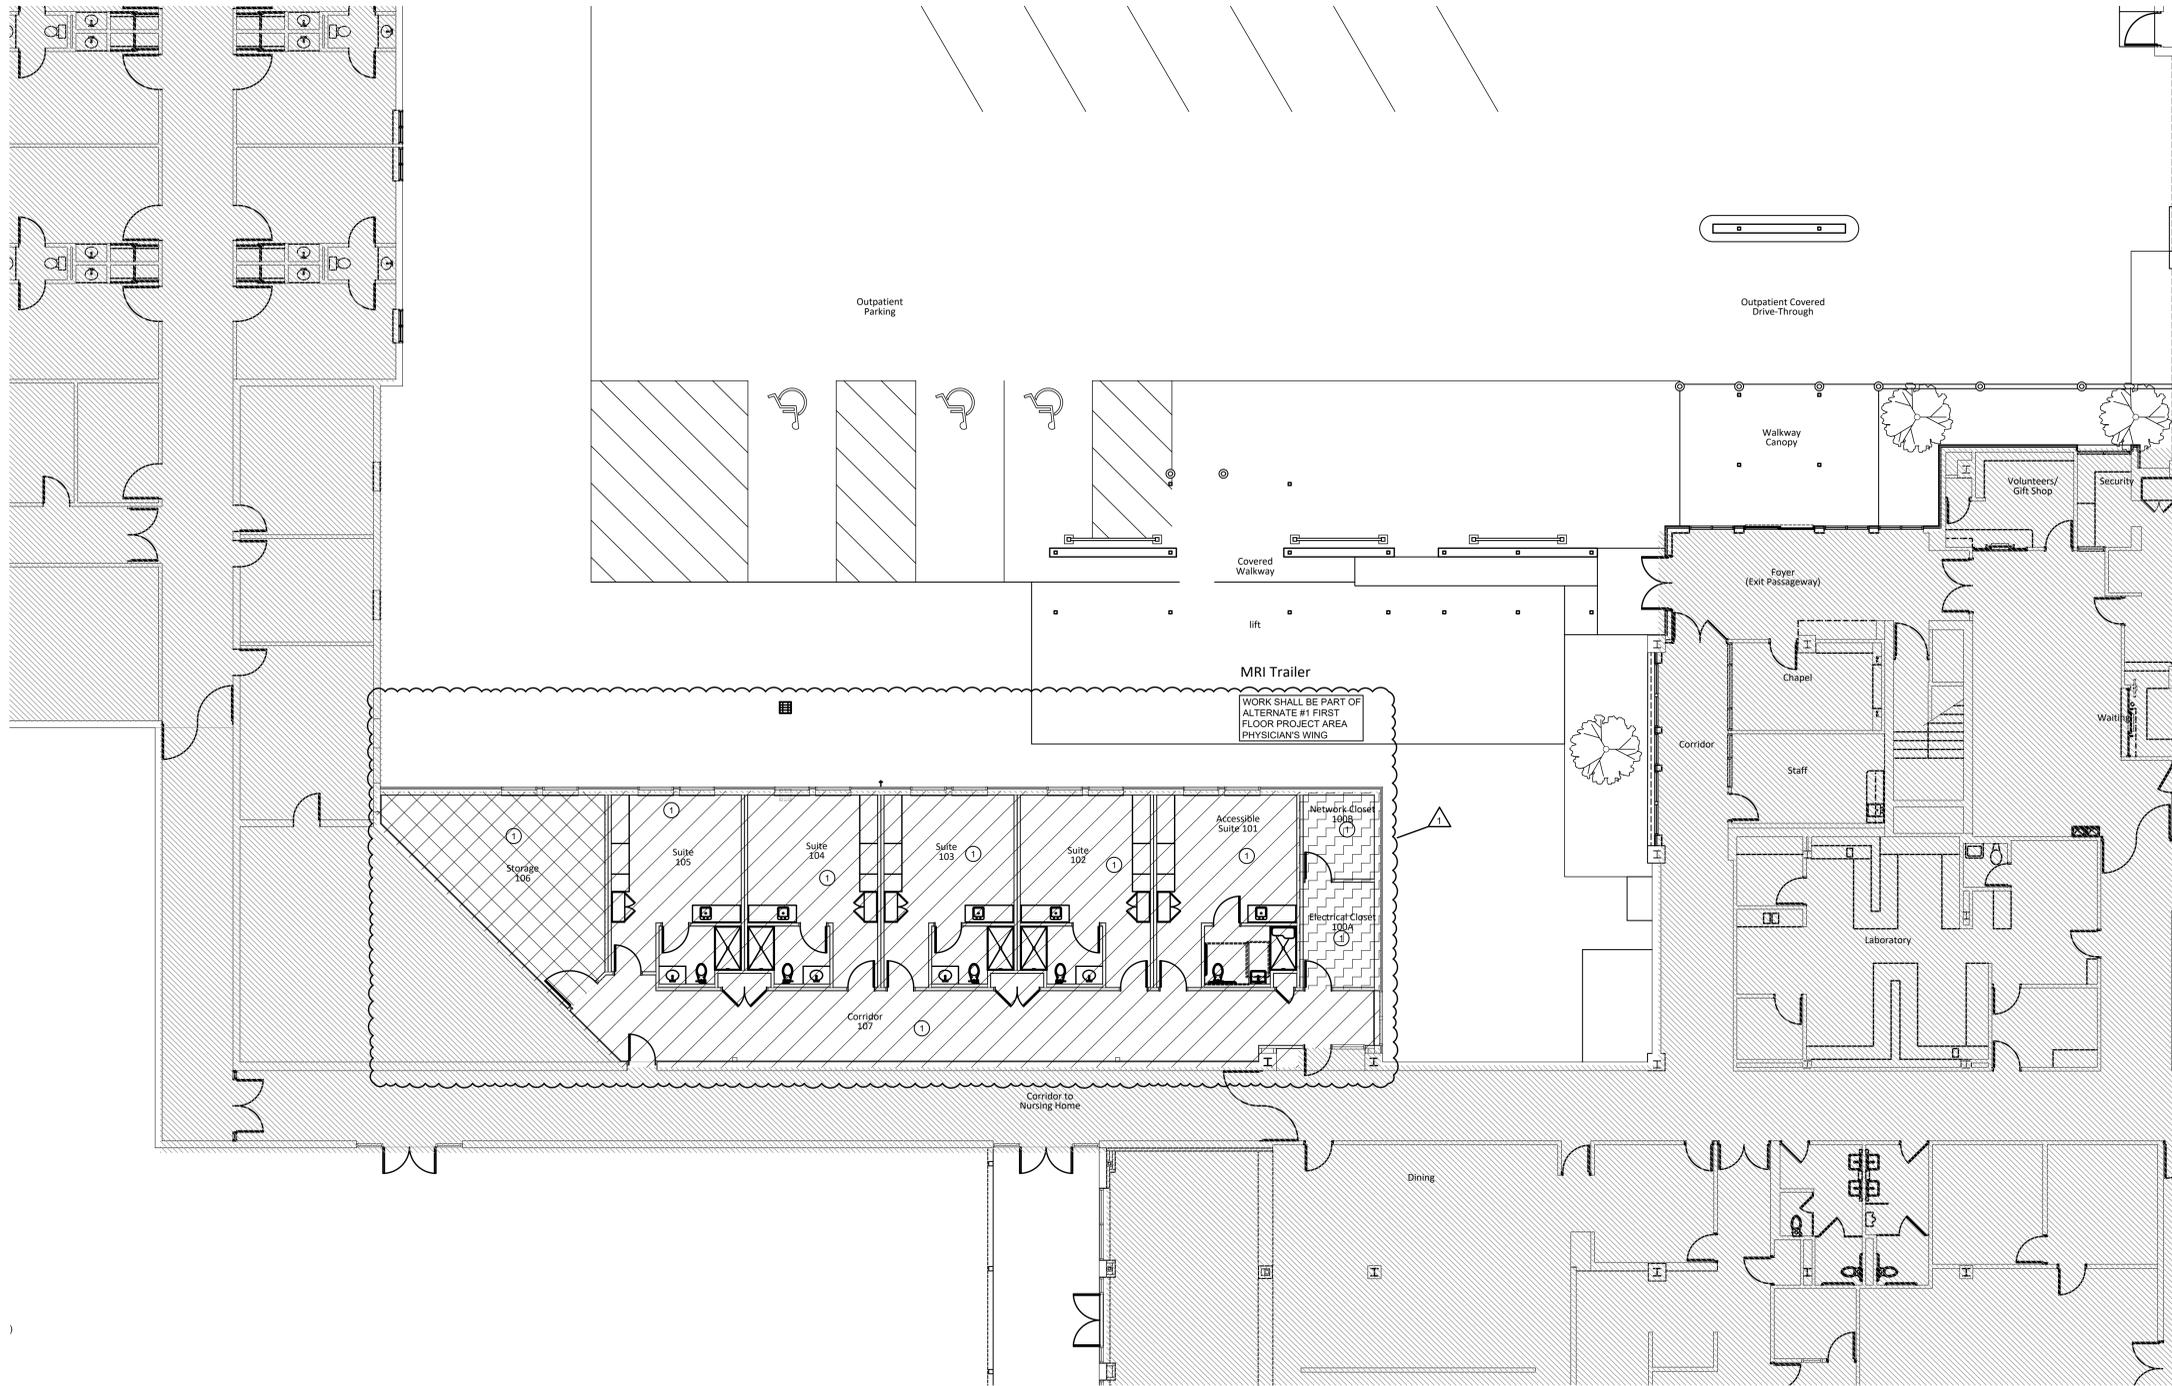

GENERAL FIRE PROTECTION NOTES:

- FP SHEETS INTENDED AS CONCEPTUAL DRAWINGS AND ARE FOR INFORMATION ONLY TO SHOW POTENTIAL SYSTEM ARRANGEMENTS. THE CONTRACTOR SHALL REVIEW THE ARCHITECTURAL DRAWINGS AND FIELD VERIFY ALL INFORMATION CONTAINED ON THESE DRAWINGS. THE CONTRACTOR SHALL BE SOLELY RESPONSIBLE FOR THE DESIGN AND INSTALLATION OF THE SYSTEM IN ACCORDANCE WITH ALL APPLICABLE CODES AND REQUIREMENTS, INCLUDING BUT NOT LIMITED TO NFPA AND ALL OTHER AUTHORITIES HAVING JURISDICTION.
- ALL ABOVE GROUND PIPE FOR PROJECT WETPIPE SYSTEM 1-1/2" AND LESS IN DIAMETER IS TO BE SCHEDULE 40 BLACK STEEL AND SHALL UTILIZE CUT THREADS AND CLASS 150 MALLEABLE IRON FITTINGS. ALL PIPE GREATER THAN 1-1/2" AND LESS THAN 6" IN DIAMETER SHALL BE SCHEDULE 40 BLACK STEEL AND SHALL UTILIZE ROLLED GROOVES AND LISTED GROOVED END FITTINGS WITH RUBBER GASKETS. LISTED WELDED FITTINGS MAY ALSO BE UTILIZED. PIPE 6" AND GREATER IN DIAMETER SHALL BE SCHEDULE 10 BLACK STEEL PIPE AND SHALL USE ROLLED GROOVES AND LISTED ROLLED GROOVE FITTINGS WITH RUBBER GASKETS.
- EXCEPT WHERE NOTED, SPRINKLER HEADS ARE TO BE LOCATED IN CENTER OF CEILING TILES.
- PROVIDE SPARE HEADS AND WRENCHES IN CABINET MOUNTED ADJACENT TO SPRINKLER ENTRY AS PER NFPA 13 2016 EDITION.
- RUN SPRINKLER PIPE AS HIGH AS POSSIBLE TO AVOID CONFLICTS WITH DUCTWORK. ACCESS TO MECHANICAL EQUIPMENT, ETC. PROVIDE COORDINATION DRAWINGS SHOWING ANY POTENTIAL CONFLICT WITH OTHER CONSTRUCTION INSTALLATIONS. SPRINKLER INSTALLATIONS THAT PREVENT THE INSTALLATION OF OTHER UTILITIES IN ACCORDANCE WITH THE CONTRACT DOCUMENTS SHALL BE RELOCATED AT THE SPRINKLER CONTRACTORS EXPENSE.
- ALL STORAGE SHALL BE MAINTAINED AT 18 INCHES OR GREATER BELOW CEILING.
- IN ACCORDANCE WITH NFPA 101.9.11.2 AND NFPA 25:15.5 WHERE THE AUTOMATIC SPRINKLER SYSTEM IS OUT OF SERVICE, THE CONTRACTOR SHALL NOTIFY THE BUILDINGS IMPAIRMENT COORDINATOR AND WHEN SYSTEM IS OUT OF SERVICE FOR MORE THAN TEN (10) HOURS IN A TWENTY-FOUR (24) HOUR PERIOD, THE AUTHORITY HAVING JURISDICTION SHALL BE NOTIFIED, AND THE BUILDING SHALL BE EVACUATED OR AN APPROVED FIRE WATCH SHALL BE PROVIDED UNTIL THE SPRINKLER SYSTEM HAS BEEN RETURNED TO SERVICE. CONTRACTOR SHALL BEAR ALL COST INVOLVED IN PROVIDING APPROVED FIRE WATCH AND SHALL UTILIZE CAREFUL PLANNING AND PHASING OF THE PROJECT TO MINIMIZE THIS POSSIBILITY.
- REFER TO ARCHITECTURAL REFLECTED CEILING PLAN FOR EXACT LOCATION OF ALL CEILING MOUNTED DEVICES.
- CONTRACTOR SHALL REFER TO ARCHITECTURAL AND MECHANICAL FLOOR PLANS FOR FLOOR PLAN LAYOUTS. PRIOR TO SUBMISSION OF SHOP DRAWINGS, REVIEW ARCHITECTURAL LAYOUTS, FURNISH HEADS AS REQUIRED BY ARCHITECTURAL SHEETS, BY NFPA 13 2016 EDITION, AND AS SHOWN ON FIRE PROTECTION PLANS FOR A COMPLETE SYSTEM FULLY COVERING WORK AREAS IDENTIFIED ON ARCHITECTURAL DRAWINGS. COORDINATE EXACT HEAD LOCATIONS WITH JOB CONDITIONS, STRUCTURAL, PIPING, CONDUIT, ETC. AS WELL AS FINAL REFLECTED CEILING LAYOUTS. COORDINATE WITH OTHER CONTRACTORS THROUGH GENERAL CONTRACTOR WHERE CONFLICTS ARISE BETWEEN DUCTWORK OR GRAVITY PIPING SYSTEMS. OFFSET SPRINKLER PIPING AS REQUIRED FOR CONFLICT RESOLUTION.
- CONTRACTOR SHALL PERFORM INTERNAL PIPE OBSTRUCTION ASSESSMENT OF EXISTING PIPE AND DROPS TO DETERMINE IF SEDIMENT OR SCALE EXISTS IN PIPE IN ACCORDANCE WITH THE REQUIREMENTS OF NFPA 25. IF SEDIMENT OR SCALE IS FOUND, CONTRACTOR SHALL NOTIFY ARCHITECT/ENGINEER.
- PROVIDE UPRIGHT QUICK RESPONSE HEADS WITH WIRE GUARDS BENEATH ALL EXPOSED DUCTWORK OR OBSTRUCTIONS FOUR (4) FEET OR GREATER IN WIDTH.
- FOR DESIGN PURPOSES, THE SYSTEM DESIGNER SHALL REDUCE THE AVAILABLE FLOW IN GPM BY TEN (10) PERCENT AND THE STATIC AND RESIDUAL PRESSURES BY 5 PSI BELOW THAT OBTAINED DURING FLOW TEST. EXAMPLE, 1,000 GPM FLOW WOULD BE 900 GPM, 52 PSI STATIC IS 47 PSI FOR DESIGN PURPOSES AND 41 PSI RESIDUAL WOULD BE 36 PSI. UTILIZE ADJUSTED PRESSURES FOR HYDRAULIC DESIGN.
- THE NEW PHYSICIAN'S WING ADDITION IS TO BE FULLY SPRINKLED, INCLUDING ANY AREAS WITH CONCEALED COMBUSTIBLE CONSTRUCTION.
- ALL PIPE, FITTINGS, VALVES, ETC. SHALL BE LISTED FOR A MINIMUM OF 175 PSI.
- PROVIDE AUXILIARY DRAINS AS REQUIRED BY NFPA 13 2016 EDITION TO DRAIN TRAPPED SECTIONS OF PIPING. EXTEND DRAINS TO EXTERIOR AND TERMINATE AT GRADE.
- CONTRACTOR SHALL PROVIDE AND INSTALL SPRINKLER HEADS, PIPING, VALVES, HANGERS, ETC. AS REQUIRED FOR COMPLIANCE WITH NFPA 13 2016 EDITION AND REQUIREMENTS OF ALL AUTHORITIES HAVING JURISDICTION.
- PROVIDE FLOW AND TAMPER SWITCHES AS REQUIRED TO ELECTRONICALLY SUPERVISE SYSTEM. WET PIPE SYSTEMS AND ALARM PRESSURE SWITCHES, HIGH/LOW AIR PRESSURE SWITCHES AND TAMPER SWITCHES AS REQUIRED TO ELECTRONICALLY SUPERVISE DRY PIPE AND PREACTION SYSTEMS.
- CONTRACTOR SHALL BE SOLELY RESPONSIBLE FOR PREPARATION OF FIRE PROTECTION SHOP DRAWINGS, CALCULATIONS, AND FEES AS REQUIRED FOR FINAL APPROVAL OF SYSTEM BY ALL AUTHORITIES HAVING JURISDICTION.
- DESIGN AND INSTALLATION OF AUTOMATIC SPRINKLER SYSTEM SHALL BE IN ACCORDANCE WITH REQUIREMENTS OF NFPA 13 2016 EDITION.
- EXCEPT WHERE NOTED, ALL SPRINKLER HEADS SHALL BE LISTED QUICK RESPONSE TYPE.
- PROVIDE ZONE CONTROL VALVE (BUTTERFLY VALVE WITH FLOW AND TAMPER SWITCH) FOR EACH FLOOR.
- CONNECT ALL DRAINS TO COMMON HEADER AND TERMINATE THROUGH WALL 6"(150) ABOVE GRADE.
- WHERE THE PROJECT INVOLVES MODIFICATIONS TO EXISTING SYSTEM HEADS AND PIPING, CONTRACTOR SHALL VISIT THE SITE PRIOR TO BIDDING TO LOOK AT THE EXISTING SYSTEM PIPING. CONTRACTOR SHALL INCLUDE IN HIS PRICE FOR THE PROJECT, ANY MODIFICATIONS TO THE EXISTING SYSTEM PIPING AS REQUIRED TO SUPPLY THE FLOW AND PRESSURE REQUIRED TO PROVIDE AN NFPA 13 CODE COMPLIANT SYSTEM.
- ALL PENDANT AND DRY PENDANT SPRINKLER HEADS IN AREAS WITH CEILINGS SHALL BE CONCEALED HEADS WITH FLAT COVER PLATES.
- CONTRACTOR SHALL NOT USE BEAM CLAMPS TO HANG PIPE FROM METAL PURLINGS. USE SAMMY SUPER SCREW ONLY INSTALLED ON SIDE OF PURLING.
- PROVIDE A MINIMUM OF SIX (6) SPRINKLERS PER SPRINKLER HEAD TYPE AND TEMPERATURE AS REQUIRED BY JOINT COMMISSION LIFE SAFETY STANDARD LS.02.01.35 (EP 7)
- *PROVIDE* SHALL MEAN *FURNISH AND INSTALL* WHERE USED.

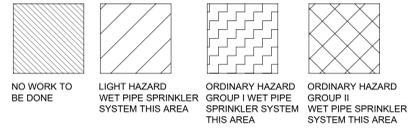

1 FIRE PROTECTION PLAN - PHYSICIAN'S WING
SCALE: 1/8" = 1'-0"

FIRE PROTECTION KEYNOTES:

- PROVIDE SPRINKLER PROTECTION FOR NEW PHYSICIAN'S WING ADDITION. CONNECT TO EXISTING SPRINKLER SYSTEM AT A POINT CAPABLE OF SUPPLYING THE PRESSURE/FLOW RATE NEEDED FOR NEW SPRINKLER EXTENSION. COORDINATE ROUTING OF NEW PIPING WITH ALL EXISTING EQUIPMENT.

NOTE:
BUILDING IS EQUIPPED WITH AN EXISTING SPRINKLER SYSTEM. PRIOR TO BIDDING, CONTRACTOR SHALL FIELD VERIFY EXISTING MAIN LOCATIONS AND INCLUDE IN PRICE ANY PIPING/OFFSETS NEEDED TO ROUTE NEW PIPING TO NEW ADDITION AREAS.

ADG ENGINEERING
ASSOCIATED DESIGN GROUP, INC.
3909 W Congress Street, Suite 201
Lafayette, Louisiana 70506
Phone: (337) 234-5710
Email: adginc@adginc.org
Project No. 24277

ASHE | BROUSSARD | WEINZITTE ARCHITECTS

This drawing and design are the property of Ashe Broussard Weinzittle Architects. They are submitted on the condition that they are not to be used, reproduced, or copied in whole or in part, or used for furnishing information to others, without the prior written consent of Ashe Broussard Weinzittle Architects. All common law rights of copyright and otherwise are hereby specifically reserved.

REVISIONS

revision	description	date
1	Addendum No. One	10.15.25

LASALLE GENERAL HOSPITAL
Workforce Capacity and Medical Access Project
EDA No. 08-79-05595
187 Ninth St. Jena, Louisiana 71342

project no. 2024.01
drawn: SC
checked: CC
project date: JAN 2025
drawing no. FP2.0R1

GENERAL ELECTRICAL NOTES

- ALL WORK SHALL COMPLY WITH LOCAL, STATE, AND FEDERAL CODES TO THE SATISFACTION OF CODE AUTHORITIES HAVING JURISDICTION.
- ALL WORK SHALL COMPLY WITH THE REQUIREMENTS OF NFPA 70 (THE 2020 EDITION OF THE NATIONAL ELECTRICAL CODE), NFPA 101 AND THE AMERICANS WITH DISABILITIES ACT.
- ALL BRANCH CIRCUITING THROUGHOUT HOSPITAL PATIENT CARE SPACES SHALL BE WIRING IN METALLIC CONDUIT WITH EFFECTIVE GROUND-FAULT CURRENT PATH IN COMPLIANCE NEC 517. USE OF MC CABLING IS PROHIBITED.
- COORDINATE ALL CEILING DEVICES WITH LIGHTING, STRUCTURE, ETC. THROUGH GENERAL CONTRACTOR. REFER TO ALL DRAWINGS, (STRUCTURAL, PLUMBING, ELECTRICAL, ARCHITECTURAL, ETC.). NOTIFY ARCHITECT/ENGINEER CONCERNING ANY CONFLICTS NOTED PRIOR TO BIDS FOR CLARIFICATION TO THE SATISFACTION OF THE BIDDER. REFER TO SPECIFICATIONS FOR REQUIREMENTS. REFER TO LATEST ARCHITECTURAL REFLECTED CEILING PLAN. COORDINATE ALL CEILING DEVICE LOCATIONS WITH CEILING GRID.
- CONTRACTOR SHALL REFER TO ARCHITECTURAL DRAWINGS FOR PHASING AND INFECTION CONTROL.
- THE CONTRACTOR SHALL VISIT THE SITE AND THOROUGHLY FAMILIARIZE THEMSELVES WITH THE EXISTING CONDITIONS VERIFYING THAT THE WORK CAN BE PERFORMED AS DESCRIBED IN THESE DEMOLITION DRAWINGS, PRIOR TO SUBMITTING A BID.
- PRIOR TO COMMENCING WORK, THE CONTRACTOR SHALL LOCATE ALL WORK TO REMAIN, INCLUDING, BUT NOT LIMITED TO PLUMBING, HVAC, ELECTRICAL, STRUCTURAL AND ARCHITECTURAL, AND SHALL PROTECT SUCH WORK FROM DAMAGE DURING DEMOLITION AND NEW CONSTRUCTION.
- CONTRACTOR SHALL VERIFY PRIOR TO BID QUANTITIES OF DEVICES INDICATED FOR REUSE WHERE DISCREPANCY EXISTS BETWEEN QUANTITIES SHOWN ON PLANS AND WHAT EXISTS ON SITE, CONTRACTOR SHALL PROVIDE NEW AS PART OF BASE BID.
- REFER TO ARCHITECTURAL DEMOLITION PLANS FOR DEFINITION OF ALL ITEMS TO REMAIN AND BE RE-USED AS WELL AS ITEMS TO BE REMOVED.
- REFER TO ELECTRICAL SPECIFICATIONS FOR ADDITIONAL REQUIREMENTS.
- THE CONTRACTOR SHALL VERIFY ALL DIMENSIONS PRIOR TO COMMENCING CONSTRUCTION. ANY DISCREPANCIES SHALL BE BROUGHT TO THE ATTENTION OF THE ARCHITECT FOR CLARIFICATION. DIMENSIONS AND CONDITIONS TYING INTO OR GOVERNED BY EXISTING CONDITIONS ARE APPROXIMATE AND ARE NOT PURPORTED TO BE CORRECT. ALL SUCH DIMENSIONS AND CONDITIONS SHALL BE FIELD VERIFIED BY THE CONTRACTOR PRIOR TO PERFORMING WORK, PREPARING SHOP DRAWINGS, OR ORDERING MATERIALS.
- THE CONTRACTOR SHALL ASK FOR DETAILS AND/OR INSTRUCTIONS WHEN UNCERTAIN HOW TO PROCEED. THE LACK OF NOT REQUESTING DETAILS DOES NOT EXCUSE SLOPPY OR IMPROPER WORK. CORRECTION SHALL BE THE RESPONSIBILITY OF THE CONTRACTOR AT NO COSTS TO THE OWNER.
- THE CONTRACTOR SHALL BE RESPONSIBLE FOR MOVING ALL SALVAGED ITEMS TO AN OWNER DESIGNATED STORAGE FACILITY.
- REMOVE EXISTING POWER, LIGHTING SYSTEMS, MATERIAL AND EQUIPMENT WHICH ARE MADE OBSOLETE OR WHICH INTERFERE WITH THE CONSTRUCTION OF THE PROJECT. REINSTALL ANY SUCH POWER, LIGHTING, SYSTEMS, MATERIALS AND EQUIPMENT WHICH ARE REQUIRED TO REMAIN ACTIVE FOR THE FACILITY AND ADJACENT FLOORS TO BE FULLY FUNCTIONAL.
- CONTRACTOR SHALL FURNISH AND PROVIDE ALL DEMOLITION REQUIRED TO ACCOMMODATE THIS PROJECT, WHETHER INDICATED ON DRAWINGS, OR DIRECTED IN THE FIELD.
- OWNER SHALL HAVE FIRST RIGHT OF REFUSAL ON ALL REMOVED EQUIPMENT AND DEVICES. CONTRACTOR SHALL COORDINATE WITH OWNER PRIOR TO DISPOSAL.
- CONTRACTOR SHALL PREPARE FIRE ALARM SYSTEM PLAN REVIEW APPLICATION AND SUBMIT REQUIRED DOCUMENTS TO STATE FIRE MARSHAL'S OFFICE USING THE ELECTRONIC SUBMISSION SYSTEM, AND PROVIDE SHARED ACCESS OF THE APPLICATION TO THE INDIVIDUALS BELOW. THE UPLOADING OF STAMPED DOCUMENTS TO FIRE MARSHAL WEBSITE IS UNACCEPTABLE. ADG ENGINEERING MUST RECEIVE A SYSTEM GENERATED PIN CODE VIA EMAIL TO ELECTRONICALLY VERIFY THE ONLINE SUBMITAL.

LOGIN ID	LAST NAME	FIRST NAME	TITLE
A.	DBSTELLY	STELLY	DAVID
B.	MANEELY	NEELY	MARK
C.	(ARCHITECT)		
D.	(OWNER)		
E.	(GENERAL CONTRACTOR)		


ELECTRICAL SITE PLAN NOTES

- PROVIDE CONDUITS FOR NETWORK CONNECTIONS BETWEEN EXISTING "MDF" AND NEW "IDF-3" CLOSETS WITH CABLING AS FOLLOWS:
 - ONE 12-STRAND MULTIMODE FIBER IN 2" C.
 - THREE 2" CONDUITS WITH FULL STRING AS SPARES.
- PROVIDE TELECOMMUNICATION GROUNDING BUSBARS AT NEW NETWORK CLOSET, CONNECTED WITH #2 BARE COPPER WIRE IN 1/2" PVC CONDUIT BACK TO SERVICE ENTRANCE GROUND. BUSBARS SHALL BE 1/4" THICK COPPER, 1 1/2" WIDE, 24" LONG WITH PRE-DRILLED NEMA BOLT HOLES.

SYMBOL SCHEDULE

F2	RECESSED LED FIXTURE, TYPE F2
□	SURFACE MOUNTED LED FIXTURE
○	LED LIGHT FIXTURE
⊖	EXIT FIXTURE
⊖	EMERGENCY LIGHT FIXTURE
⊖S	SINGLE POLE SWITCH
⊖OS	OCCUPANCY SENSOR - WALL MOUNTED
⊖SB	MULTIFUNCTION BED LIGHT SWITCH
⊖SD	SINGLE POLE DIMMER SWITCH
⊖SP	SINGLE POLE SWITCH WITH PILOT LIGHT
⊖	DUPLEX RECEPTACLE 20A, 125V 2P, 3W GROUNDED
⊖	EXISTING DUPLEX RECEPTACLE TO REMAIN UNLESS OTHERWISE NOTED.
⊖	DOUBLE DUPLEX RECEPTACLE AS ABOVE
⊖	DOUBLE DUPLEX RECEPTACLE AS ABOVE WITH INTEGRAL SURGE PROTECTION
⊖	DUPLEX RECEPTACLE AS ABOVE EXCEPT GFI TYPE
⊖	OUTLET WITH TWO COMPUTER JACKS - PROVIDE 4" JUNCTION BOX WITH ONE 3/4" C TO ACCESSIBLE CEILING. CABLING AND JACKS FURNISHED AND INSTALLED BY OWNER'S VENDOR.
⊖	WIRELESS ACCESS POINT IN CEILING PROVIDED BY OWNER'S VENDOR. CABLING AND JACKS FURNISHED AND INSTALLED BY OWNER'S VENDOR.
⊖	VIDEO SURVEILLANCE CAMERA AND CABLING PROVIDED AND INSTALLED BY OWNER'S VENDOR. PROVIDE 4" JUNCTION BOX WITH ONE 3/4" C TO ACCESSIBLE CEILING.
⊖	ACCESS CONTROL SYSTEM PROXIMITY CARD READER AND CABLING PROVIDED AND INSTALLED BY OWNER'S VENDOR. PROVIDE JUNCTION BOX AT 48" A.F.F. WITH 3/4" C UP TO ABOVE CEILING.
⊖	RECESSED PAGING SPEAKER AND CABLING PROVIDED AND INSTALLED BY OWNER'S VENDOR.
⊖	EXISTING NURSE CALL BATH STATION WITH PULL CORD AT 36" AFF. TO REMAIN OR BE RELOCATED
⊖	NEW NURSE CALL BATH STATION WITH PULL CORD AT 36" AFF.
⊖	EXISTING NURSE CALL STAFF STATION AT 54" AFF. TO REMAIN OR BE RELOCATED
⊖	NEW NURSE CALL STAFF STATION AT 54" AFF.
⊖	EXISTING NURSE CALL CORRIDOR DOME LIGHT TO REMAIN OR BE RELOCATED
⊖	NEW NURSE CALL CORRIDOR DOME LIGHT
⊖	EXISTING NURSE CALL MASTER STATION TO REMAIN
⊖	FIRE ALARM AUDIO VISUAL SIGNAL WITH BOTTOM OF DEVICE MOUNTED AT 80"
⊖	FIRE ALARM STROBE (VISUAL SIGNAL) WITH BOTTOM OF DEVICE MOUNTED AT 80"
⊖	FIRE ALARM CEILING MOUNTED SINGLE STATION SMOKE SENSOR WITH SOUNDER BASE
⊖	EXISTING 277/480V SURFACE MOUNTED PANELBOARD
⊖	EXISTING 120/208V SURFACE MOUNTED PANELBOARD
⊖	EXISTING 120/208V FLUSH MOUNTED PANELBOARD
⊖	EXISTING 277/480V FLUSH MOUNTED PANELBOARD
→	HOMERUN TO PANEL
---	CONDUIT CONCEALED ABOVE CEILING OR IN WALLS. CROSS BARS DENOTE QUANTITY OF #12 CONDUCTORS EXCLUDING GROUND WHEN OVER TWO.
-LV-	LOW VOLTAGE WIRING
---	CONDUIT UNDER SLAB OR BELOW GRADE
---	CONDUIT EXPOSED

NOTE: DEVICES WITH AN "E" DESIGNATION SHALL BE CONNECTED TO EMERGENCY POWER. RECEPTACLES CONNECTED TO EMERGENCY POWER SHALL BE RED IN COLOR.

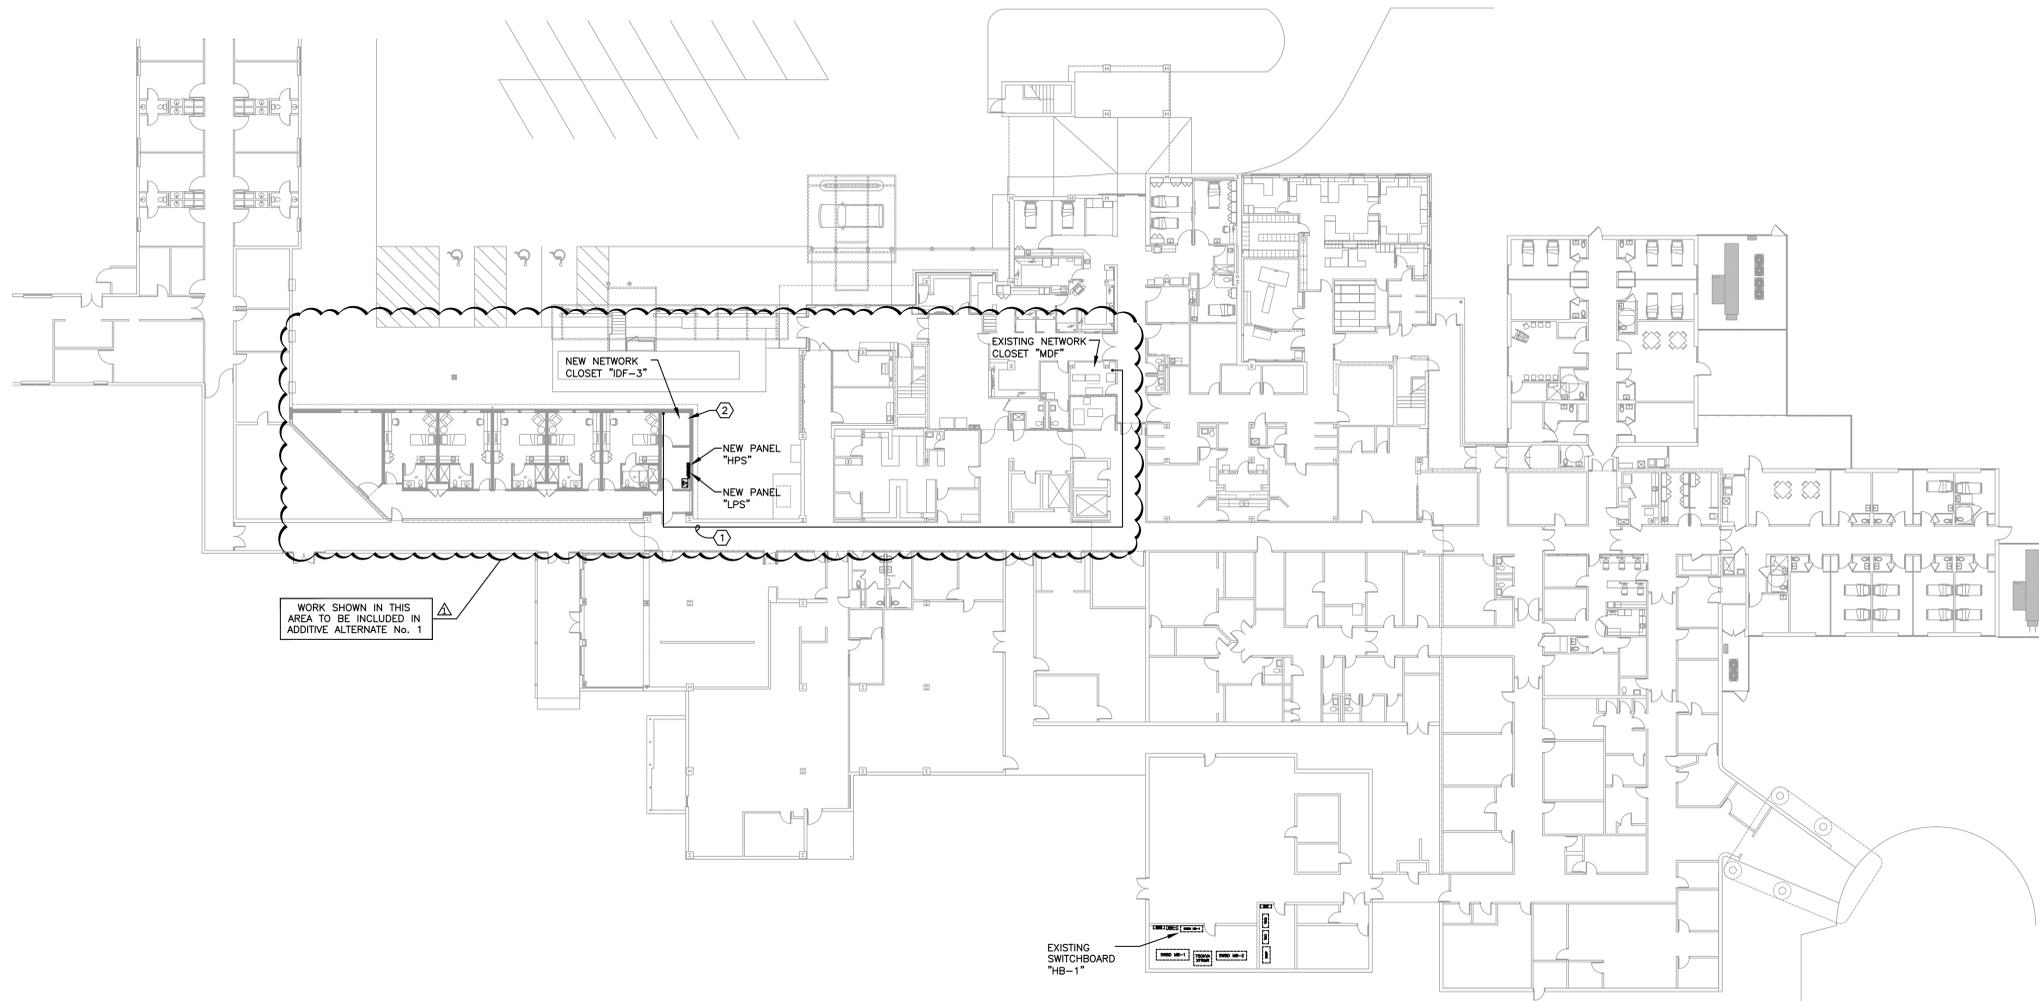

REVISIONS

revision	description	date
1	Addendum No. One	10.15.25

LASALLE GENERAL HOSPITAL

Workforce Capacity and Medical Access Project
EDA No. 08-79-05595
187 Ninth St. Jena, Louisiana 71342

sheet contents
ELECTRICAL SITE PLAN


project no.
2024.01
drawn
MAN
checked
DBS
project date
JAN 2025
drawing no.
E1.1R1

LIGHTING PLAN NOTES

- ① CONNECT TO LIFE SAFETY LIGHTING CIRCUIT SERVING NEARBY LIGHT FIXTURES.

LIGHT FIXTURE SCHEDULE

- F1** LITHONIA #LDN6 35/20 L06AR LSS MVOLT G210 TRW, OR EQUAL, 6" DIA. RECESSED LED DOWNLIGHT WITH CLEAR SEMI-SPECULAR REFLECTOR, MATTE WHITE TRIM, MEDIUM DISTRIBUTION, 23 WATT, 2000 LUMEN, 3500K LED MODULE, AND UNIVERSAL VOLTAGE DRIVER.
- F2** AXIS BALANCED CARE #BCASY2 4 80 35 RD30 AMW 277 0(8) LVCB6 TB15 BCWSS, OR EQUAL, PAIR OF SEPARATE RIGHT AND LEFT 4" RECESSED ASYMMETRIC MULTI-FUNCTION MEDICAL BED LIGHT FIXTURES, EACH WITH ANTIMICROBIAL WHITE FINISHED EXTRUDED ALUMINUM HOUSING, DRYWALL MOUNTING FLANGE, LENTICULAR ACRYLIC LENS, LOW-VOLTAGE CONTROLLER AND INTERFACE FOR WALL, BED, AND NURSE CALL PULLDOWN SPEAKER CONTROLS, INDEPENDENTLY CONTROLLABLE AMBIENT (SMOOTH DIMMING), READING (SMOOTH DIMMING), AND EXAM (NONDIMMING) LIGHTING FUNCTIONS, 264 WATT TOTAL INPUT, AND UNIVERSAL VOLTAGE DRIVERS. COORDINATE SELECTION OF WALL CONTROLS WITH SUPPLIER. MOUNT WITH END OF FIXTURE PAIR AT 24" FROM HEADWALL, SPACED 54" ON CENTER, WITHIN TILED CEILING. VERIFY EXACT PLACEMENT WITH ENGINEER PRIOR TO ROUGHIN. PROVIDE WITH #BCWSS THREE-FUNCTION WALL CONTROL SWITCH.
- F3** WILLIAMS #WMAUD 2 L20835U L20835D AF DIMU DIMD UNV, OR EQUAL, 24" SURFACE WALL MOUNTED LED VANITY FIXTURE WITH WHITE FINISHED STEEL HOUSING, FROSTED ACRYLIC LENS, UP/DOWN DISTRIBUTION, 33 WATT, 3868 LUMEN, 3500K LED MODULE, AND UNIVERSAL VOLTAGE DRIVER. MOUNT 4" TO CENTER FROM TOP OF MIRROR.
- F4** KENALL #MCSL-HR-2L30K-MW-DV, OR EQUAL, SEMI-RECESSED LED NIGHT LIGHT WITH HORIZONTAL, CAST ALUMINUM HOUSING, ANTIMICROBIAL WHITE FINISH, 2 WATT, 124 LUMEN, 3000K LED MODULE, AND UNIVERSAL VOLTAGE DRIVER. MOUNT AT 14" A.F.F. TO CENTER OF FIXTURE. CONNECT TO PATIENT ROOM LIGHT SWITCH WITH PILOT LIGHT.
- F5** LITHONIA #CPK 2X2 2000LM 80CRI 35K SWL MN10 ZT MVOLT, OR EQUAL, 2" RECESSED LED FIXTURE WITH WHITE HOUSING, LOW GLARE WHITE LENS, 16 WATT, 2100 LUMEN, 3500K OUTPUT, AND UNIVERSAL VOLTAGE DRIVER.
- F6** LITHONIA #LE-S-1-R, OR EQUAL, SINGLE FACE UNIVERSAL MOUNTED LED EXIT SIGN WITH DIE-CAST, BRUSHED ALUMINUM FINISH HOUSING, RED LETTERS, AND 120/277 VOLT OPERATION.
- F7** LITHONIA #LE-S-2-R, OR EQUAL, SAME AS F6 EXCEPT DOUBLE FACE.
- F8** LITHONIA #LDN6 27/15 L06AR LSS MVOLT G210 TRW, OR EQUAL, 6" DIA. RECESSED LED DOWNLIGHT WITH CLEAR SEMI-SPECULAR REFLECTOR, MATTE WHITE TRIM, MEDIUM DISTRIBUTION, 18 WATT, 1500 LUMEN, 2700K LED MODULE, AND UNIVERSAL VOLTAGE DRIVER.

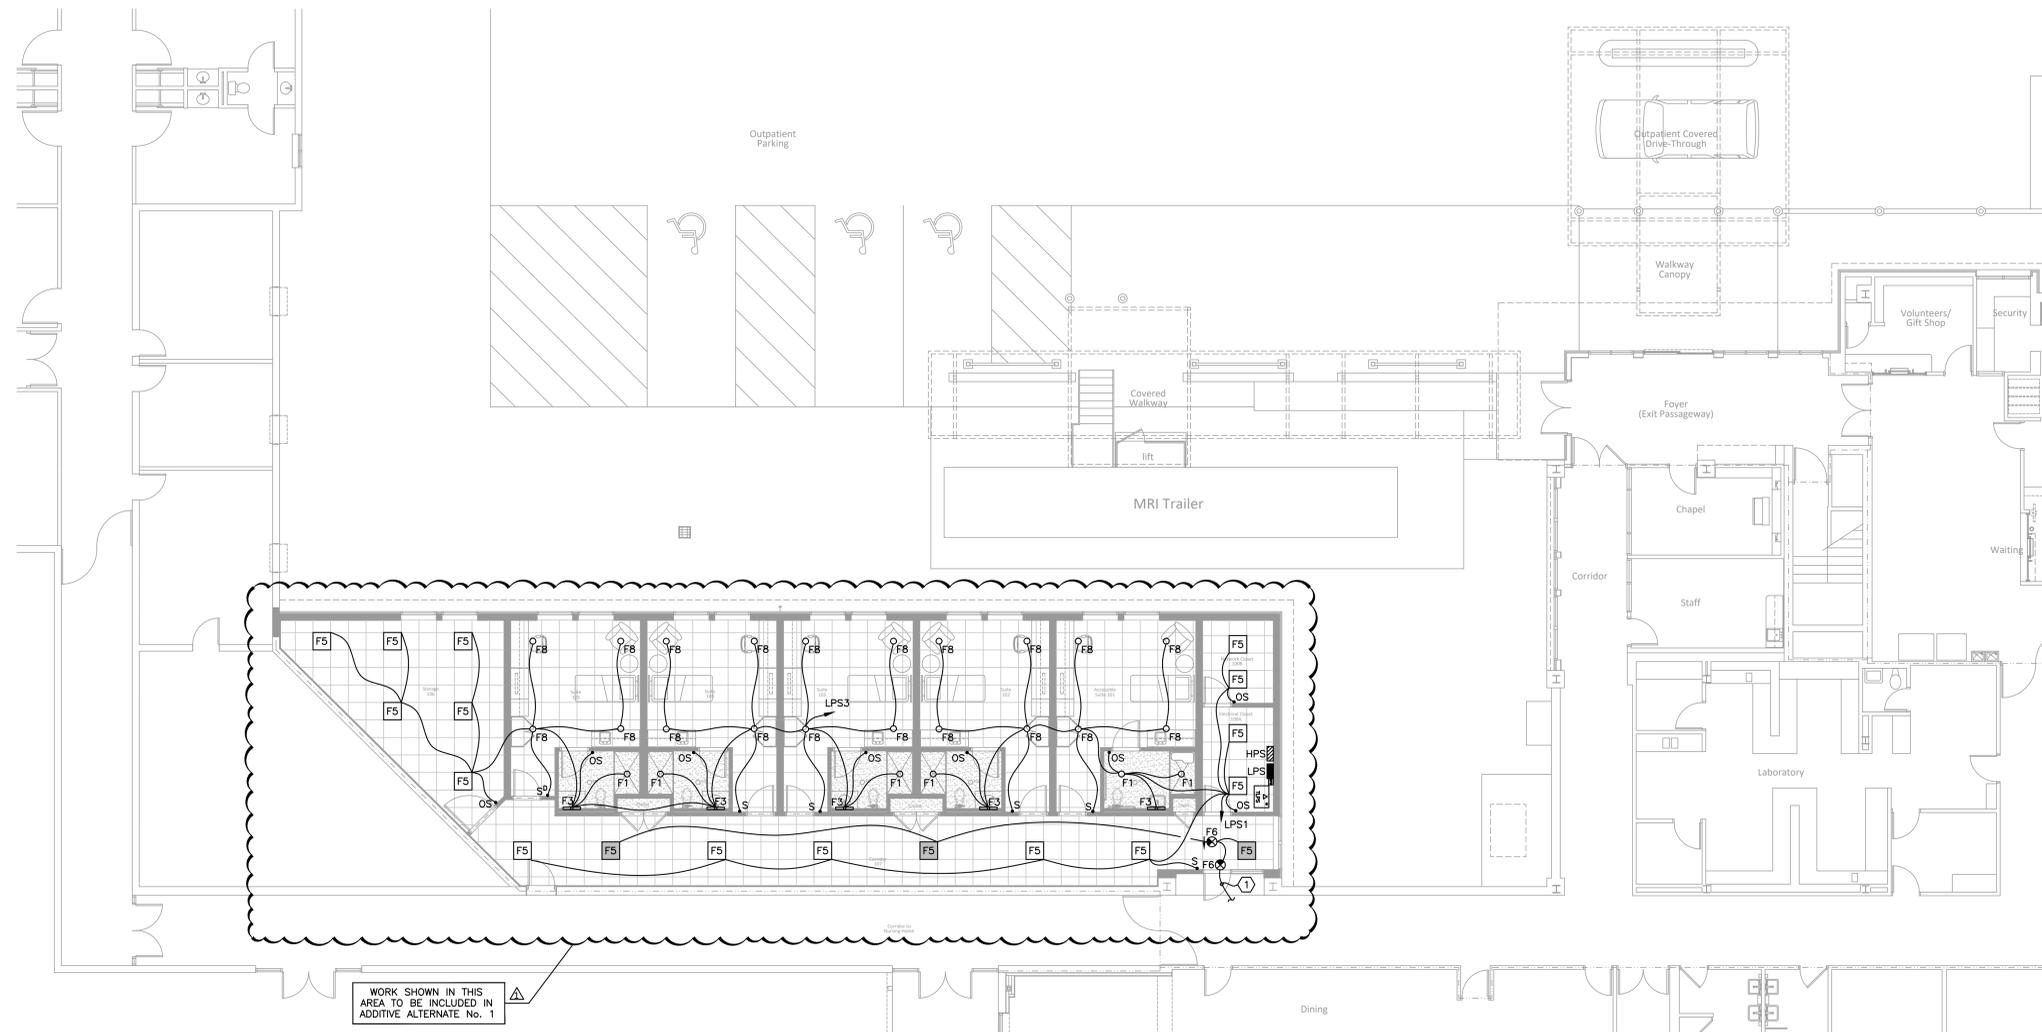

ASHE | BROUSSARD | WEINZITTE ARCHITECTS

This drawing and design are the property of Ashe Broussard Weinzitte Architects. They are submitted on the condition that they are not to be used, reproduced, or copied in whole or in part, or used for furnishing information to others, without the prior written consent of Ashe Broussard Weinzitte Architects. All common law rights of copyright and otherwise are hereby specifically reserved.



REVISIONS

revision	description	date
1	Addendum No. One	10.15.25

LASALLE GENERAL HOSPITAL Workforce Capacity and Medical Access Project EDA No. 08-79-25595 187 Ninth St. Jena, Louisiana 71342	project no. 2024.01
	drawn MAN
sheet contents FIRST FLOOR LIGHTING PLAN PHYSICIAN'S WING	checked DBS
	project date JAN 2025
	drawing no. E2.1R1



ASSOCIATED DESIGN GROUP, INC.
301 Jackson Street, Suite 204
Alexandria, Louisiana 71301
Phone: (318) 445-8870
Email: adginc@adginc.org

Project No. 24277




1 FIRST FLOOR LIGHTING PLAN - PHYSICIAN'S WING

SCALE: 1/8" = 1'-0"

POWER PLAN NOTES

- ① 2#10 & 1#10 GRND IN 3/4" C.
- ② 3#10 & 1#10 GRND IN 3/4" C.

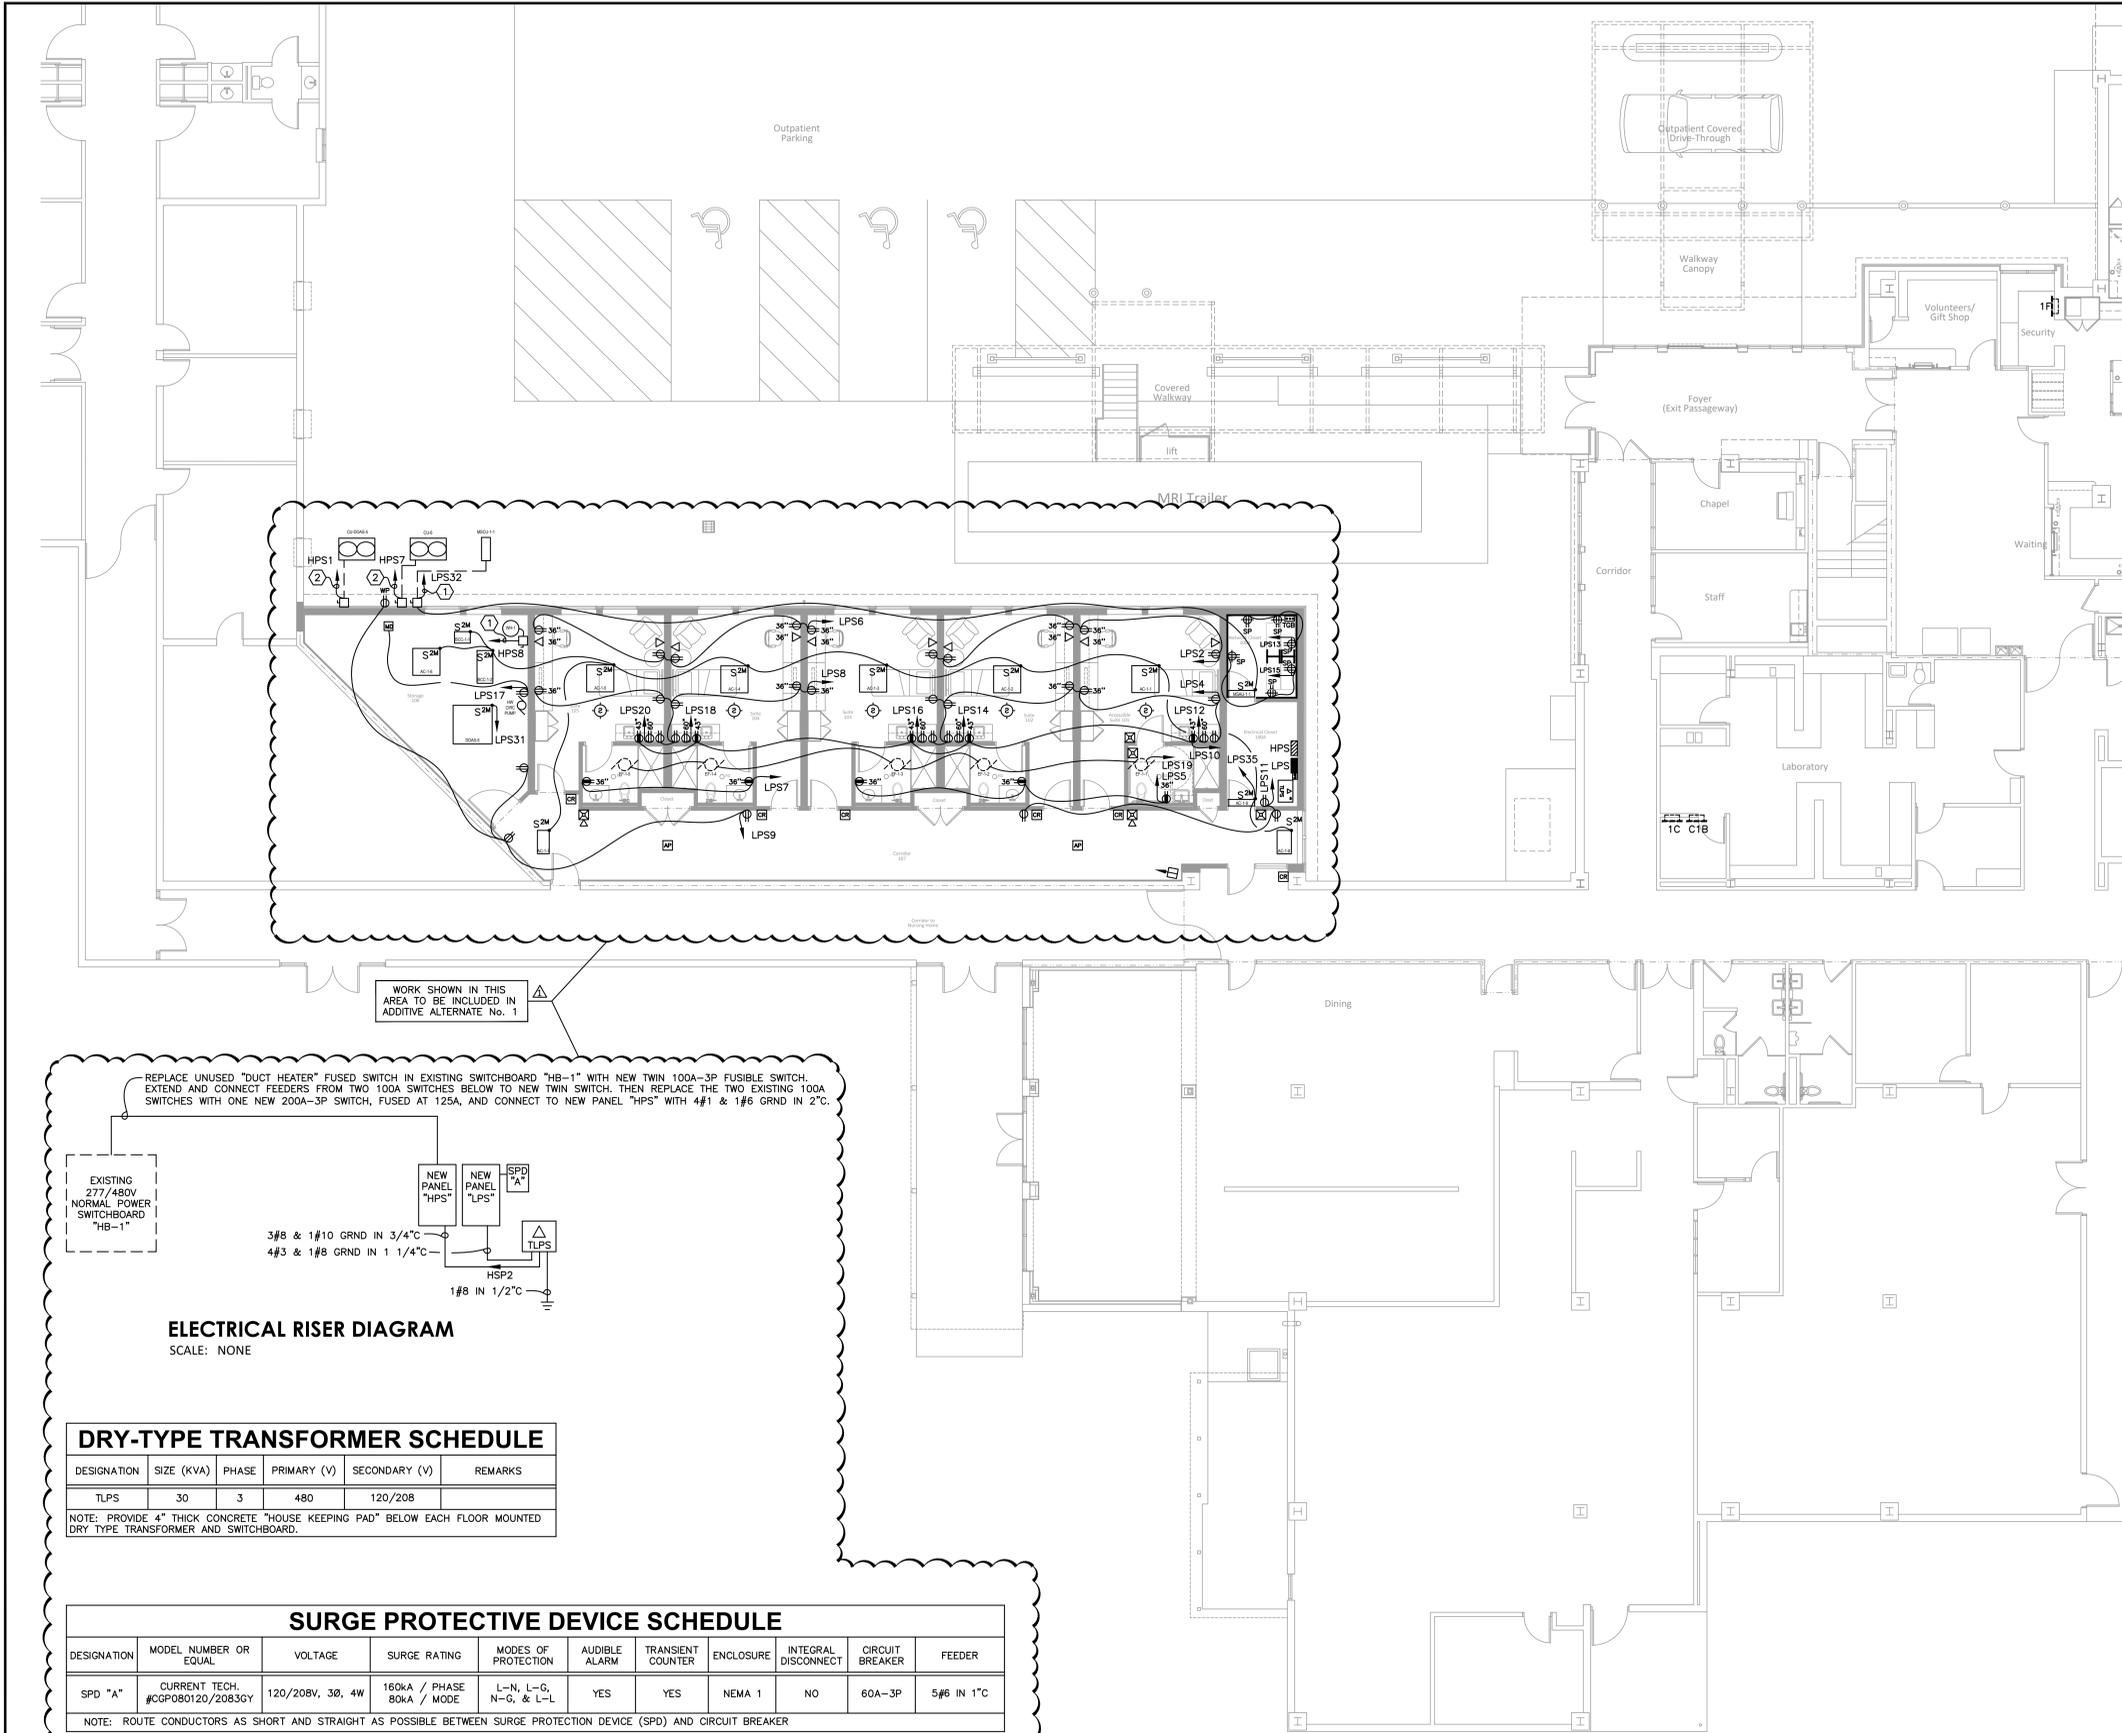

PANEL HPS

SURFACE MOUNTED 125A MLO PANEL FOR 277/480V 3Ø 4W SERVICE INTERRUPTING RATING: 14,000 AMPS

CKT NO.	TRIP NO.	NO. POLES	LOAD SERVED	PHASE LOAD VA			LOAD SERVED	TRIP AMPS	NO. POLES	CKT NO.
				A	B	C				
1	40	3	CU-DOAS-5	6400			PANEL LPS (XFRMR)	50	3	2
3	-	-	-	6400			-	-	-	4
5	-	-	-		6400		-	-	-	6
7	40	3	CU-6	6700			WATER HEATER	30	3	8
9	-	-	-	5000	6700	5000	-	-	-	10
11	-	-	-		6700	5000	-	-	-	12
13	-	-	SPACE ONLY				SPACE ONLY	-	-	14
15	-	-	SPACE ONLY				SPACE ONLY	-	-	16
17	-	-	SPACE ONLY				SPACE ONLY	-	-	18
19	-	-	SPACE ONLY				SPACE ONLY	-	-	20
21	-	-	SPACE ONLY				SPACE ONLY	-	-	22
23	-	-	SPACE ONLY				SPACE ONLY	-	-	24


PANEL LPS

SURFACE MOUNTED 100A MCB PANEL FOR 120/208V 3Ø 4W SERVICE INTERRUPTING RATING: 10,000 AMPS

CKT NO.	TRIP NO.	NO. POLES	LOAD SERVED	PHASE LOAD VA			LOAD SERVED	TRIP AMPS	NO. POLES	CKT NO.
				A	B	C				
1	20	1	PHYS STE LIGHTING	1000			PHYS STE RECP	20	1	2
3	20	1	PHYS STE LIGHTING	1000			PHYS STE RECP	20	1	4
5	20	1	PHYS BATH RECP		1000	1000	PHYS STE RECP	20	1	6
7	20	1	PHYS BATH RECP	1000			PHYS STE RECP	20	1	8
9	20	1	CORRIDOR/STOR RECP	1000	1000		PHYS STE RECP	20	1	10
11	20	1	CORRIDOR/STOR RECP		1000	1000	PHYS STE MW RECP	20	1	12
13	20	1	TELCOM RECP	1000			PHYS STE MW RECP	20	1	14
15	20	1	TELCOM RECP		1000	1000	PHYS STE MW RECP	20	1	16
17	20	1	HW CIRC PUMP			1000	PHYS STE MW RECP	20	1	18
19	20	1	EXHAUST FANS	200			PHYS STE MW RECP	20	1	20
21	20	1	SPARE				SPARE	20	1	22
23	20	1	SPARE				SPARE	20	1	24
25	20	1	SPARE				SPARE	20	1	26
27	20	1	SPARE				SPARE	20	1	28
29	20	1	SPARE				SPARE	20	1	30
31	20	2	DOAS-5 INDOOR UNIT	500	500	1800	MSCU-1-1	30	2	32
33	-	-	-				-	-	-	34
35	20	2	AC-6 INDOOR UNITS	500			SPACE ONLY	-	-	36
37	-	-	-	500			SPD "A"	60	3	38
39	-	-	SPACE ONLY				-	-	-	40
41	-	-	SPACE ONLY				-	-	-	42

WORK SHOWN IN THIS AREA TO BE INCLUDED IN ADDITIVE ALTERNATE No. 1

REPLACE UNUSED "DUCT HEATER" FUSED SWITCH IN EXISTING SWITCHBOARD "HB-1" WITH NEW TWIN 100A-3P FUSIBLE SWITCH. EXTEND AND CONNECT FEEDERS FROM TWO 100A SWITCHES BELOW TO NEW TWIN SWITCH. THEN REPLACE THE TWO EXISTING 100A SWITCHES WITH ONE NEW 200A-3P SWITCH, FUSED AT 125A, AND CONNECT TO NEW PANEL "HPS" WITH 4#1 & 1#6 GRND IN 2" C.

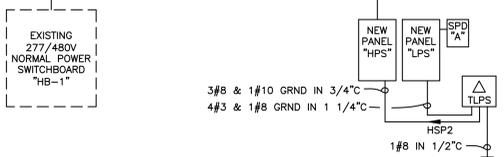

ELECTRICAL RISER DIAGRAM
SCALE: NONE

DRY-TYPE TRANSFORMER SCHEDULE

DESIGNATION	SIZE (KVA)	PHASE	PRIMARY (V)	SECONDARY (V)	REMARKS
TLPS	30	3	480	120/208	

NOTE: PROVIDE 4" THICK CONCRETE "HOUSE KEEPING PAD" BELOW EACH FLOOR MOUNTED DRY TYPE TRANSFORMER AND SWITCHBOARD.

SURGE PROTECTIVE DEVICE SCHEDULE

DESIGNATION	MODEL NUMBER OR EQUAL	VOLTAGE	SURGE RATING	MODES OF PROTECTION	AUDIBLE ALARM	TRANSIENT COUNTER	ENCLOSURE	INTEGRAL DISCONNECT	CIRCUIT BREAKER	FEEDER
SPD "A"	CURRENT TECH. #CGP080120/2083GY	120/208V, 3Ø, 4W	160kA / PHASE 80kA / MODE	L-N, L-G, N-G, & L-L	YES	YES	NEMA 1	NO	60A-3P	5#6 IN 1" C

NOTE: ROUTE CONDUCTORS AS SHORT AND STRAIGHT AS POSSIBLE BETWEEN SURGE PROTECTION DEVICE (SPD) AND CIRCUIT BREAKER

ASHE | BROUSSARD | WEINZETTEL ARCHITECTS

This drawing and design are the property of Ashe Broussard Weinzettel Architects. They are submitted on the condition that they are not to be used, reproduced, or copied in whole or in part, or used for furnishing information to others, without the prior written consent of Ashe Broussard Weinzettel Architects. All common law rights of copyright and otherwise are hereby specifically reserved.

DAVID B. STIELY
License No. 26070
10/15/2025
PROFESSIONAL ENGINEER

REVISIONS		
revision	description	date
1	Addendum No. One	10.15.25

LASALLE GENERAL HOSPITAL
Workforce Capacity and Medical Access Project
EDA No. 08-79-25595
187 Ninth St. Jena, Louisiana 71342

project no. 2024.01
drawn by MAN
checked by DBS
project date JAN 2025
sheet contents
FIRST FLOOR POWER PLAN PHYSICIAN'S WING
drawing no. E3.1R1